


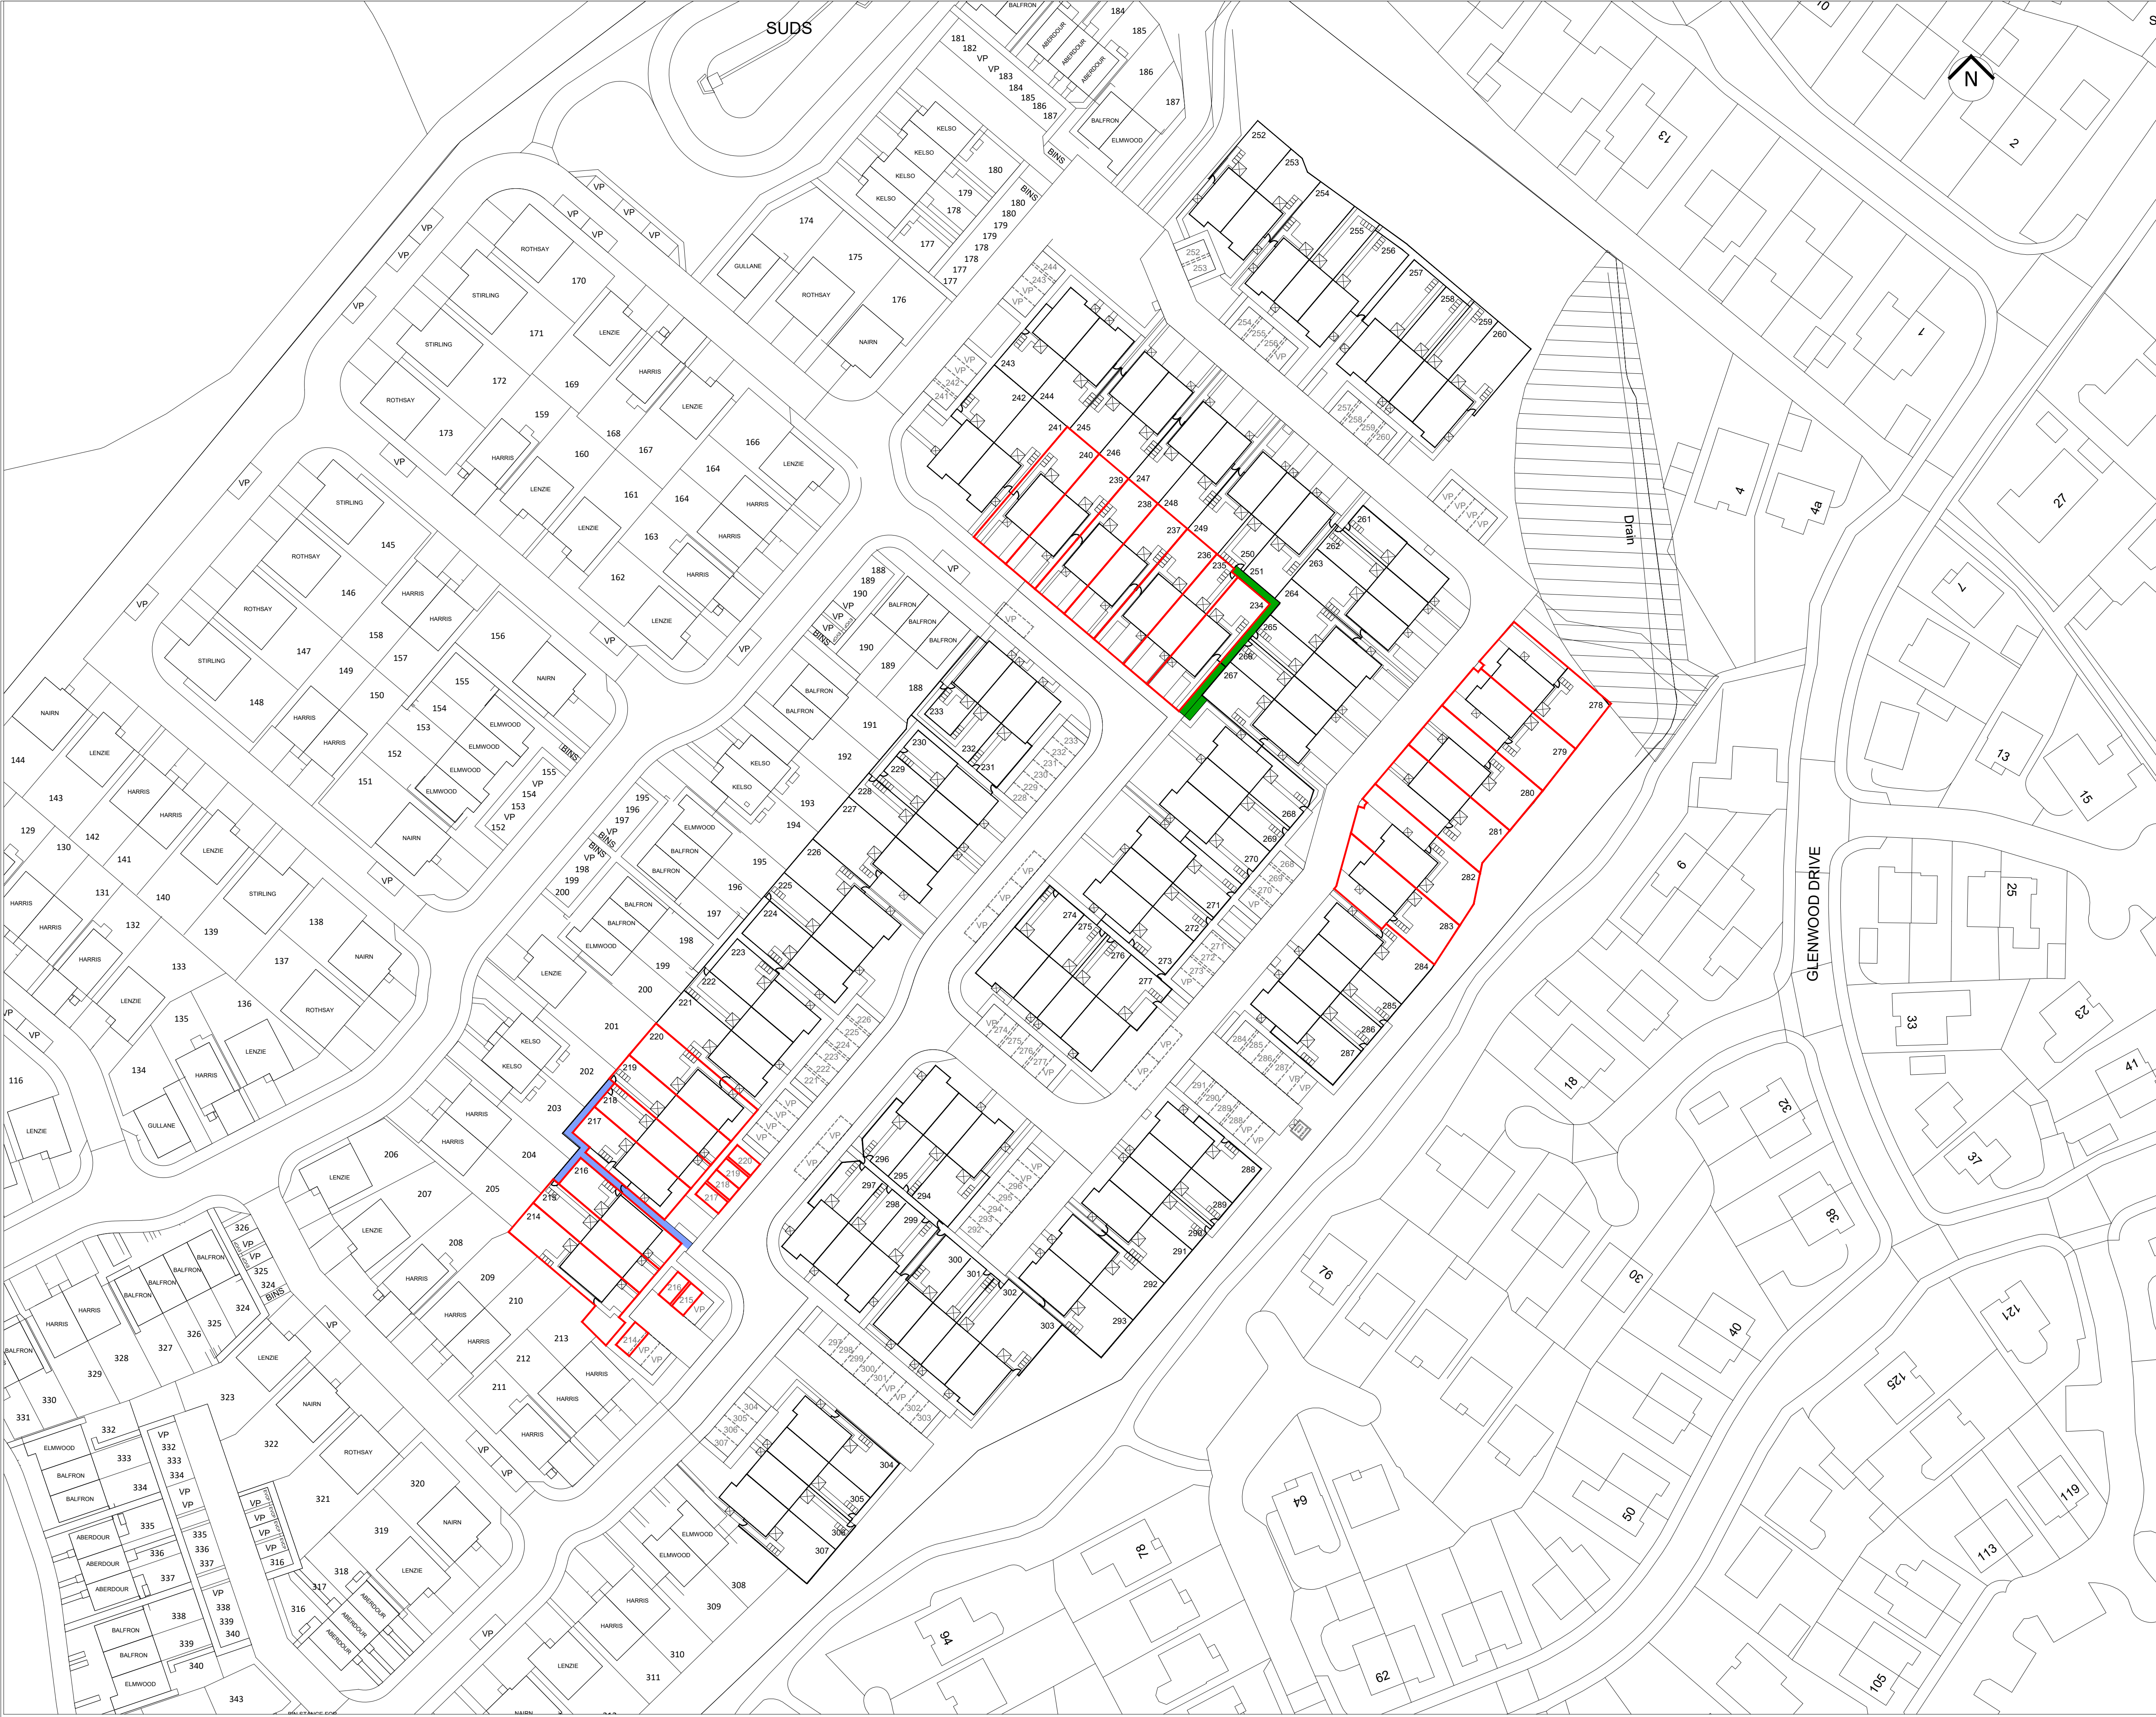

LEGEND

DENOTES PLOT BOUNDARY EXTENTS.

SHARED ACCESS PATH TO PLOTS
215, 216, 217, 218 & 219.

SHARED ACCESS PATH TO PLOTS
235, 250, 265 & 266

The Development registered under Title WLN63917 and plots 214, 234 to 240 and 278 to 283 within have been DPA approved.

The Keeper – 25 August 2026

Keeper for the Registers of Scotland

F	Amended area of handstanding for lighting column and plot boundary for plot 282 to suit as built	21/08/2026	CM
E	Amended boundary of plots 278, 279, and 282 to exclude adoptable handstanding for street lighting	21/07/2026	CM
D	Included bin collection point within shared access for plots 235, 250, 265, 266	30/03/2026	CM
C	Amended to suit latest site layout	11/03/2026	CM
B	Development layout updated and access paths revised.	24/04/2025	BMG
A	Drawing title amended and layout updated in line with clients comments.	11/02/2025	BMG
No.	REVISION	DATE	BY

ASHOMES
SCOTLAND

205 St Vincent Street
Glasgow
G2 5QD
tel : 0141 229 1646
fax : 0141 248 1636
www.ashscot.co.uk

Client

Places for People

Project

Standhill, Armadale

Drawing Title

DPA Plan
(SHARED EQUITY PLOTS)

Scale

1:500

Size

A1

Drawn By

BMG

Date

Nov'24

Drawing No.

DEED002

Project No.

HS046

Status

F

Revision

F

© Copyright AS Homes Scotland Ltd