


The Development registered under Title GLA144751 and Flats 1 to 4

(inclusive) within have been DPA approved by:




*1 MacLaren - 20th July 2017*

Iain MacLaren (DPA Officer)

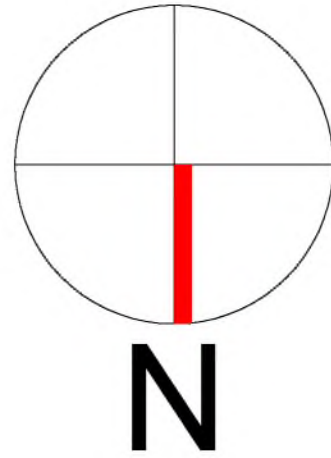

- FLAT 1
- FLAT 2
- FLAT 3
- FLAT 4
- COMMON STORE
- BICYCLE STORE
- SPRINKLER TANK
- REFUSE
- COMMUNAL PATHWAY

NEWTON TERRACE LANE

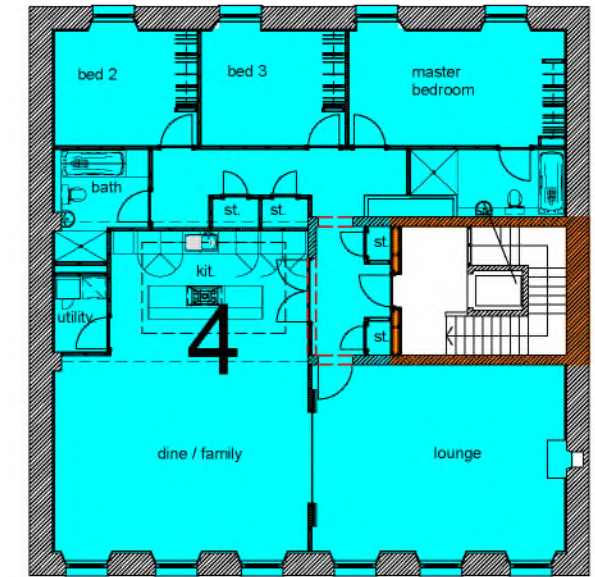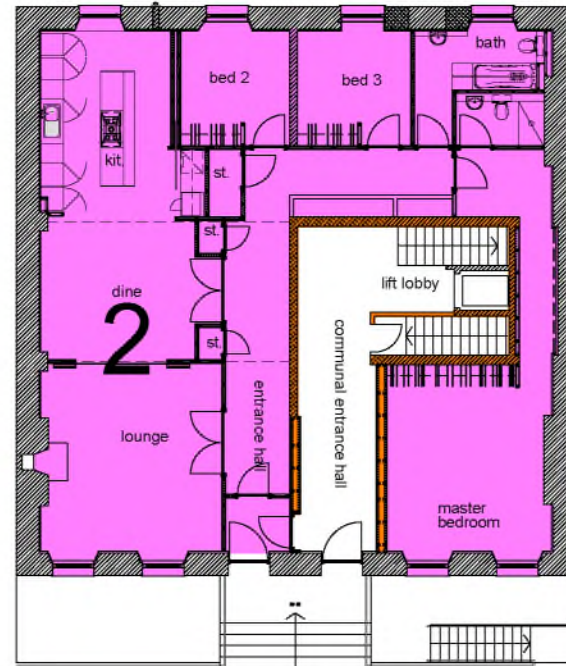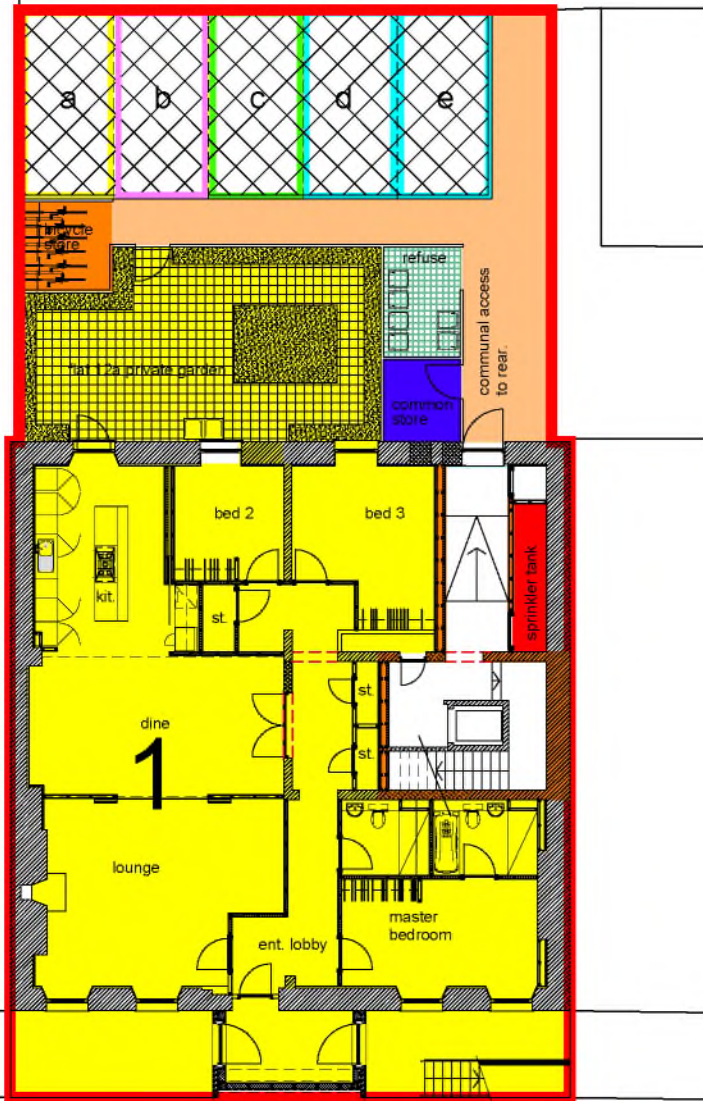

NEWTON TERRACE

**BASEMENT (12a)**

3 bed lower ground main door apartment  
direct access to rear  
double aspect  
153 sq.m. (1646 sq.ft.)

**GROUND FLOOR (11)**

3 bed main door apartment  
direct stair access to rear  
double aspect  
149 sq.m. (1603 sq.ft.)

**FIRST FLOOR (12/1)**

3 bed apartment  
direct stair access to rear  
double aspect  
168 sq.m. (1808 sq.ft.)

**SECOND FLOOR (12/2)**

3 bed apartment  
direct stair access to rear  
double aspect  
168 sq.m. (1808 sq.ft.)

AS BUILT

CLIENT  
**CALEDON NEWTON LIMITED**

PROJECT  
**11 - 12 NEWTON TERRACE**

DRAWING TITLE  
**TITLE DEED PLANS**

DRAWN BY: **AC**      CHECKED BY:      DATE: **230517**

SCALE  
**1 : 200**

DRAWING NO. **s/A55/BW/plans110716**  
**A55 / TITLE DEED**

38/40 NEW CITY ROAD  
GLASGOW G4 9JT

TEL. 0141-332-0999  
FAX. 0141-332-4432  
E-M. info@cmarchitects.co.uk

