



Site Layout Showing Plot 3 and Footprint of Flatted Block

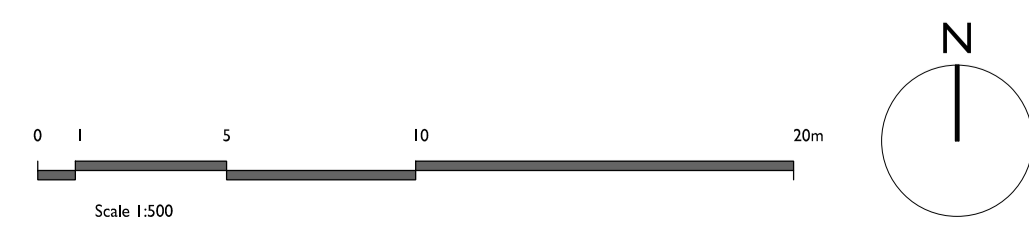

Site Layout Showing Building Outlines

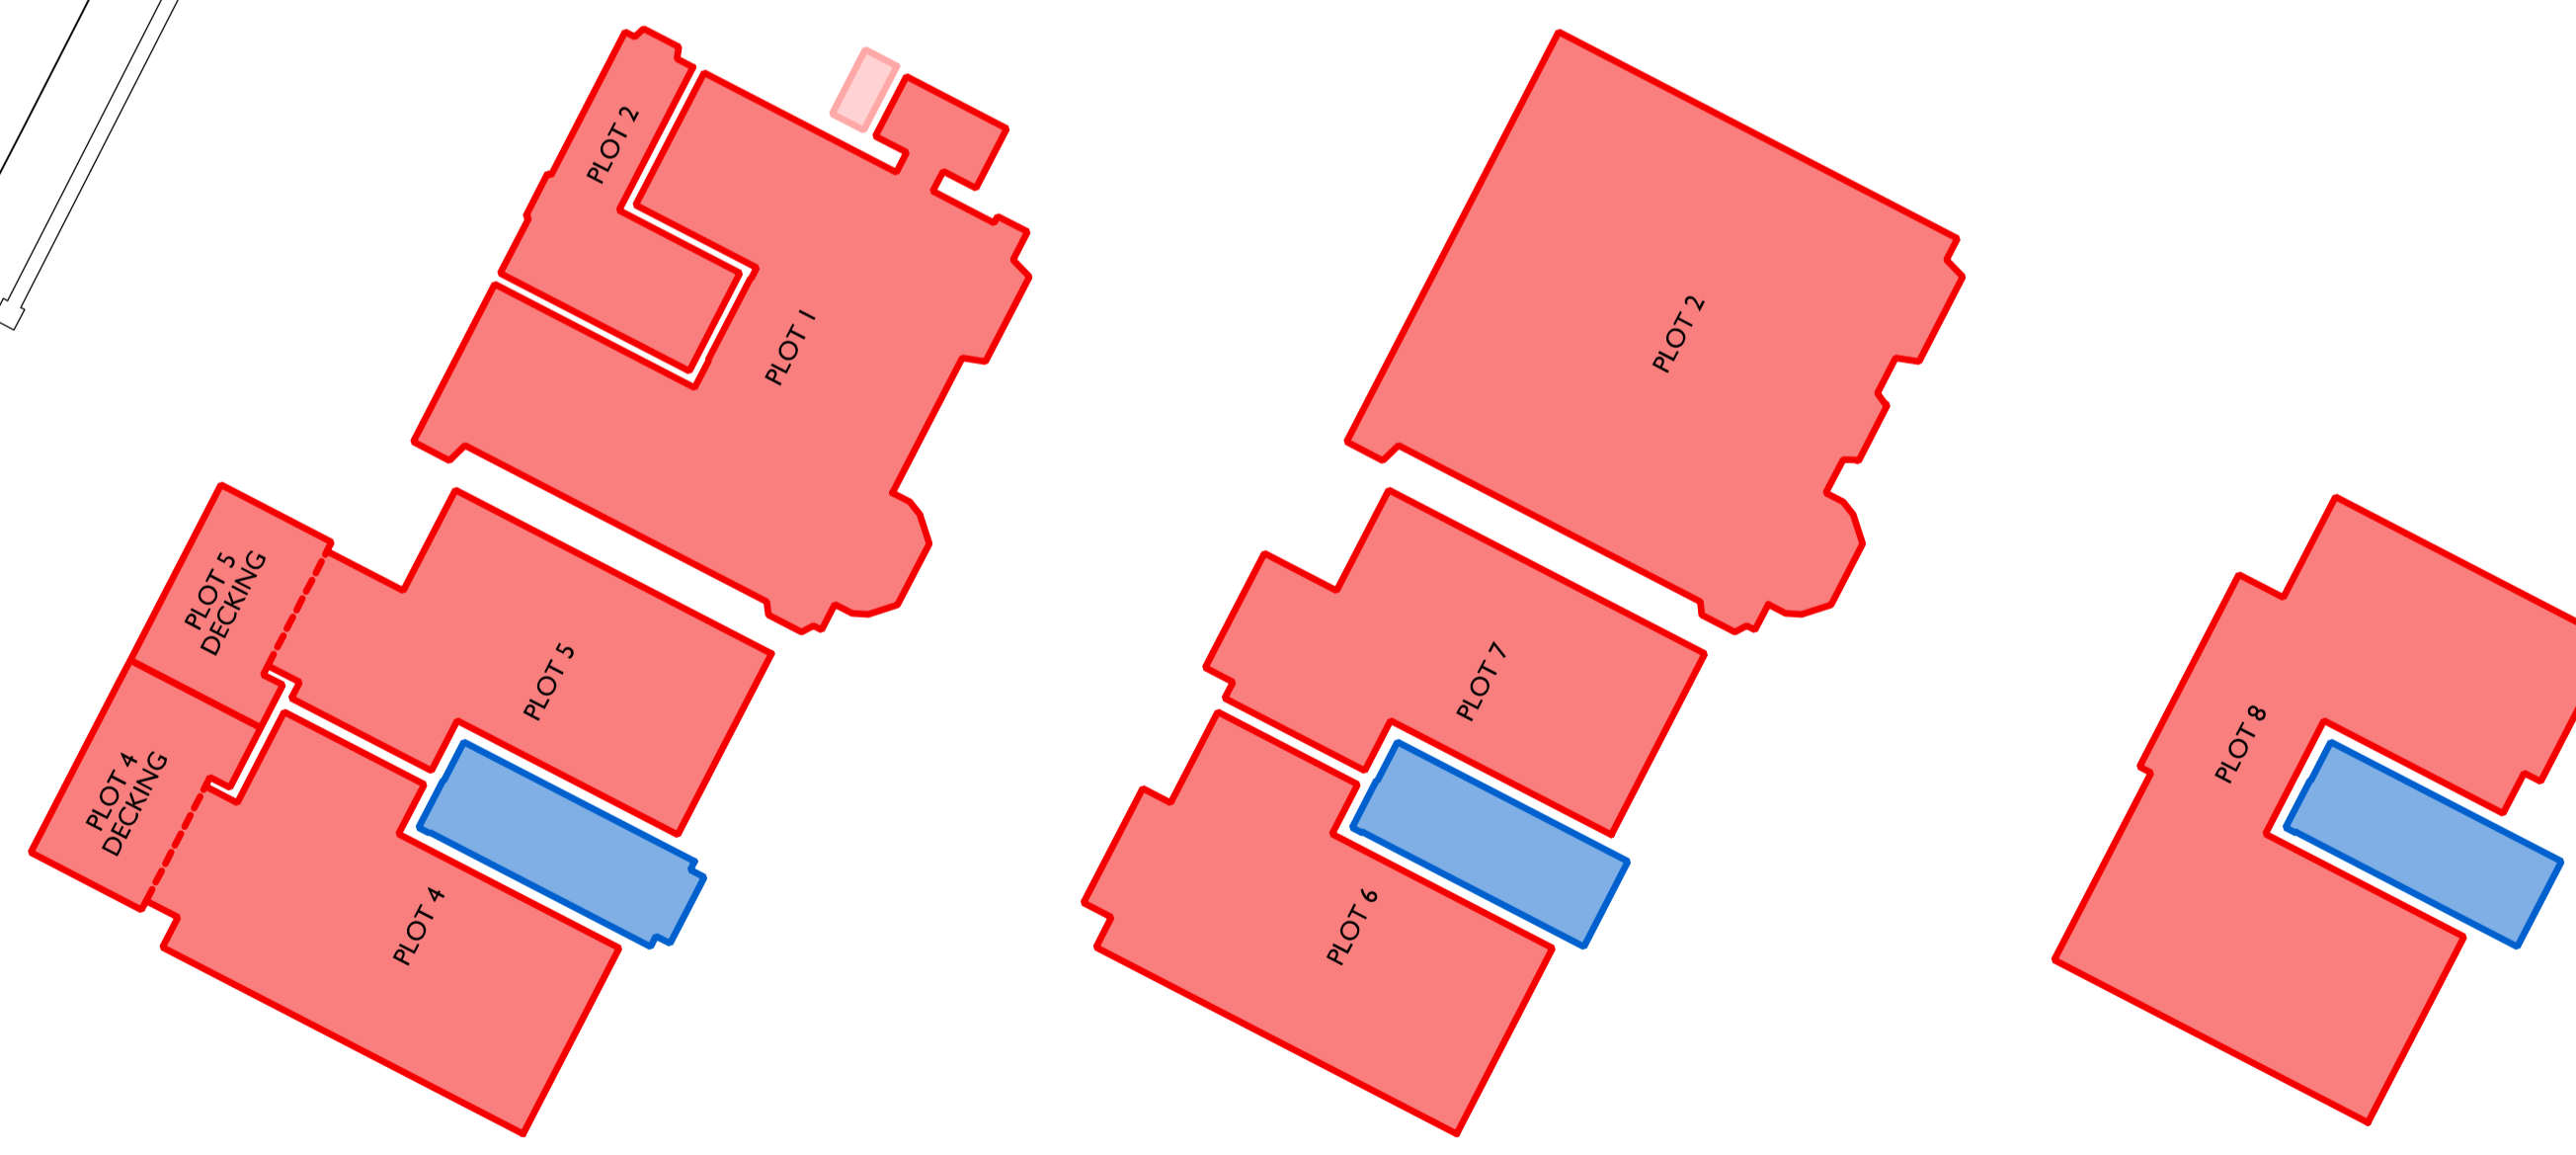

Ground Floor Flats

First Floor Flats

Second Floor Flats

- Site Boundary
- Footprint of Flatted Block
- Individual Plot Boundaries
- Common Areas to Flatted Block
- Bike Store
- Refuse Store
- Sprinkler system plant room
- Driveway
- Carparking Spaces
- Footpaths
- Shared Garden Space

The development registered under title MID164515 and plots 1 to 8 within have been DPA approved by:
D MacDonald 11/04/2023
David MacDonald (DPA Officer)

REV	DATE	DRAWN	DESCRIPTION	CHECK	APP'D
C	3/23	WH	SPRINKLED PLANT ROOM IDENTIFIED		
B	3/23	WH	REAR PATH AND PATIO REMOVED		
A	3/23	WH	UPDATED TO REFLECT AS BUILT SITUATION BUILDING OUTLINES PLAN ADDED		

CLIENT	Canal View Care Ltd		
JOB	48 Polwarth Terrace, Edinburgh		
DRAWING	Site Layout Showing Extent of Individual Plots		
STATUS	AS BUILT		
Drawn	Checked	Approved	DATE 19/10/22 JOB NO 14493 TR NO LG-00 REV C
<small>This drawing and its data are the copyright of Yeoman MacCallister Architects and must not be used for any purpose other than that for which it is created. Yeoman MacCallister accepts no responsibility for any inaccuracy in printing of this drawing by any parties.</small>			

yeomanmcallister

EDINBURGH: Waterline Studios, 54 Colinton Avenue, Edinburgh EH10 5RT, Tel: 0131 346 1853, info@ym-architects.com

LONDON: Wembley, Tel: 07825 86637, info@ym-london.com