

Legend

- Site Boundary
- Indicates House Handing (OPPOSITE)
- Indicates House Handing (AS)
- Indicates 1800mm high timber fence (FT-F18)
- Indicates 1800mm high Acoustic timber fence (FT-F21)
- Indicates 1200mm high Post and (3) rail fence
- Indicates Tree Protection Zone
- Adoptable Paviour finish : Burnt Ochre
- Private Paviour finish : Burnt Ochre
- Adoptable Paviour finish : Charcoal
- Adoptable Road Asphalt finish
- Adoptable Footpath Asphalt finish
- Factor Maintained Footpath Asphalt finish
- Private Shared Road Asphalt finish
- Common Open Space factor maintained
- Common Access Path (Bodpave 85) factor maintained
- Private Footpath to be maintained by plots 7-8
- Private Footpath to be maintained by plots 7-8 & 11-12
- Private Footpath to be maintained by plots 11-12
- Private Shared Drive to be maintained by plots 19-20
- Private Parking Court to be maintained by plots 24-27
- Private Footpath to be maintained by plots 24-27
- Private Footpath to be maintained by Plots 32-33
- Private Footpath to be maintained by Plots 37-38
- Private Parking Court to be maintained by Plots 38-43
- Private Footpath to be maintained by Plots 41-43
- Private Shared Driveto be maintained by Plots 52-54
- Private Shared Drive to be maintained by Plots 55-57
- Private Access Path to be maintained by Plots 69-70
- Private Shared Drive to be maintained by Plots 76-79

NOTES

REVISIONS

- Rev E - 22nd February 2023 [RM] Individual plot boundaries adjusted as a result of on site fencing locations.
- Rev D - 28th September 2021 [KCB] Site red line and individual plot boundaries adjusted as a result of RoS title data received.
- Rev C - 18th May 2021 [KCB] Fence line to rear of plots 5-15, and to the side of 19 moved to site boundary. Red line boundaries adjusted accordingly.
- Rev B - 3rd November 2020 [gis] Plot 84 added. Parking at sub-station amended. Access to SUDS re-aligned. Common ground amended accordingly.
- Rev A - 24/09/20 (mty) Suds Pond indicated, additional paths to plots 75,76 & 83.


PROJECT TITLE
**GLENBOIG
 Croftfoot Farm**

DRAWING TITLE
DPA Layout

SCALE 1:500@A1	DATE 04/09/20	DRAWN mty
JOB NUMBER 513	DWG REFERENCE GLBG-DPA-001	REVISION E




Broxden House
 Broxden Business Park
 Lamberkin Drive
 PERTH, PH1 1RA
 Telephone: 01738 500820

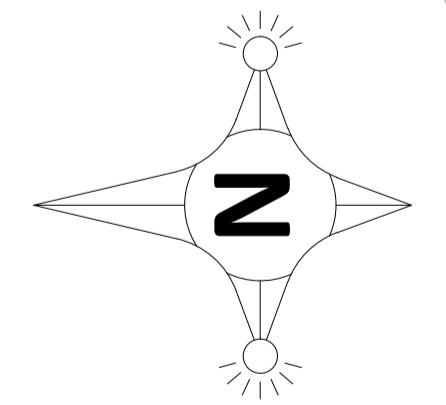

The Development registered under title GLA44038 and Plots 1, 18 to 59 68,75 to 79 and 84 within have been DPA approved by:

Craig McFadden - 14 April 2023
 Craig McFadden (DPA Officer)

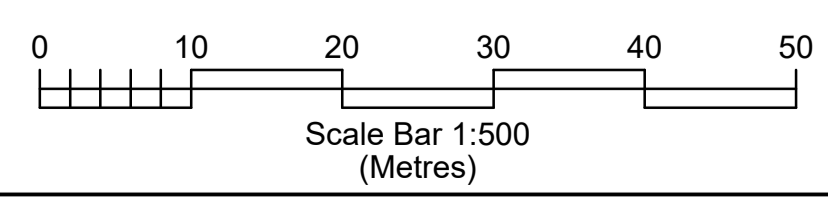

DRAWING SUBJECT TO APPROVAL BY LAND REGISTERS OF SCOTLAND.