


Site Layout Showing Plot 3 and Footprint of Flatted Block



The Development registered under title MID164515
and plots 1 to 8 within have been DPA approved.

The Keeper - 12 June 2023
Keeper for the Registers of Scotland

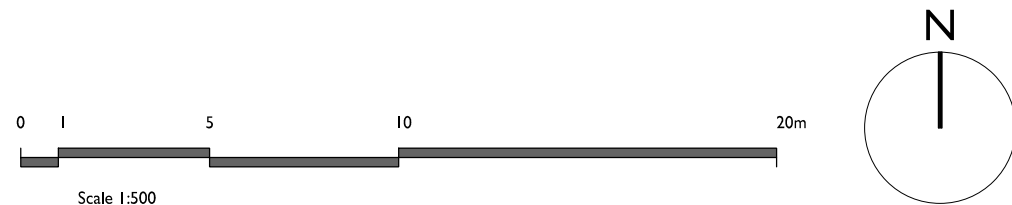

Site Layout Showing Building Outlines

- Site Boundary
- Footprint of Flatted Block
- Individual Plot Boundaries
- Common Areas to Flatted Block
- Bike Store
- Refuse Store
- Sprinkler system plant room
- Driveway
- Carparking Spaces
- Footpaths
- Shared Garden Space



Ground Floor Flats

First Floor Flats

Second Floor Flats

REV	DATE	DRAWN	DESCRIPTION	CHECK	APP'D
C	3/23	WH	SPRINKLED PLANT ROOM IDENTIFIED		
B	3/23	WH	REAR PATH AND PATIO REMOVED		
A	3/23	WH	UPDATED TO REFLECT AS BUILT SITUATION BUILDING OUTLINES PLAN ADDED		

0	50	100
CLIENT	Canal View Care Ltd	
JOB	48 Polwarth Terrace, Edinburgh	
DRAWING	Site Layout Showing Extent of Individual Plots	
STATUS	AS BUILT	
Drawn	Checked	Approved
DATE	19/10/22	JOB NO 514493 DR NO LG-00
REV C		
This drawing and its data are the copyright of Yeoman McAllister Architects and must not be used for any purpose other than that for which it is intended. Yeoman McAllister accepts no responsibility for any inaccuracy in printing of this drawing by any parties.		
SCALE	1:200	SHEET SIZE A1

yeomanmcallister

EDINBURGH -
Waterloo Studios
54 Colinton Avenue
Edinburgh, EH10 5RT
Tel: 0131 346 1845
Fax: 0131 346 1859
info@ym-architects.com

LONDON -
Wimbledon
29D
Tel: 07825 86637
info@ym-london.com