

LEGEND


- KEEPMOAT BOUNDARY
- FEU BOUNDARY
- ADOPTED VERGE
- SERVICE STRIP
- ACCESS STRIP FOR EXISTING TREE BELT MAINTENANCE
- ADOPTED ROADS / PATHS
- SHARED DRIVEWAY
- SHARED FOOTPATH
- NON-ADOPTABLE AREAS TO BE MAINTAINED BY DEVELOPMENT FACTOR
- SUB-STATION & GAS GOVERNOR
- GRAIN CABINET LOCATION
- 1 SHARED DRIVEWAY SHARED BETWEEN PLOTS 11 - 17 ONLY
- 2 SHARED DRIVEWAY SHARED BETWEEN PLOTS 47 - 49 ONLY
- 3 SHARED DRIVEWAY SHARED BETWEEN PLOTS 62 - 64 ONLY
- 4 SHARED DRIVEWAY SHARED BETWEEN PLOTS 71 - 77 ONLY

This is the Plan referred to in foregoing disposition by Keepmoat Homes LTD in favour of:

.....

Dated

Signed:
(for Keepmoat Homes)

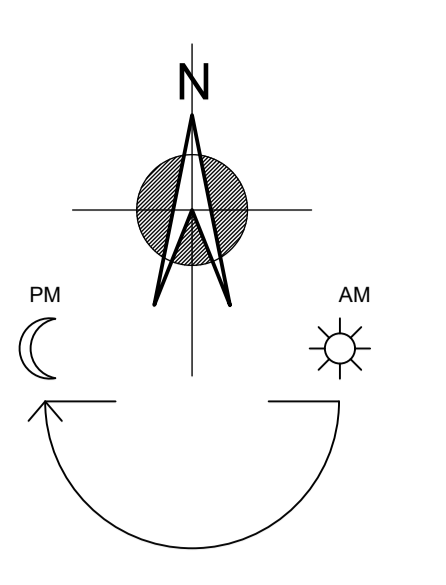

The development registered under title LAN246907 and plots 1 to 3, 56, 61, 71, 73 & 75 within have been DPA approved on behalf of:

The Keeper - 15/02/2024

Keeper of the Registers of Scotland



AMENDMENTS

Issue	Date	Detail
M	13.02.24	Position of Parking Bays at Plots 71-77 revised to suit as built (Minor Changes) - LM
L	12.09.23	Plot 61: 68 fence line revised to suit labelled fencing layout - LM
K	04.07.23	Plot 63: Headings revised to suit as built on-ordinates on site, driveway and access paths revised to suit - LM
J	31.08.22	Parking Court at Plots 71-77 amended to suit site plan. Bin storage moved to on-built position and parking No 6 amended to suit - LM
I	11.05.22	Fee boundary at Plot 66 revised to include driveway. Fee boundary at Plot 65 amended to suit changes - LM

Keepmoat Homes

Keepmoat, The Waterfront, Lakeside Boulevard, Doncaster, DN4 5PL.
Tel: 01302 347605 www.keepmoat.com

Project
Bertramfarm Springhill Road Shotts

Drawing
Deed of Conditions

Scale
1:500@A0

Drawn By
LM

Date
15/10/21

Drawing No	SFS(10)100 - DoC	M
------------	------------------	---