


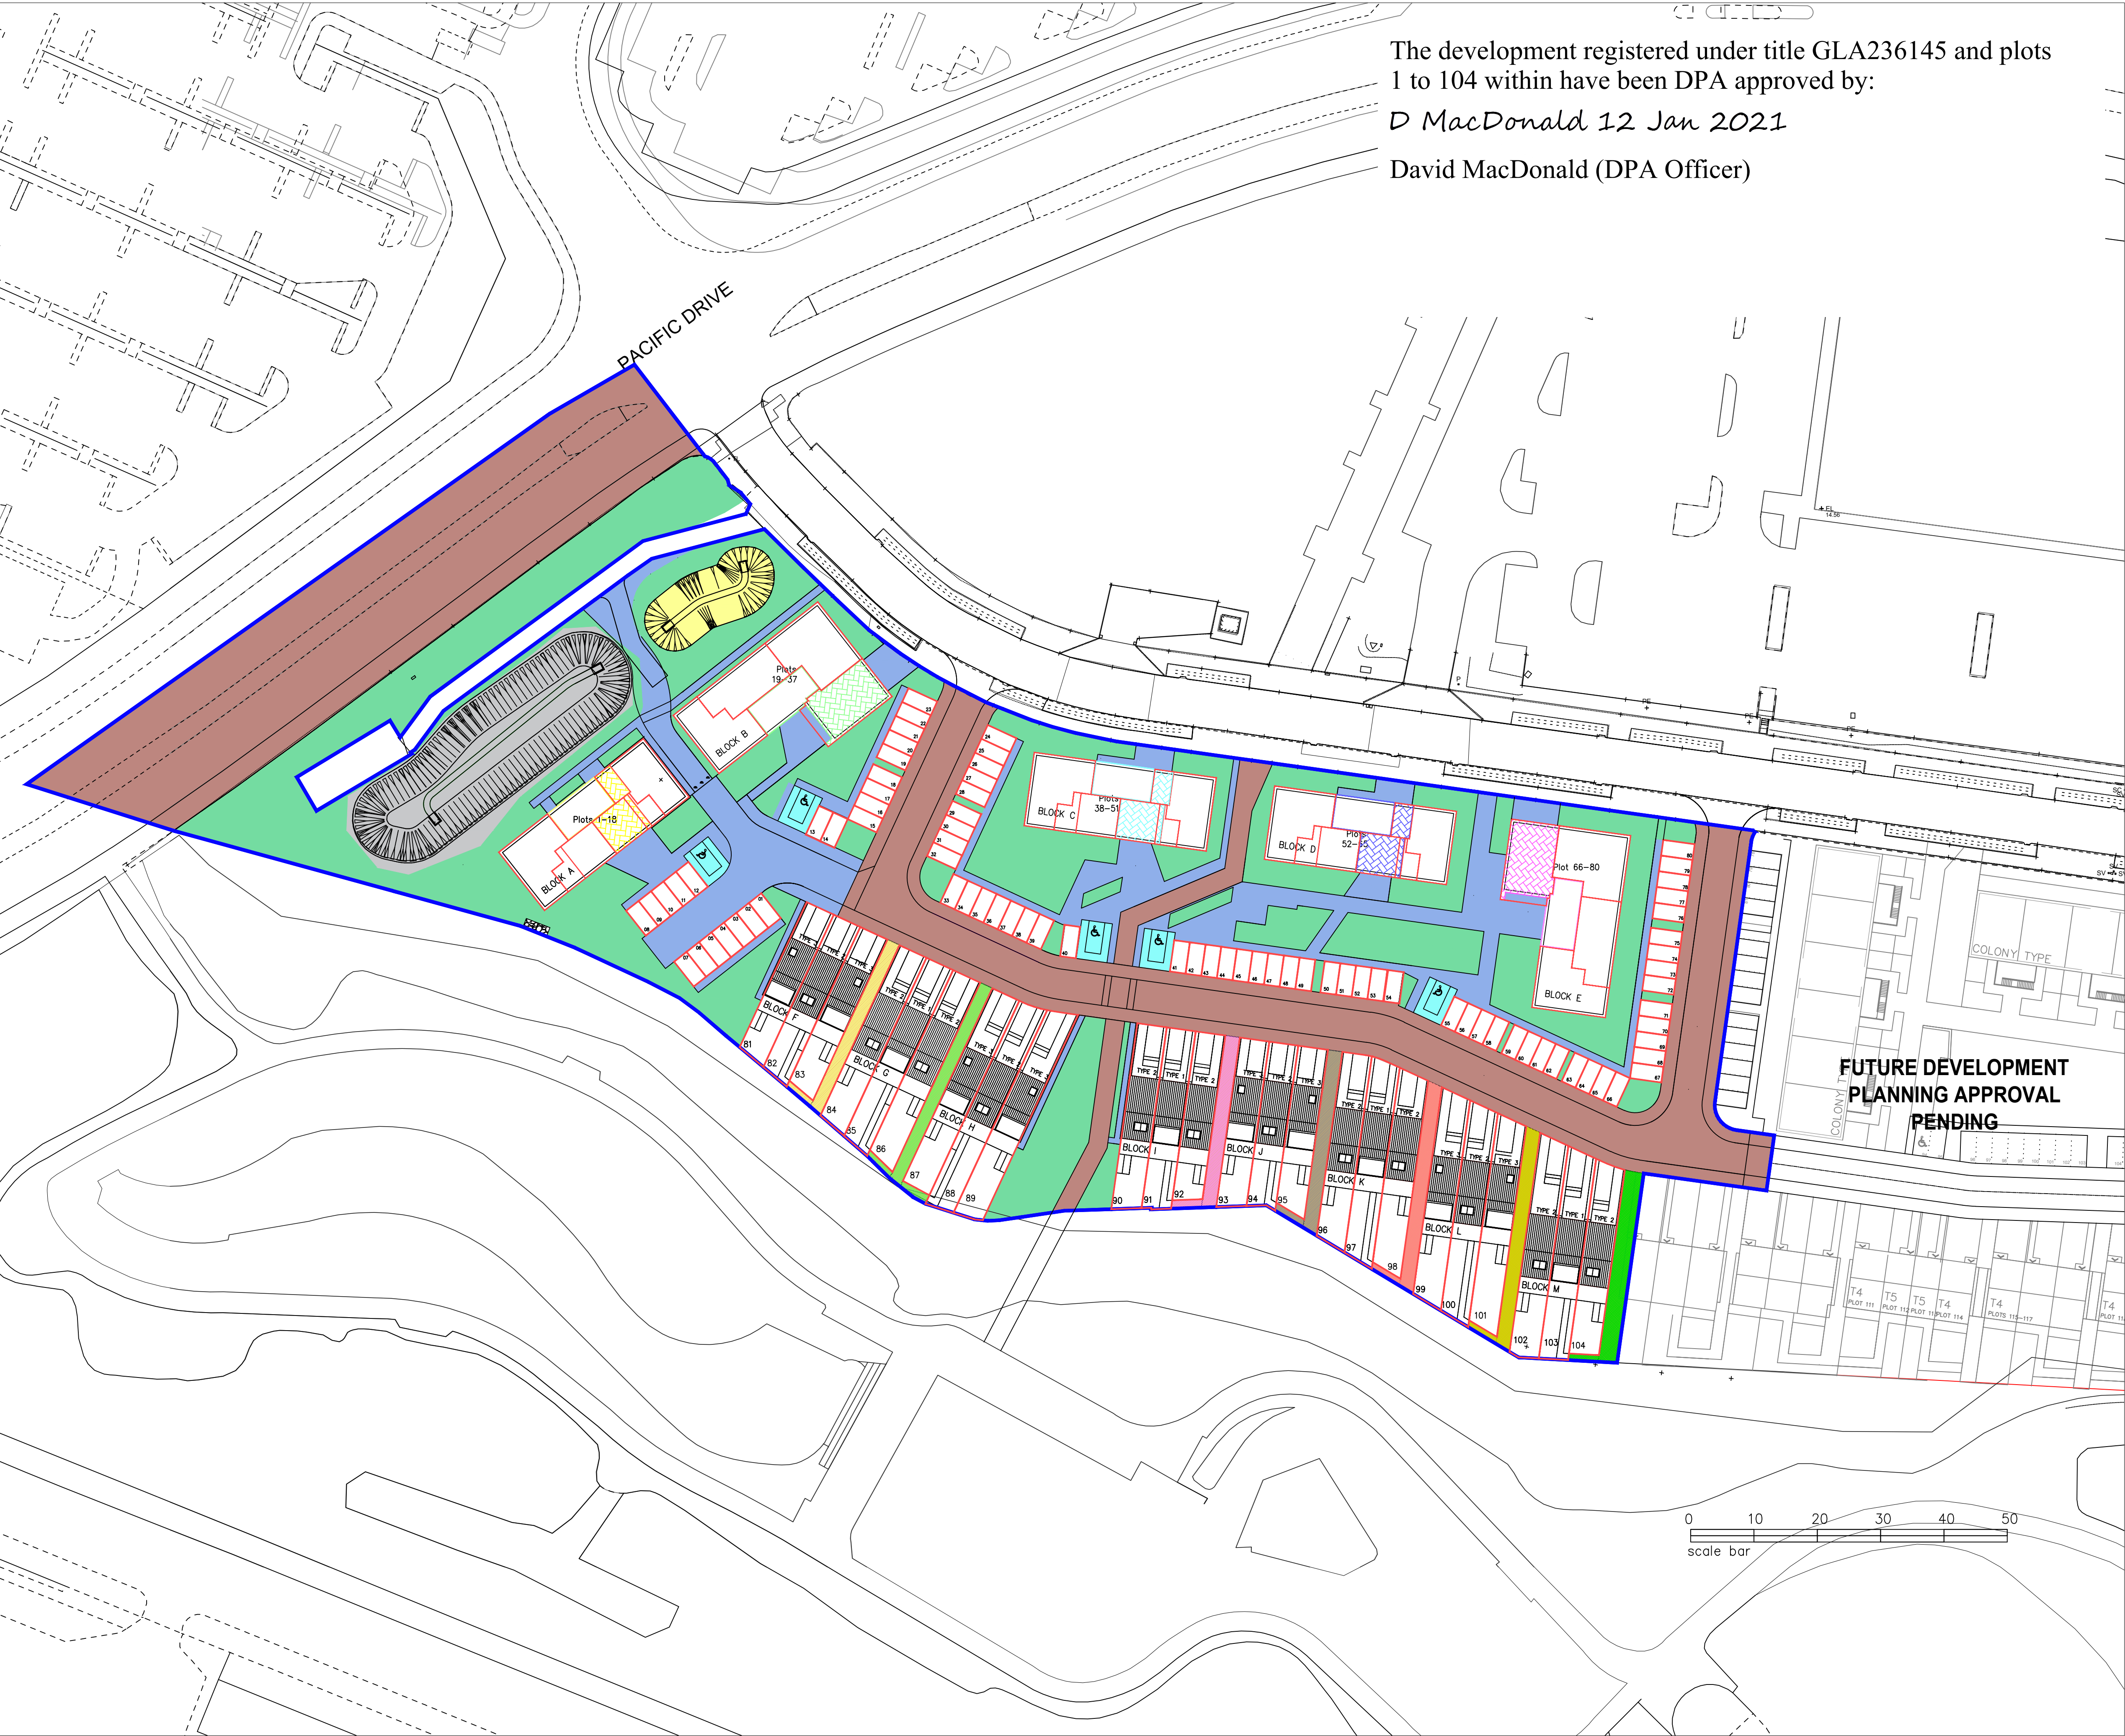

LEGEND	
	SITE BOUNDARY
	PLOT BOUNDARY
	DENOTES FLATTED BLOCK COMMUNAL AREA - BLOCK A PLOTS 1-18 MAINTAINED BY THE APPOINTED FACTOR
	DENOTES FLATTED BLOCK COMMUNAL AREA TO GROUND FLOOR - BLOCK A PLOTS 1-18 MAINTAINED BY THE APPOINTED FACTOR
	DENOTES FLATTED BLOCK COMMUNAL AREA - BLOCK B PLOTS 19-37 MAINTAINED BY THE APPOINTED FACTOR
	DENOTES FLATTED BLOCK COMMUNAL AREA TO GROUND FLOOR - BLOCK B PLOTS 19-37 MAINTAINED BY THE APPOINTED FACTOR
	DENOTES FLATTED BLOCK COMMUNAL AREA TO GROUND FLOOR - BLOCK C PLOTS 38-51 MAINTAINED BY THE APPOINTED FACTOR
	DENOTES FLATTED BLOCK COMMUNAL AREA TO GROUND FLOOR - BLOCK C PLOTS 38-51 MAINTAINED BY THE APPOINTED FACTOR
	DENOTES FLATTED BLOCK COMMUNAL AREA TO GROUND FLOOR - BLOCK D PLOTS 52-65 MAINTAINED BY THE APPOINTED FACTOR
	DENOTES FLATTED BLOCK COMMUNAL AREA TO GROUND FLOOR - BLOCK D PLOTS 52-65 MAINTAINED BY THE APPOINTED FACTOR
	DENOTES FLATTED BLOCK COMMUNAL AREA TO GROUND FLOOR - BLOCK E PLOTS 66-80 MAINTAINED BY THE APPOINTED FACTOR
	DENOTES FLATTED BLOCK COMMUNAL AREA TO GROUND FLOOR - BLOCK E PLOTS 66-80 MAINTAINED BY THE APPOINTED FACTOR
	DENOTES FLATTED BLOCK COMMUNAL AREA TO GROUND FLOOR - BLOCK F PLOTS 81-94 MAINTAINED BY THE APPOINTED FACTOR
	DENOTES FLATTED BLOCK COMMUNAL AREA TO GROUND FLOOR - BLOCK F PLOTS 81-94 MAINTAINED BY THE APPOINTED FACTOR
	DENOTES FLATTED BLOCK COMMUNAL AREA TO GROUND FLOOR - BLOCK G PLOTS 95-104 MAINTAINED BY THE APPOINTED FACTOR
	DENOTES FLATTED BLOCK COMMUNAL AREA TO GROUND FLOOR - BLOCK G PLOTS 95-104 MAINTAINED BY THE APPOINTED FACTOR
	DENOTES PRIVATE FOOTPATH MAINTAINED AND OWNED BY PLOT 82, 83, 84, WITH COMMUNAL LIGHTING MAINTAINED BY FACTOR WITH COSTS SPLIT BETWEEN ACCESSING PLOTS
	DENOTES PRIVATE FOOTPATH MAINTAINED AND OWNED BY PLOT 85, 86, 87, 88, WITH COMMUNAL LIGHTING MAINTAINED BY FACTOR WITH COSTS SPLIT BETWEEN ACCESSING PLOTS
	DENOTES PRIVATE FOOTPATH MAINTAINED AND OWNED BY PLOT 89, 90, 91, 92, 93, WITH COMMUNAL LIGHTING MAINTAINED BY FACTOR WITH COSTS SPLIT BETWEEN ACCESSING PLOTS
	DENOTES PRIVATE FOOTPATH MAINTAINED AND OWNED BY PLOT 94, 95, 96, 97, 98, WITH COMMUNAL LIGHTING MAINTAINED BY FACTOR WITH COSTS SPLIT BETWEEN ACCESSING PLOTS
	DENOTES PRIVATE FOOTPATH MAINTAINED AND OWNED BY PLOT 99, 100, 101, 102, WITH COMMUNAL LIGHTING MAINTAINED BY FACTOR WITH COSTS SPLIT BETWEEN ACCESSING PLOTS
	DENOTES PRIVATE FOOTPATH MAINTAINED AND OWNED BY PLOT 103, 104, WITH COMMUNAL LIGHTING MAINTAINED BY FACTOR WITH COSTS SPLIT BETWEEN ACCESSING PLOTS

REVISIONS			
rev	description	initials	check
A	Amended to reflect Solicitors comments	JM	15/12/20
B	TH path maintenance responsibility amended	JM	15/12/20
C	Carpark 66 redline amended as per solicitors comments	JM	04/01/21
D	Title Line around Plot 18 carparking added	JM	11/01/21




Cairnlee House, Callendar Business Park
Callendar Road, Falkirk, FK1 1XE.
tel 01324 600000 fax 01324 600101
www.cala.co.uk

JOB TITLE
PACIFIC QUAY
GLASGOW

DRAWING TITLE
MASTER TITLE PLAN

SCALE:1:500		SHEET SIZE:A1		DATE: 02/10/20	
DRAWN BY: JM		PRELIMINARY		FINAL	
CHECKED BY: JM					
CENTRAL MASTERED		DEVELOPMENT MASTERED			
SITE	McCOSKER	VER	MOD	DRG No.	REV PLOT
00237			DPA	001	D

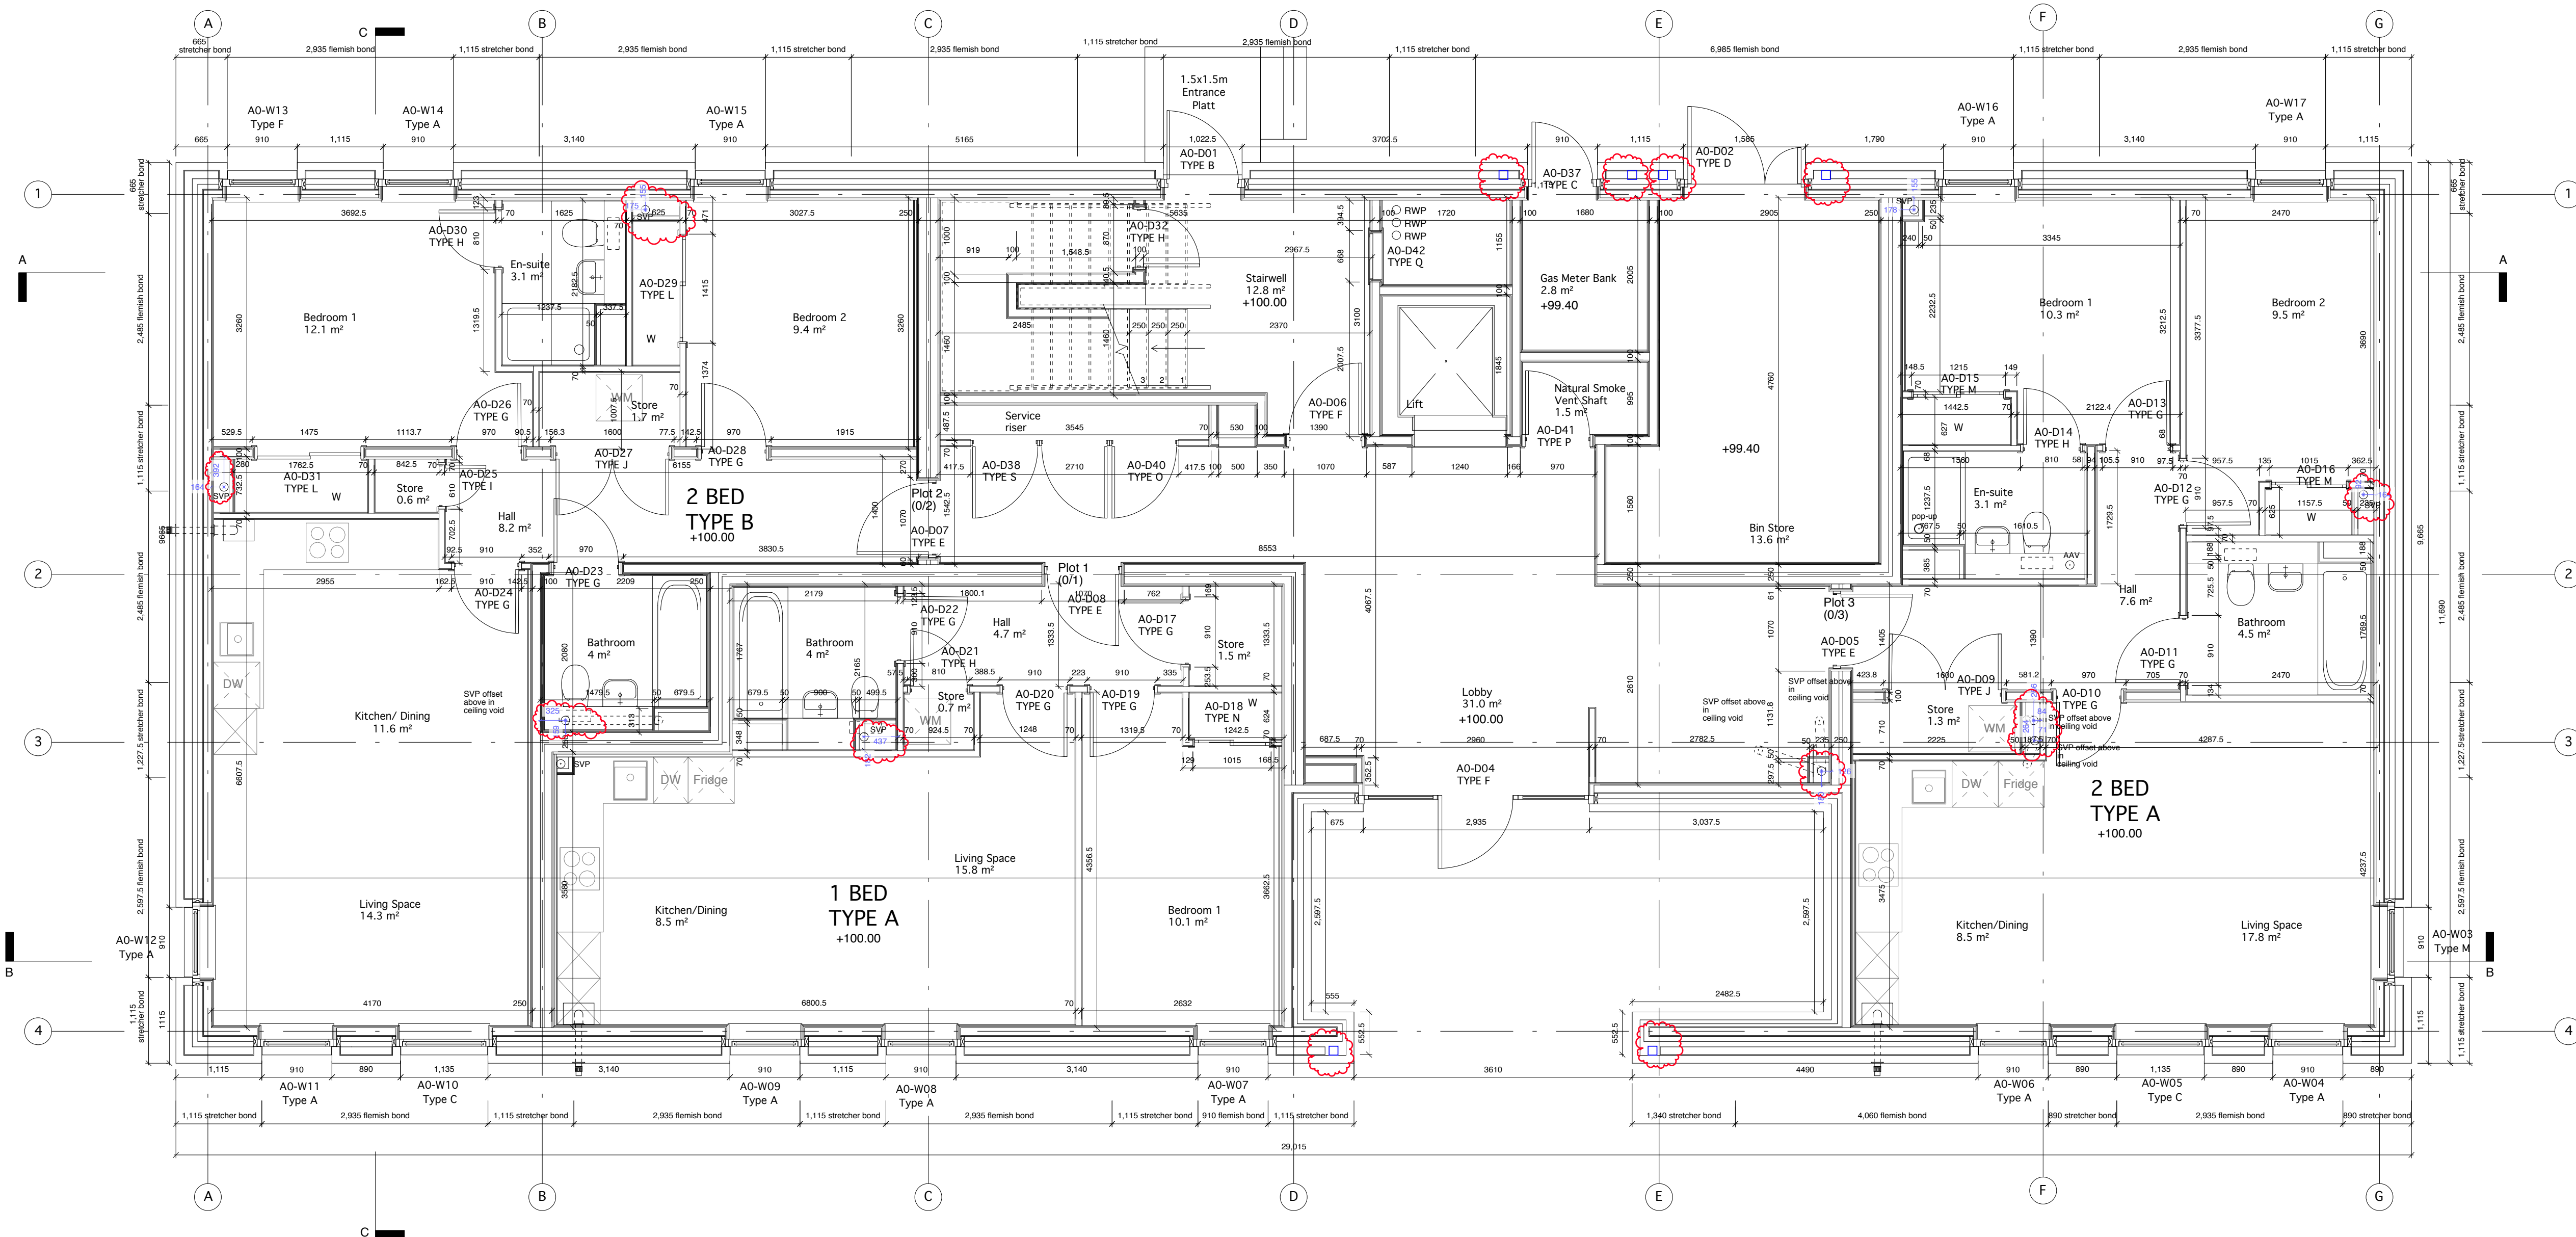

notes

This drawing is the copyright © property of Hypostyle Designs Ltd - no copying or distribution of this drawing or any part thereof is permitted without prior written permission.

Do not scale from this drawing. All existing dimensions to be checked on site prior to commencement of works or manufacturing of components.

Any discrepancies to be brought to the attention of the architect - if in doubt, ask.

S.H.E - safety health & environment information

1.
2.
3.

◊ - symbol indicates location & ref. no. of residual hazard/risk

Refer to engineering drawings for setting out of steelwork.

P22	Fill added to svp dims for clarity. Eng steelwork amended as per engineers drawing.	MK	MK	03.12.20
P21	Dims added to SVPs	MK	MK	08.10.20
P20	SVP positions revised. Offsets noted from above in ceiling void only.	JG	JG	04.09.20
P19	Door opening dimensions altered to suit 33mm jambs	JA	MK	14.08.20
P18	Store arrangement under stair altered	JG	JG	17.06.20
P17	Bathroom, En-Suite and SVP arrangement altered at client's request	JA	MK	07.05.20
P16	Stair arrangement altered as a result of leveling ground floor, entrance platt added, door type A0-D32 changed from G to H	JA	JG	04.03.20
P15	Window 'A0-W12' position corrected to reflect elevations, door A0-D04 changed to 31_002-Type F, Entrance opening reduced, goalposts added, Flemish bond adjusted	JA	JA	24.02.20
P14	SVP locations revised and offsets shown, Entrance door updated	KC	KC	04.12.19
P13	Kitchen layouts revised, SVPs added at client request	KC	MK	22.11.19
P12	Kitchen revised as per client request, stair dimensions added, sanitaryware shown, rwps relocated	KC	MK	06.11.19
P11	SVP and RWPs relocated	KC	MK	07.10.19
rev.	amendment	by	Checked	date

HYPOSTYLE

HYPOSTYLE Architects
www.hypostyle.co.uk

Glasgow

49 St. Vincent Crescent G3 8NG

T: 0141 204 4441 F: 0141 204 4897 E: glasgow@hypostyle.co.uk

Edinburgh

4 Sandport Place EH6 6EU

T: 0131 555 0888 F: 0131 553 4450 E: edinburgh@hypostyle.co.uk

client

CALA Homes

client's ref

project

**Pacific Quay,
Glasgow**

drawing

**Block A
Ground Floor GA Plan**

scale 1:50

page size A1

drawn KC

checked MK

date 08.08.19

date

job ref


3693

drawing num

20_100

rev

P22

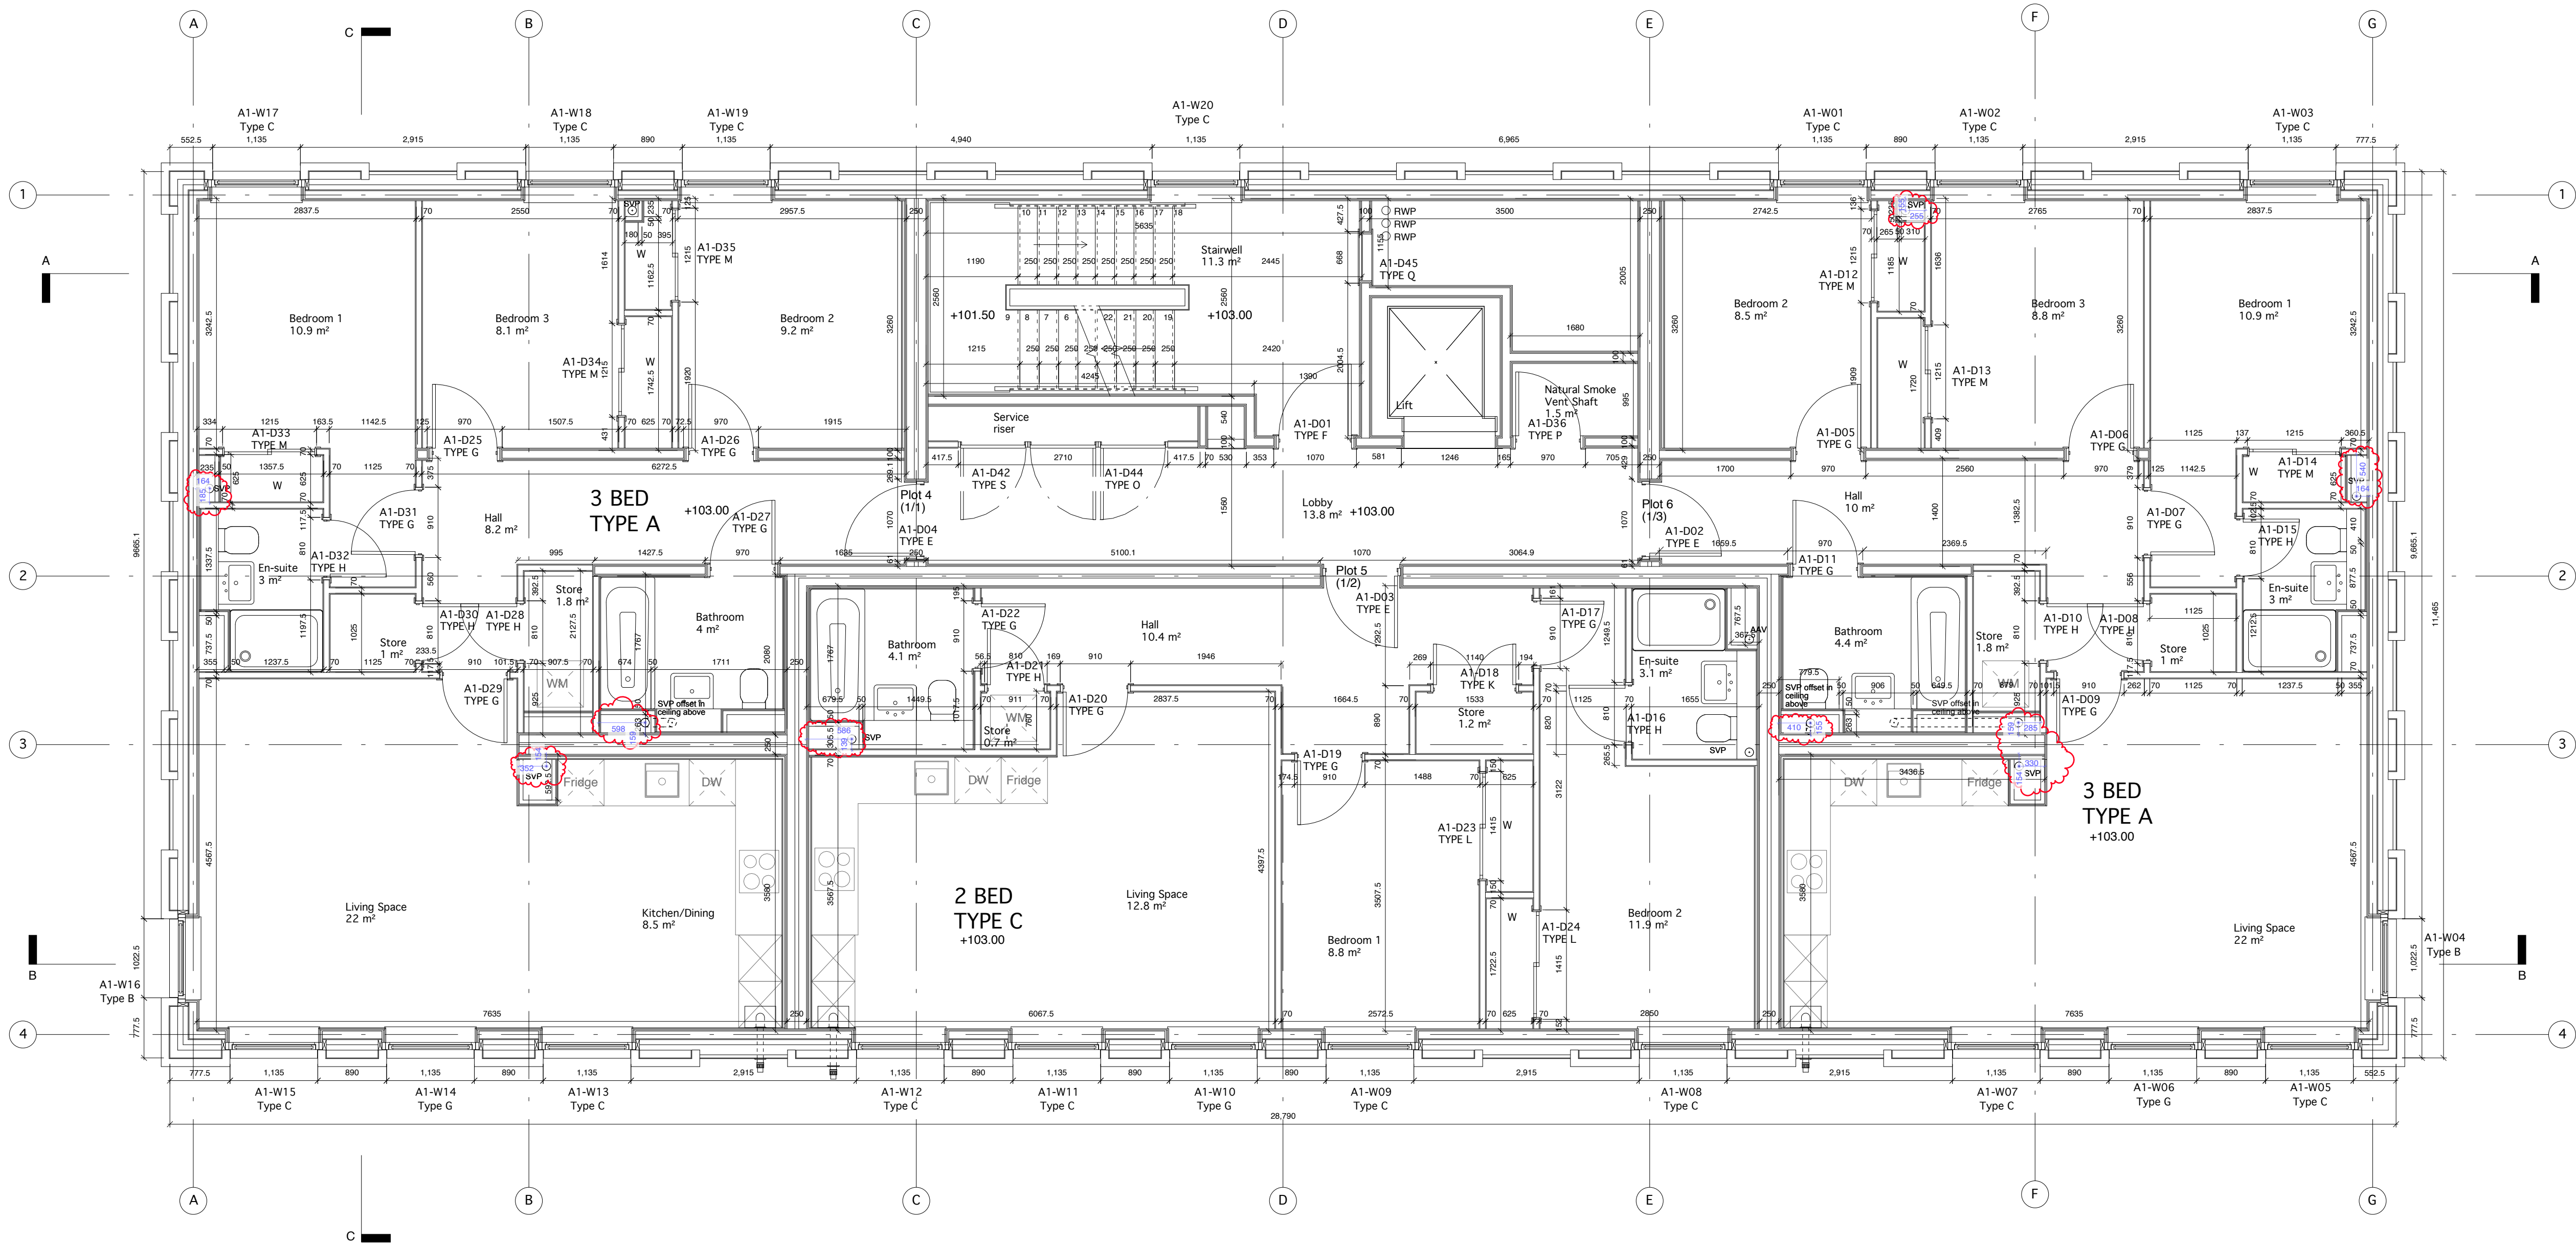

notes

This drawing is the copyright © property of Hypostyle Designs Ltd - no copying or distribution of this drawing or any part thereof is permitted without prior written permission.

Do not scale from this drawing. All existing dimensions to be checked on site prior to commencement of works or manufacturing of components.

Any discrepancies to be brought to the attention of the architect - if in doubt, ask.

S.H.E - safety health & environment information

1.

2.

3.

symbol indicates location & ref. no. of residual hazard/risk

Internal dimensions to steel frame

External dimensions to masonry

P21	Fill added to SVP for clarity. Boxing in 3 Bed Type A, amended as per Block D	MK	MK	03.12.20
P20	SVP dimensions added.	MK	MK	08.10.20
P19	SVP offsets noted as from above in ceiling void. SVP shown in en-suite, 2 Bed Type C to match HB	JG	JG	04.09.20
P18	Door opening dimensions altered to suit 33mm jambs	JA	MK	14.08.20
P17	SVP arrangement altered boxing behind WC extended and WC centred at client's request	JA	MK	07.05.20
P16	Stair arrangement altered as a result of leveling ground floor	JA	JA	05.03.20
P15	Window 'A1-W16' position corrected to reflect elevations	JA	JA	24.02.20
P14	SVP locations amended to respect NS clear zone. SVP offsets shown.	KC	KC	04.12.19
P13	Kitchen layouts revised, SVPs added at client request	KC	MK	22.11.19
P12	framing out revised, stair dimensions added, rwp's relocated	KC	MK	06.11.19
P11	SVP and RWPs relocated	KC	MK	07.10.19
rev.	amendment	by	Checked	date

HYPO
STYLE

HYPOSTYLE Architects
www.hypostyle.co.uk

Glasgow 49 St. Vincent Crescent G3 8NG
T: 0141 204 4441 F: 0141 204 4897 E: glasgow@hypostyle.co.uk
Edinburgh 4 Sandport Place EH6 6EU
T: 0131 555 0888 F: 0131 553 4450 E: edinburgh@hypostyle.co.uk

client

CALA Homes

client's ref

project

**Pacific Quay,
Glasgow**

drawing


**Block A
First Floor GA Plan**

scale 1:50

page size A1 drawn KC checked MK

date 08.08.19 date

job ref 3693 drawing num 20_101 rev P21

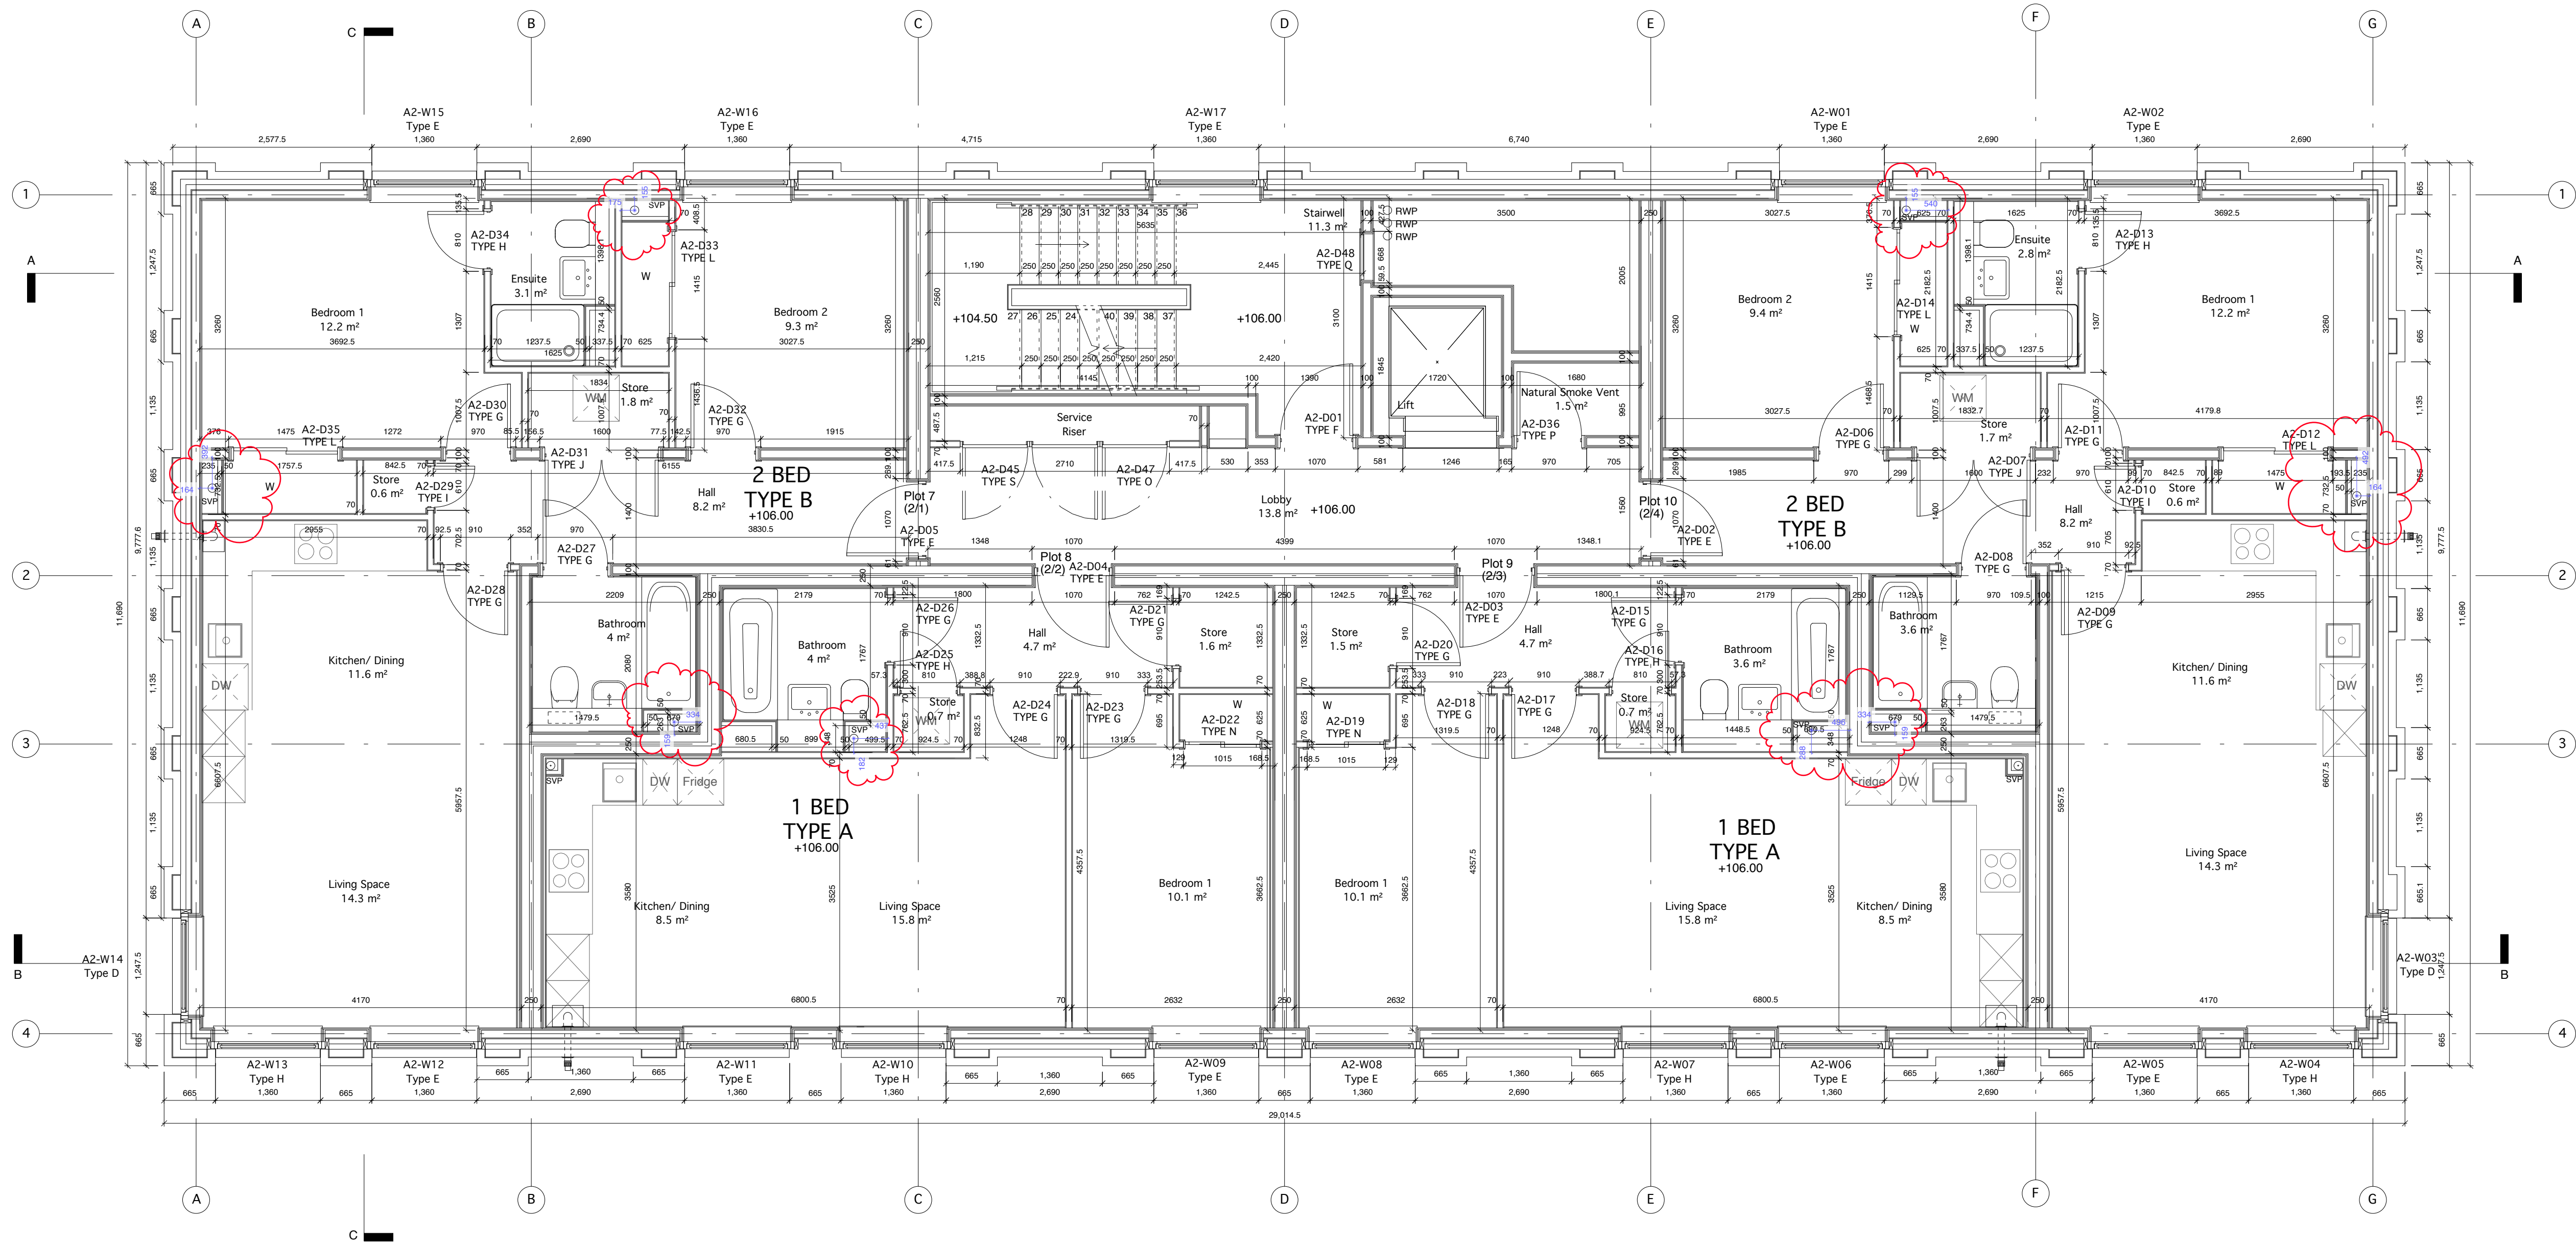

notes
This drawing is the copyright © property of Hypostyle Designs Ltd - no copying or distribution of this drawing or any part thereof is permitted without prior written permission.
Do not scale from this drawing. All existing dimensions to be checked on site prior to commencement of works or manufacturing of components.
Any discrepancies to be brought to the attention of the architect - if in doubt, ask.

S.H.E - safety health & environment information

1.
2.
3.

◊ - symbol indicates location & ref. no. of residual hazard/risk

Internal dimensions to steel frame
External dimensions to masonry

P20	Fill added to SVP dimensions for clarity	MK	MK	03.12.20
P19	SVP dimensions added.	MK	MK	08.10.20
P18	Minor adjustments to SVP locations to match below	JG	JG	04.09.20
P17	Door opening dimensions altered to suit 33mm jambs	JA	MK	14.08.20
P16	Bathroom/En-suite and SVP arrangement altered at clients request	JA	MK	07.05.20
P15	Stair numbering corrected	JA	JA	05.03.20
P14	SVP locations simplified and amended to respect NS clear zone, SVP offsets added, bathroom/en-suite layouts mirrored	KC	KC	04.12.19
P13	Kitchen layouts revised, SVPs added at client request	KC	MK	22.11.19
P12	Kitchen revised as per client request, stair dimensions added, tvps relocated	KC	MK	07.10.19
P11	SVP and RWP's relocated	KC	MK	07.10.19
rev.	amendment	by	Checked	date

HYPO

STYLE

HYPOSTYLE Architects

www.hypostyle.co.uk

Glasgow 49 St. Vincent Crescent G3 8NG
T: 0141 204 4441 F: 0141 204 4897 E: glasgow@hypostyle.co.uk
Edinburgh 4 Sandport Place EH6 6EU
T: 0131 555 0888 F: 0131 553 4450 E: edinburgh@hypostyle.co.uk

client

CALA Homes

client's ref

project

**Pacific Quay,
Glasgow**

drawing

**Block A
Second Floor GA Plan**

scale 1:50


page size A1 drawn KC checked MK
date 08.08.19 date

job ref 3693 drawing num 20_102 rev P20

For Construction

scale bar

0 1 2 3 4 5

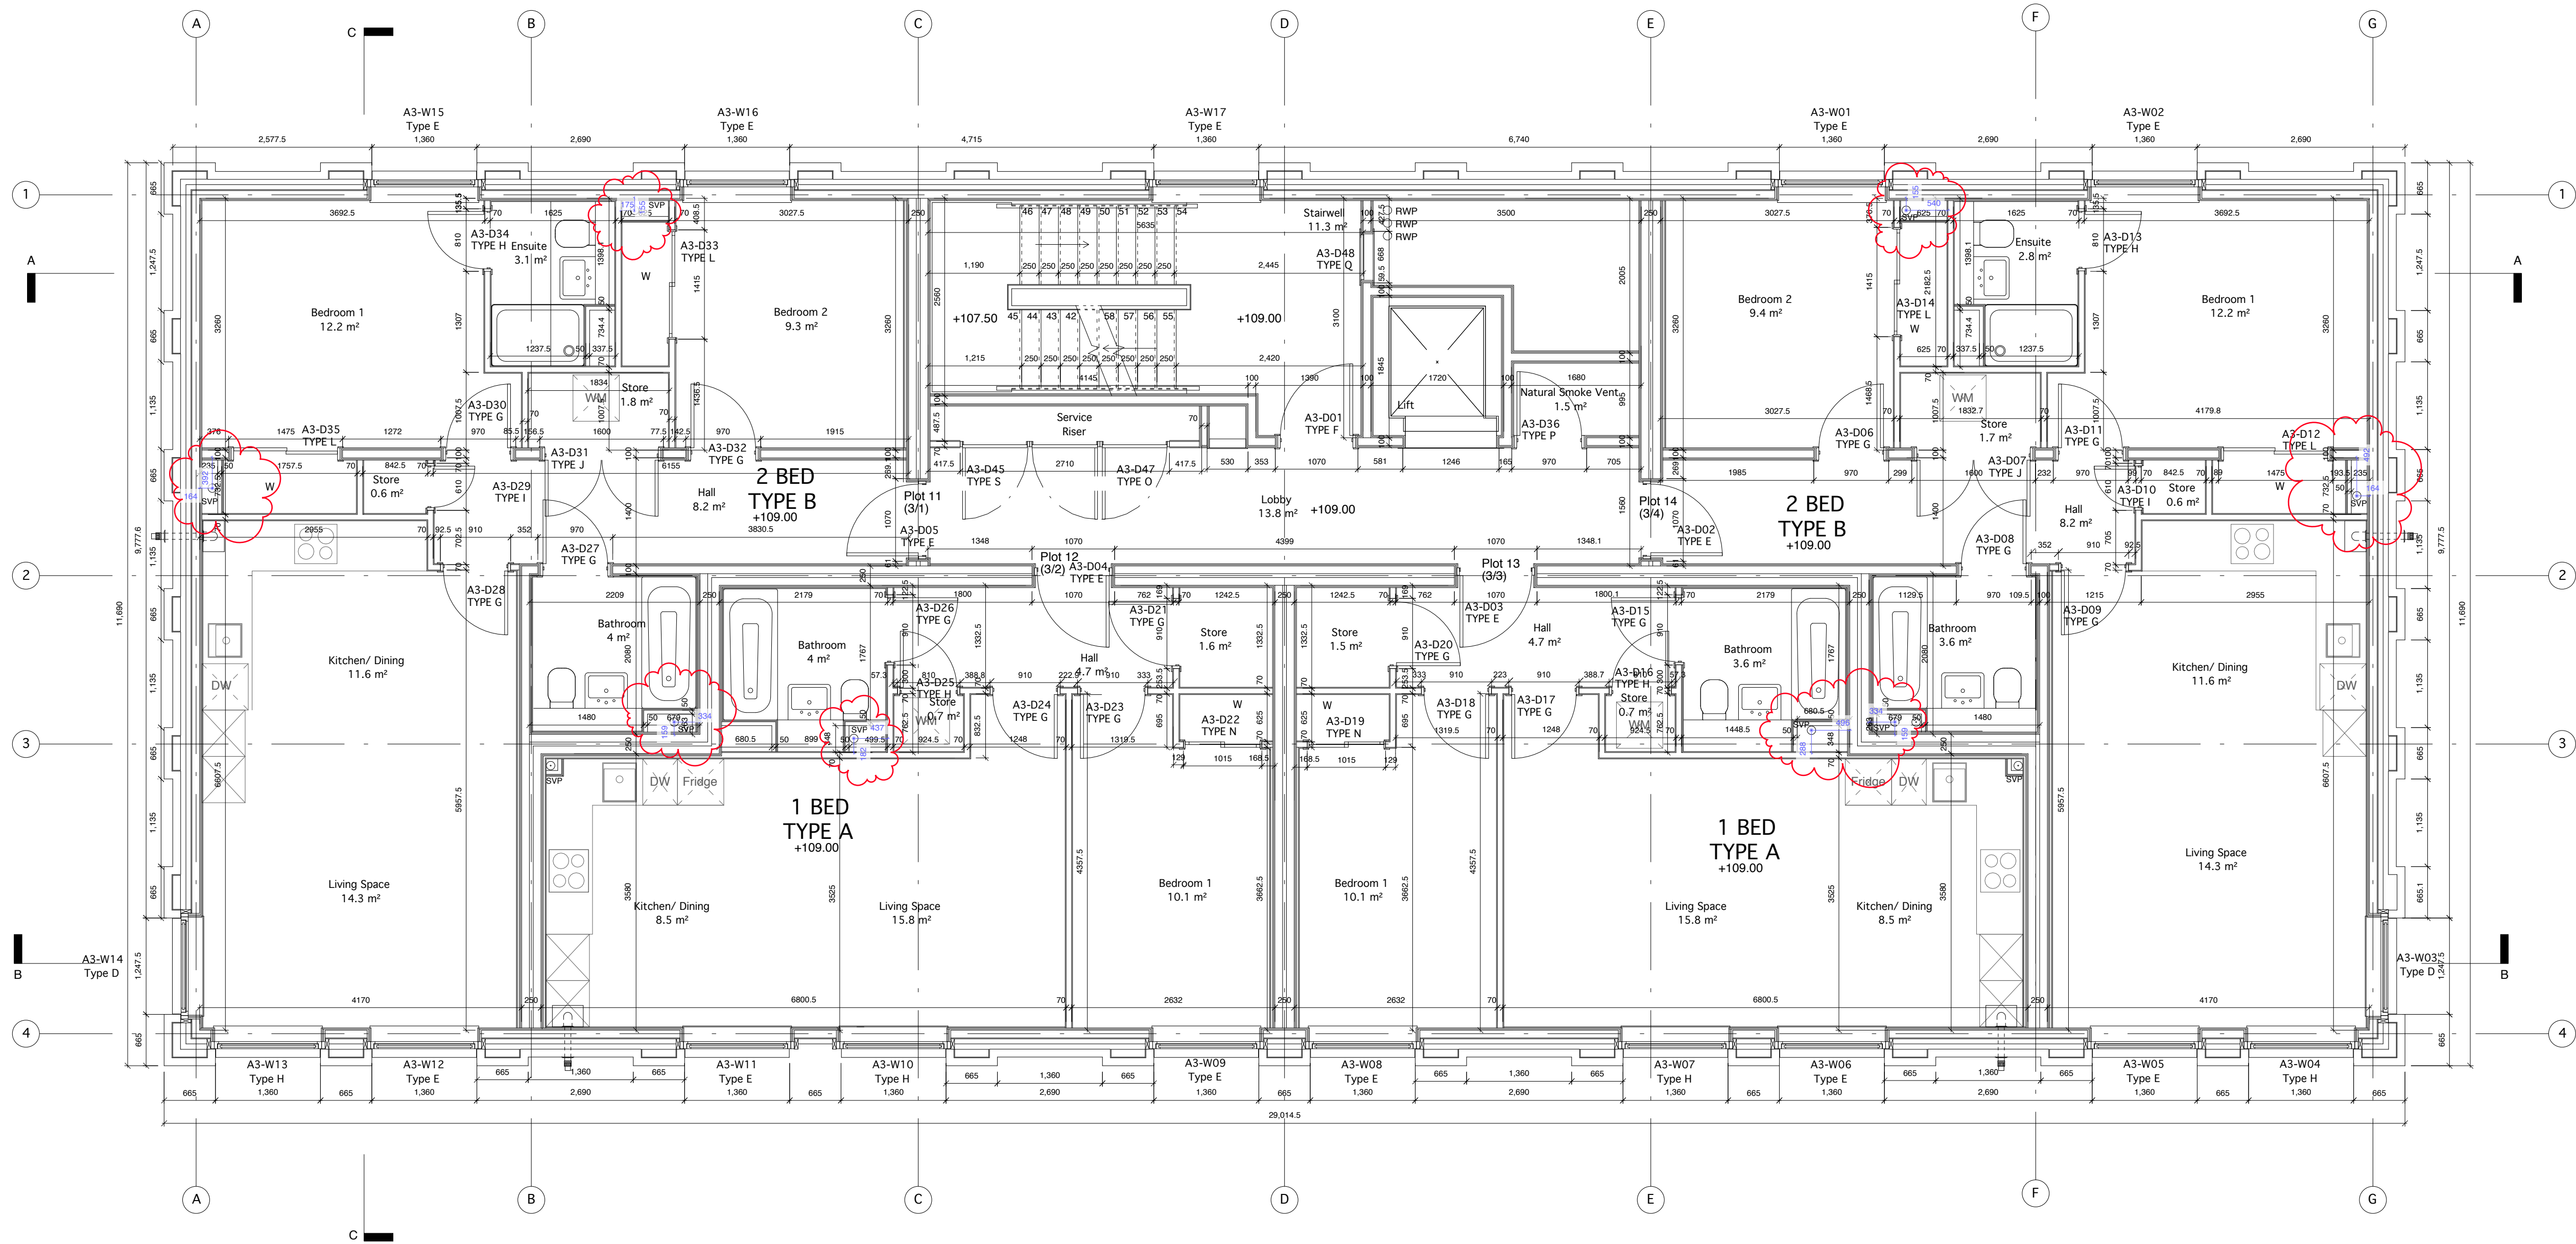

notes

This drawing is the copyright © property of Hypostyle Designs Ltd - no copying or distribution of this drawing or any part thereof is permitted without prior written permission.

Do not scale from this drawing. All existing dimensions to be checked on site prior to commencement of works or manufacturing of components.

Any discrepancies to be brought to the attention of the architect - if in doubt, ask.

S.H.E - safety health & environment information

1.

2.

3.

symbol indicates location & ref. no. of residual hazard/risk

Internal dimensions to steel frame
External dimensions to masonry

P20	Fill added to SVP dimensions for clarity	MK	MK	03.12.20
P19	SVP dimensions added.	MK	MK	08.10.20
P18	SVP offsets noted as above only. Offset below notation removed	JG	JG	04.09.20
P17	Door opening dimensions altered to suit 33mm jambs	JA	MK	14.08.20
P16	Bathroom and SVP arrangement altered at client's request	JA	MK	07.05.20
P15	Stair numbering corrected	JA	JA	05.03.20
P14	SVP locations simplified and amended to respect NS clear zone, SVP offsets added, bathroom/en-suite layouts mirrored	KC	KC	04.12.19
P13	Kitchen layouts revised, SVPs added at client request	KC	MK	22.11.19
P12	Kitchen revised as per client request, stair dimensions added, tvps relocated	KC	MK	07.10.19
P11	SVP and RWP's relocated	KC	MK	07.10.19
rev.	amendment	by	Checked	date

HYPOSTYLE

HYPOSTYLE Architects
www.hypostyle.co.uk

Glasgow 49 St. Vincent Crescent G3 8NG
T: 0141 204 4441 F: 0141 204 4897 E: glasgow@hypostyle.co.uk
Edinburgh 4 Sandport Place EH6 6EU
T: 0131 555 0888 F: 0131 553 4450 E: edinburgh@hypostyle.co.uk

client

CALA Homes

client's ref

project

**Pacific Quay,
Glasgow**

drawing

**Block A
Third Floor GA Plan**

scale 1:50

page size A1 drawn KC checked MK

date 08.08.19 date


job ref 3693 drawing num 20_103 rev

P20

For Construction

scale bar

0 1 2 3 4 5

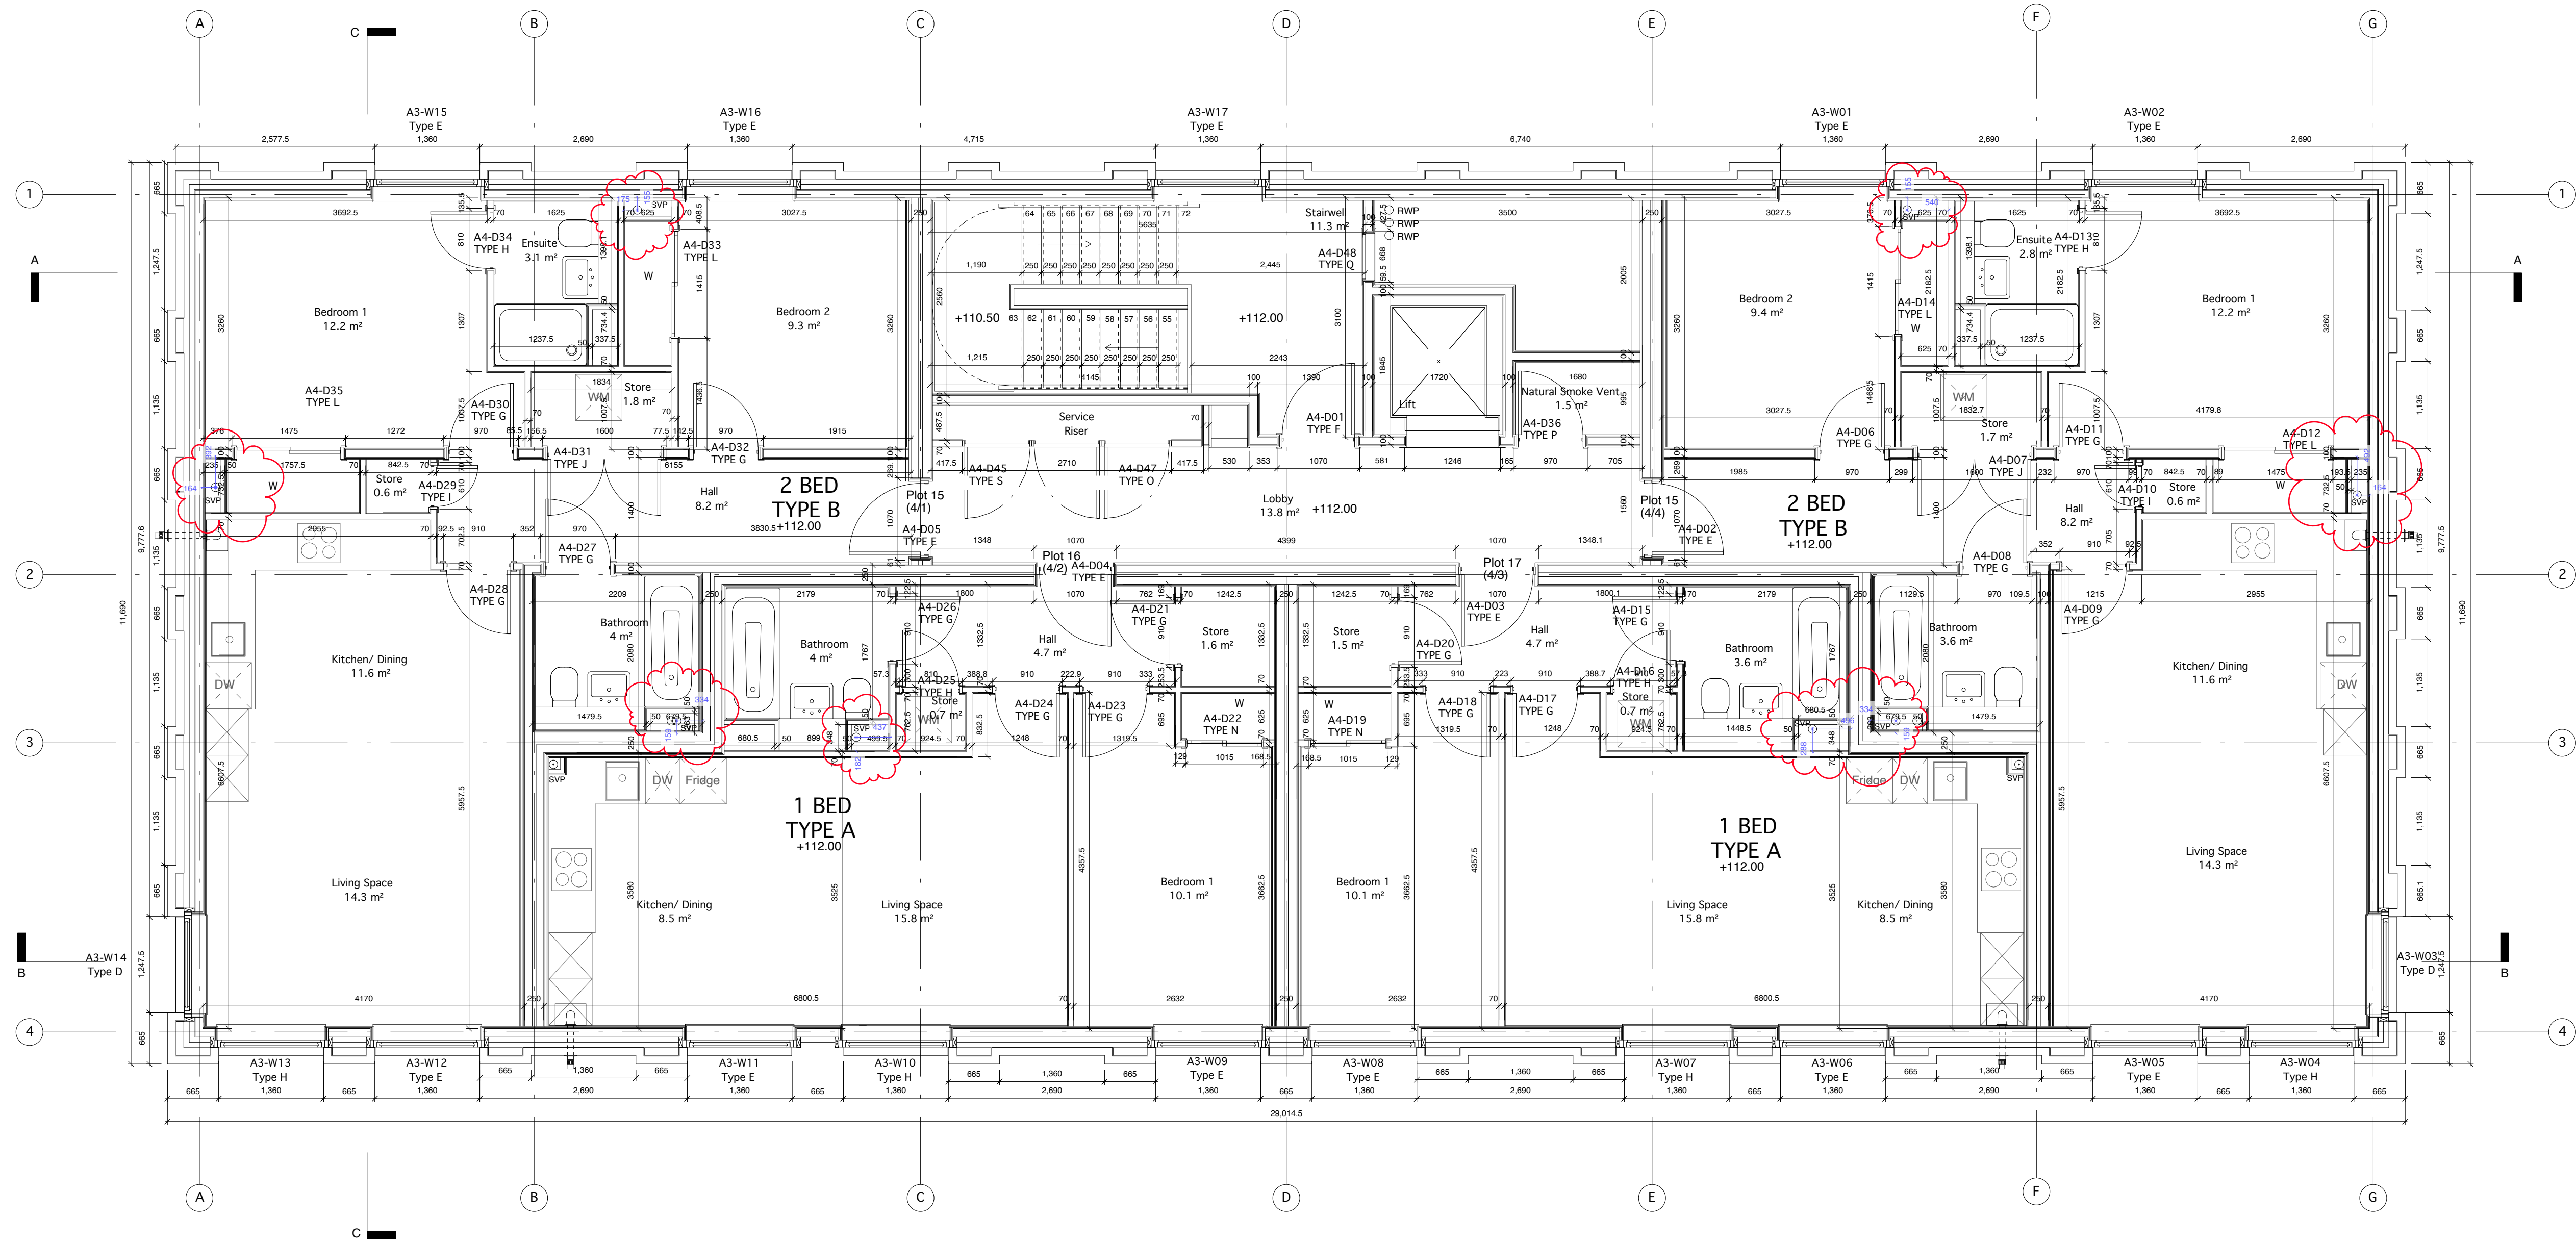

notes

This drawing is the copyright © property of Hypostyle Designs Ltd - no copying or distribution of this drawing or any part thereof is permitted without prior written permission.

Do not scale from this drawing. All existing dimensions to be checked on site prior to commencement of works or manufacturing of components.

Any discrepancies to be brought to the attention of the architect - if in doubt, ask.

S.H.E - safety health & environment information

1.

2.

3.

◊ - symbol indicates location & ref. no. of residual hazard/risk

Internal dimensions to steel frame
External dimensions to masonry

P19	SVP dimensions added.	MK	MK	08.10.20
P18	SVP offsets noted as above only. Offset below notation removed	JG	JG	04.09.20
P17	Door opening dimensions altered to suit 33mm jambs	JA	MK	14.08.20
P16	Bathroom, En-suite and SVP arrangement altered at client's request	JA	MK	07.05.20
P15	Stair numbering corrected	JA	JA	05.03.20
P14	SVP locations simplified and amended to respect NS clear zone, SVP offsets added, bathroom/en-suite layouts mirrored	KC	KC	04.12.19
P13	Kitchen layouts revised, SVPs added at client request	KC	MK	22.11.19
P12	Kitchen revised as per client request, stair dimensions added, tvps relocated	KC	MK	07.10.19
P11	SVP and RWP's relocated	KC	MK	07.10.19
rev.	amendment	by	Checked	date

HYPO

STYLE

HYPOSTYLE Architects

www.hypostyle.co.uk

Glasgow 49 St. Vincent Crescent G3 8NG
T: 0141 204 4441 F: 0141 204 4897 E: glasgow@hypostyle.co.uk
Edinburgh 4 Sandport Place EH6 6EU
T: 0131 555 0888 F: 0131 553 4450 E: edinburgh@hypostyle.co.uk

client

CALA Homes

client's ref

project

**Pacific Quay,
Glasgow**

drawing

**Block A
Fourth Floor GA Plan**

scale 1:50

page size A1

date 08.08.19

job ref 3693


drawing num 20_104

checked MK

date

rev

P19

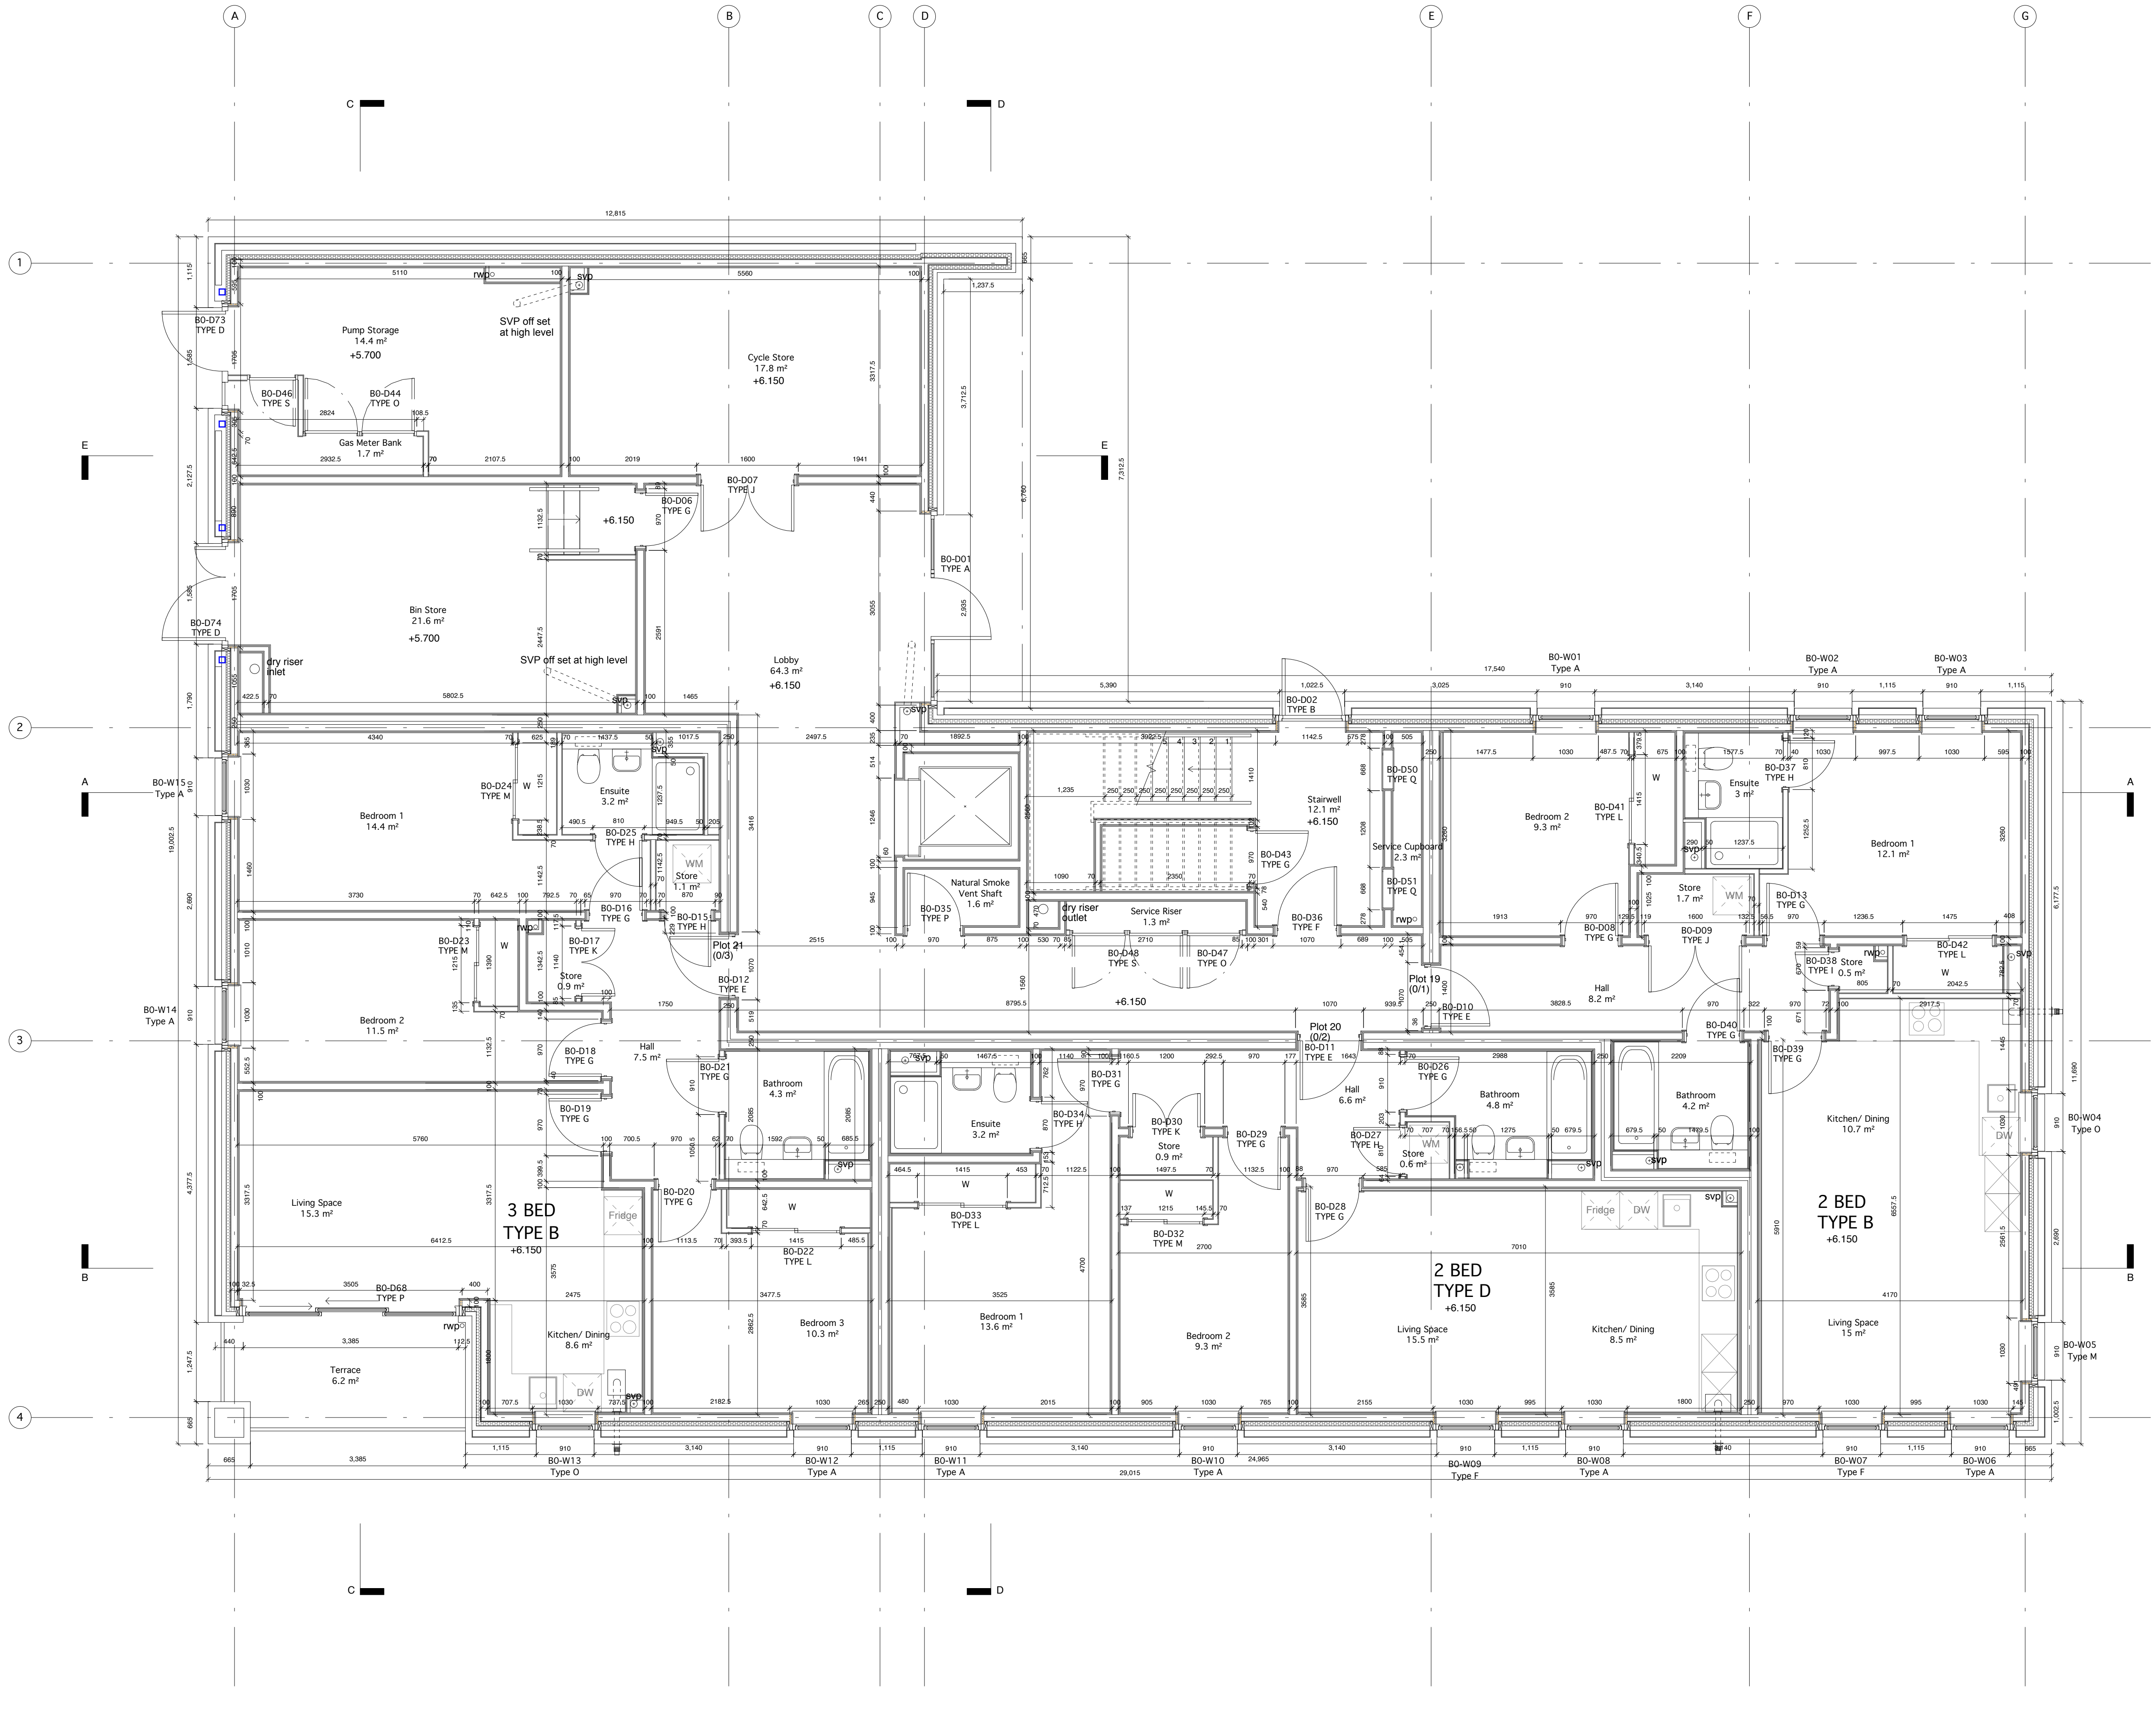

notes
This drawing is the copyright © property of Hypostyle Designs Ltd - no copying or distribution of this drawing or any part thereof is permitted without prior written permission.
Do not scale from this drawing. All existing dimensions to be checked on site prior to commencement of works or manufacturing of components.
Any discrepancies to be brought to the attention of the architect - if in doubt, ask.

S.H.E - safety health & environment information

1.
2.
3.

symbol indicates location & ref. no. of residual hazard/risk

Internal dimensions to steel frame
External dimensions to masonry
Refer to engineering drawings for setting out of steelwork.

P18	Steelwork note added.	MK	MK	03.12.20
P17	Gas bank adjusted, and fixed louvred panel introduced to Gas Bank as per client design. EQ-D01 type amended.	MK	MK	06.10.20
P16	Door opening dimensions altered to suit 33mm jambs. postposts added	JA	MK	14.08.20
P15	Levels amended to reflect engineer's, 1 stair omitted to fight in the bin store, door 'BO-001' altered, postposts added	JA	JA	26.02.20
P14	SVP locations amended to respect NS clear zone	KC	MK	02.12.19
P13	Kitchens revised and SVP added as client request	KC	MK	21.11.19
P12	Kitchen revised as per client's request, stair dimensions added, steel revised in line with Block E	KC	MK	14.11.19
P11	Door dimensions revised, structural slab levels added, cavity resized, Kitchen Layouts added, changed to monochrome, door & window references and section lines added	KC	MK	31.10.19
P10	Type B terrace doors, half brick rebate added as per balcony workshop discussion, internal RWP positions amended following IKO workshop	MK	MK	24.09.19
rev.	amendment	by	Checked	date

HYPOSTYLE
HYPOSTYLE Architects
www.hypostyle.co.uk

Glasgow 49 St. Vincent Crescent G3 8NG
T: 0141 204 4441 F: 0141 204 4897 E: glasgow@hypostyle.co.uk
Edinburgh 4 Sandport Place EH6 6EU
T: 0131 555 0888 F: 0131 553 4450 E: edinburgh@hypostyle.co.uk

client

CALA Homes

client's ref

project

Pacific Quay, Glasgow

drawing

**Block B
Ground Floor GA Plans**

scale 1:50

page size A1

date 08.08.19

checked MK

date

job ref 3693


drawing num 20_110

rev P18

For Construction

5
4
3
2
1
0

scale bar

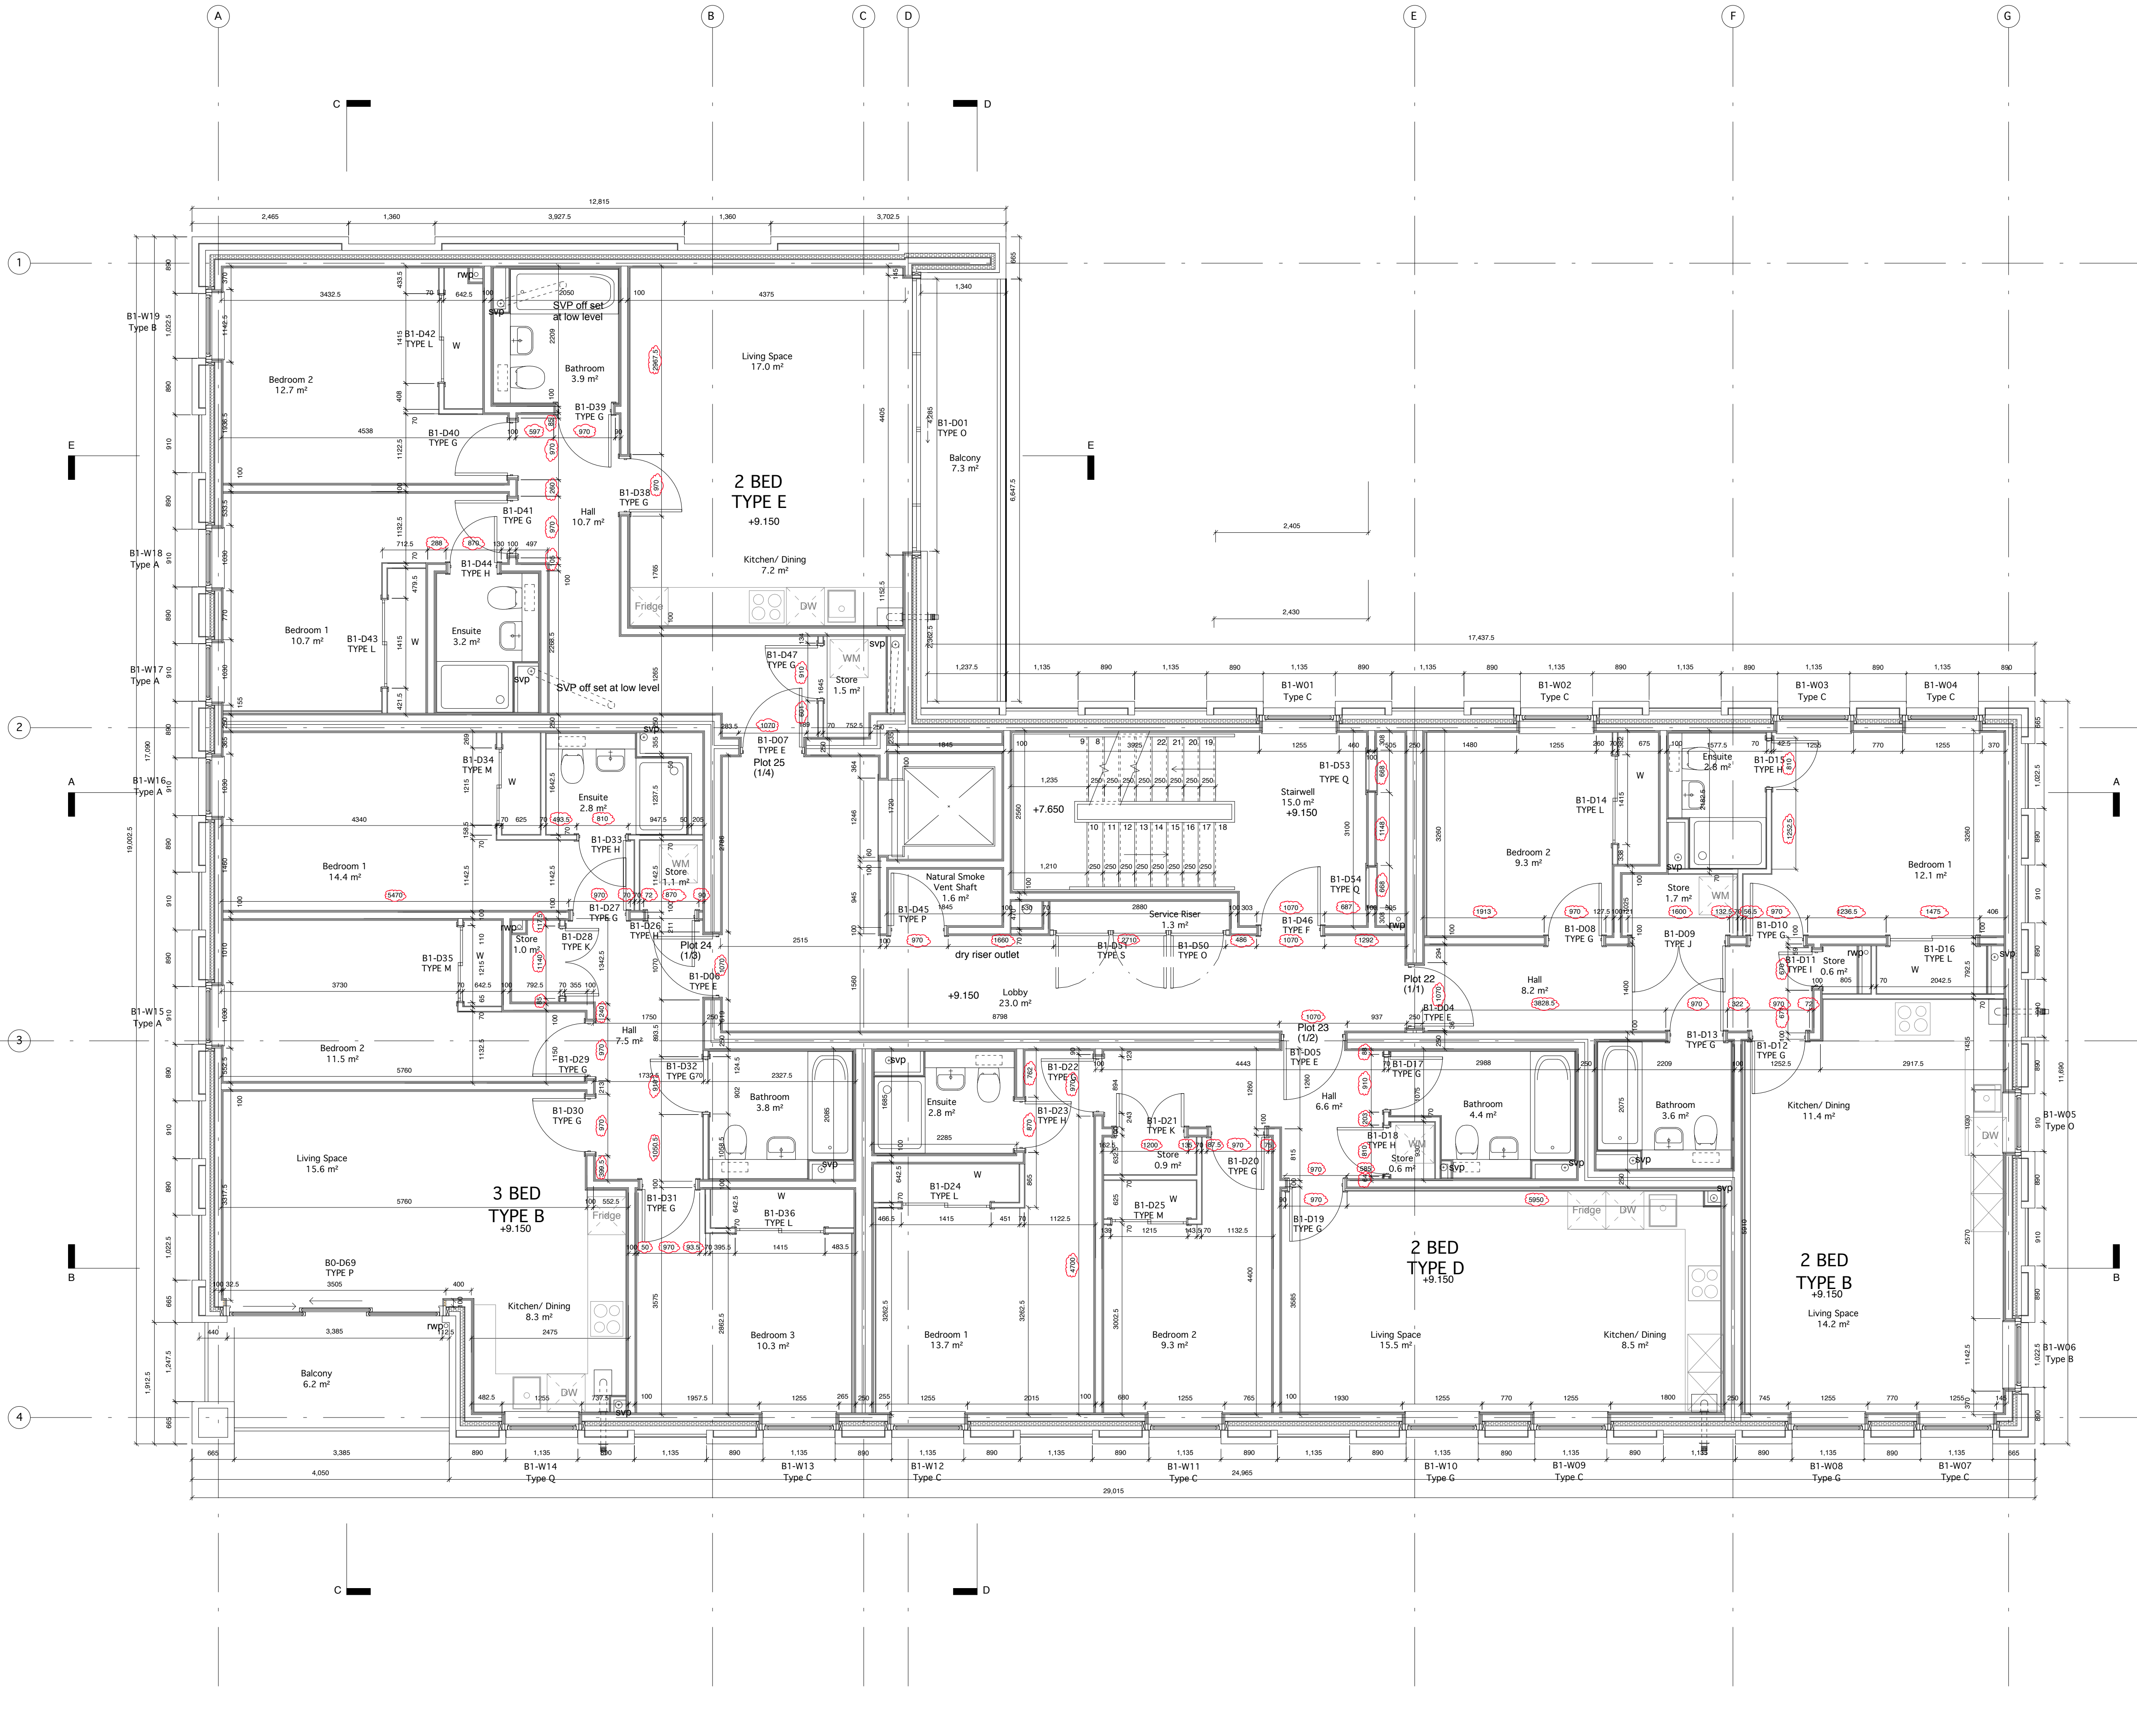

notes
This drawing is the copyright © property of Hypostyle Designs Ltd - no copying or distribution of this drawing or any part thereof is permitted without prior written permission.
Do not scale from this drawing. All existing dimensions to be checked on site prior to commencement of works or manufacturing of components.
Any discrepancies to be brought to the attention of the architect - if in doubt, ask.

S.H.E - safety health & environment information

1.
2.
3.

◊ - symbol indicates location & ref. no. of residual hazard/risk

Internal dimensions to steel frame
External dimensions to masonry

P15	Door opening dimensions altered to suit 33mm jambs	JA	MK	14.08.20
P14	SVP locations amended to respect NS clear zone	KC	KC	02.12.19
P13	Kitchens revised and SVP added as client request	KC	MK	21.11.19
P12	Kitchens revised as per client request, stair dimensions added, pier and steel at angle balcony amended in line with Block E	KC	MK	12.11.19
P11	Door dimensions revised, structural slab levels added, cavity resized, changed to monochrome. Kitchen layouts added, door & window references and section lines added	KC	MK	31.10.19
P10	Type B terrace doors, half brick rebate added. Type E Balcony opening width reduced to under 4400 as per balcony workshop discussion. Internal RWP positions amended following IKO workshop.	MK	MK	24.09.19
rev.	amendment	by	Checked	date

HYPO
STYLE

HYPOSTYLE Architects
www.hypostyle.co.uk

Glasgow 49 St. Vincent Crescent G3 8NG
T: 0141 204 4441 F: 0141 204 4897 E: glasgow@hypostyle.co.uk
Edinburgh 4 Sandport Place EH6 6EU
T: 0131 555 0888 F: 0131 553 4450 E: edinburgh@hypostyle.co.uk

client
CALA Homes

client's ref
project
**Pacific Quay,
Glasgow**


drawing
**Block B
First Floor GA Plans**

scale 1:50
page size A1
job ref 3693
date 08.08.19
drawn KC
drawing num 20_111
checked MK
date
rev P15

For Construction

5
4
3
2
1
0

scale bar

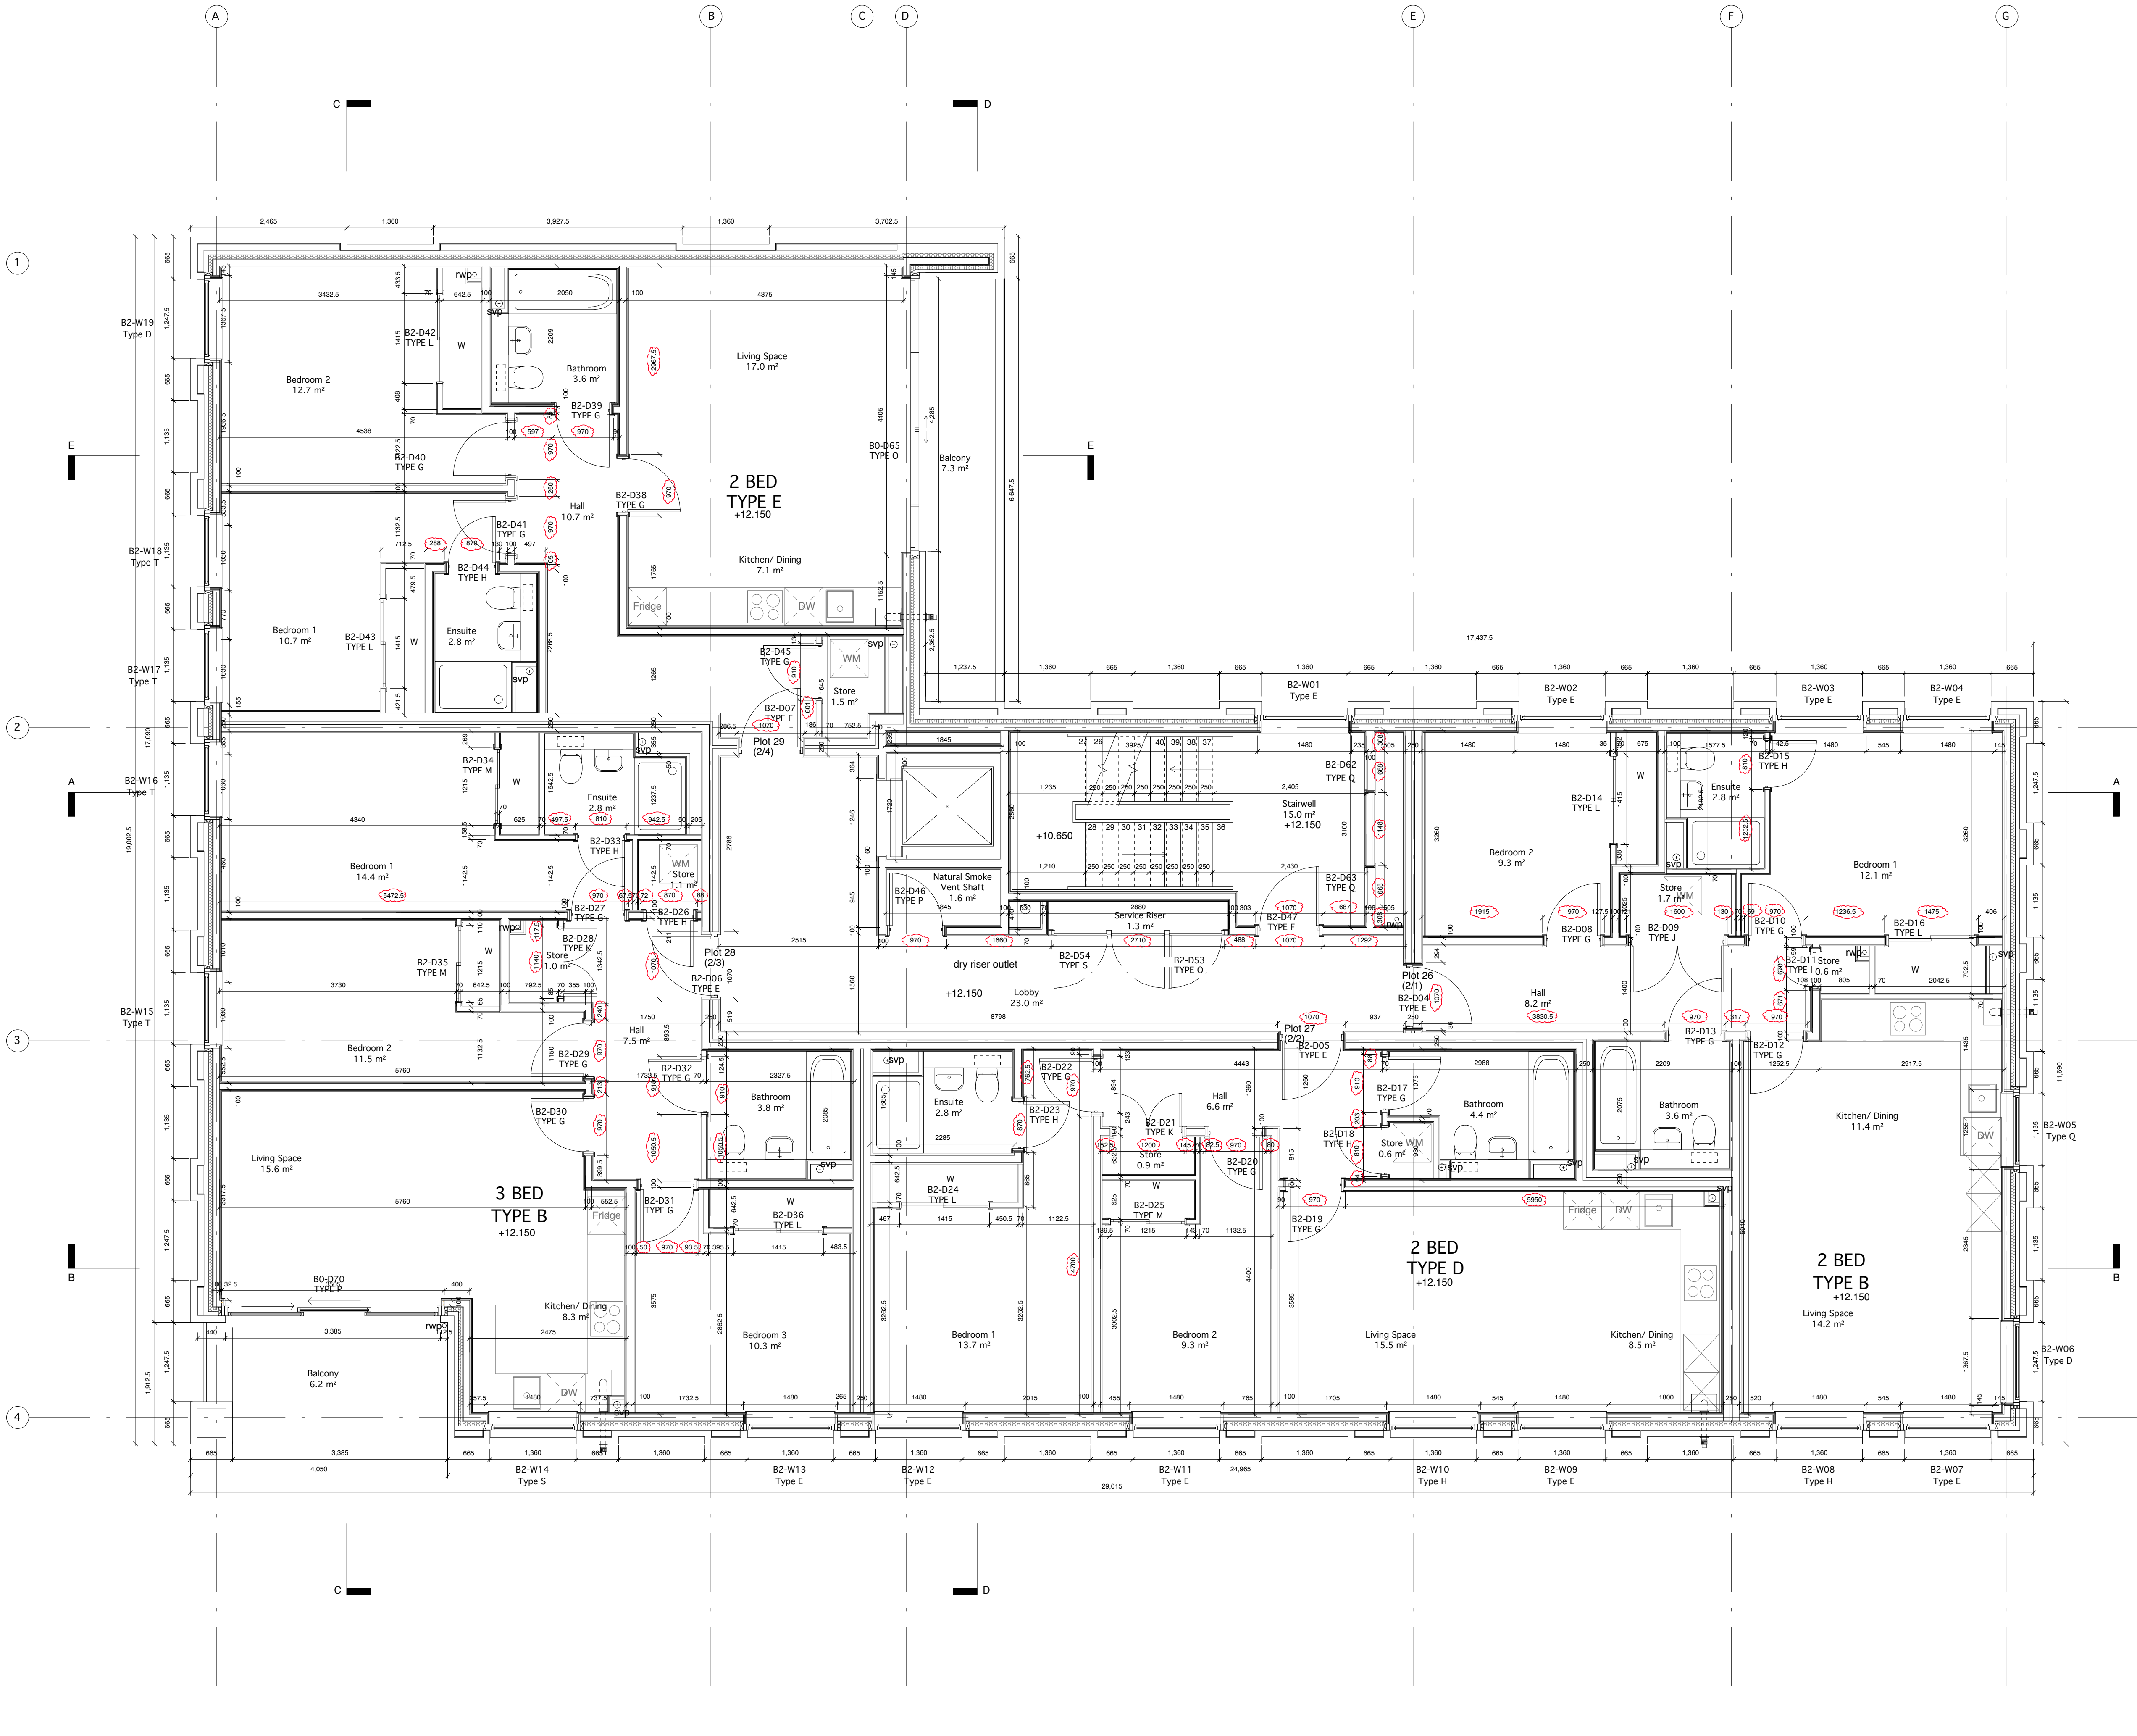

notes
This drawing is the copyright © property of Hypostyle Designs Ltd - no copying or distribution of this drawing or any part thereof is permitted without prior written permission.
Do not scale from this drawing. All existing dimensions to be checked on site prior to commencement of works or manufacturing of components.
Any discrepancies to be brought to the attention of the architect - if in doubt, ask.

S.H.E - safety health & environment information

1.
2.
3.

◊ - symbol indicates location & ref. no. of residual hazard/risk

Internal dimensions to steel frame
External dimensions to masonry

P15	Door opening dimensions altered to suit 33mm jambs	JA	MK	14.08.20
P14	SVP locations amended to respect NS clear zone	KC	KC	02.12.19
P13	Kitchens revised and SVP added as client request	KC	MK	21.11.19
P12	Kitchens revised as per client request, stair dimensions added, window sizes corrected, pier and sleework amended at large balcony in line with Block E	KC	MK	06.11.19
P11	Door dimensions revised, structural slab levels added, cavity resized, changed to monochrome, kitchen layouts added, window & door references, and section lines added	KC	MK	31.10.19
P10	Type B terrace doors, half brick rebate added, Type E Balcony opening width reduced to under 4400 as per balcony workshop discussion. Internal RWP positions amended following IKO workshop.	MK	MK	24.09.19
rev.	amendment	by	Checked	date

HYPO

STYLE

HYPOSTYLE Architects

www.hypostyle.co.uk

Glasgow 49 St. Vincent Crescent G3 8NG
T: 0141 204 4441 F: 0141 204 4897 E: glasgow@hypostyle.co.uk
Edinburgh 4 Sandport Place EH6 6EU
T: 0131 555 0888 F: 0131 553 4450 E: edinburgh@hypostyle.co.uk

client

client's ref

project

drawing

CALA Homes

Pacific Quay, Glasgow

Block B
Second Floor GA Plans

scale 1:50

page size A1

job ref 3693

date 08.08.19


drawing num 20_112

drawn KC

checked MK

date

rev P15

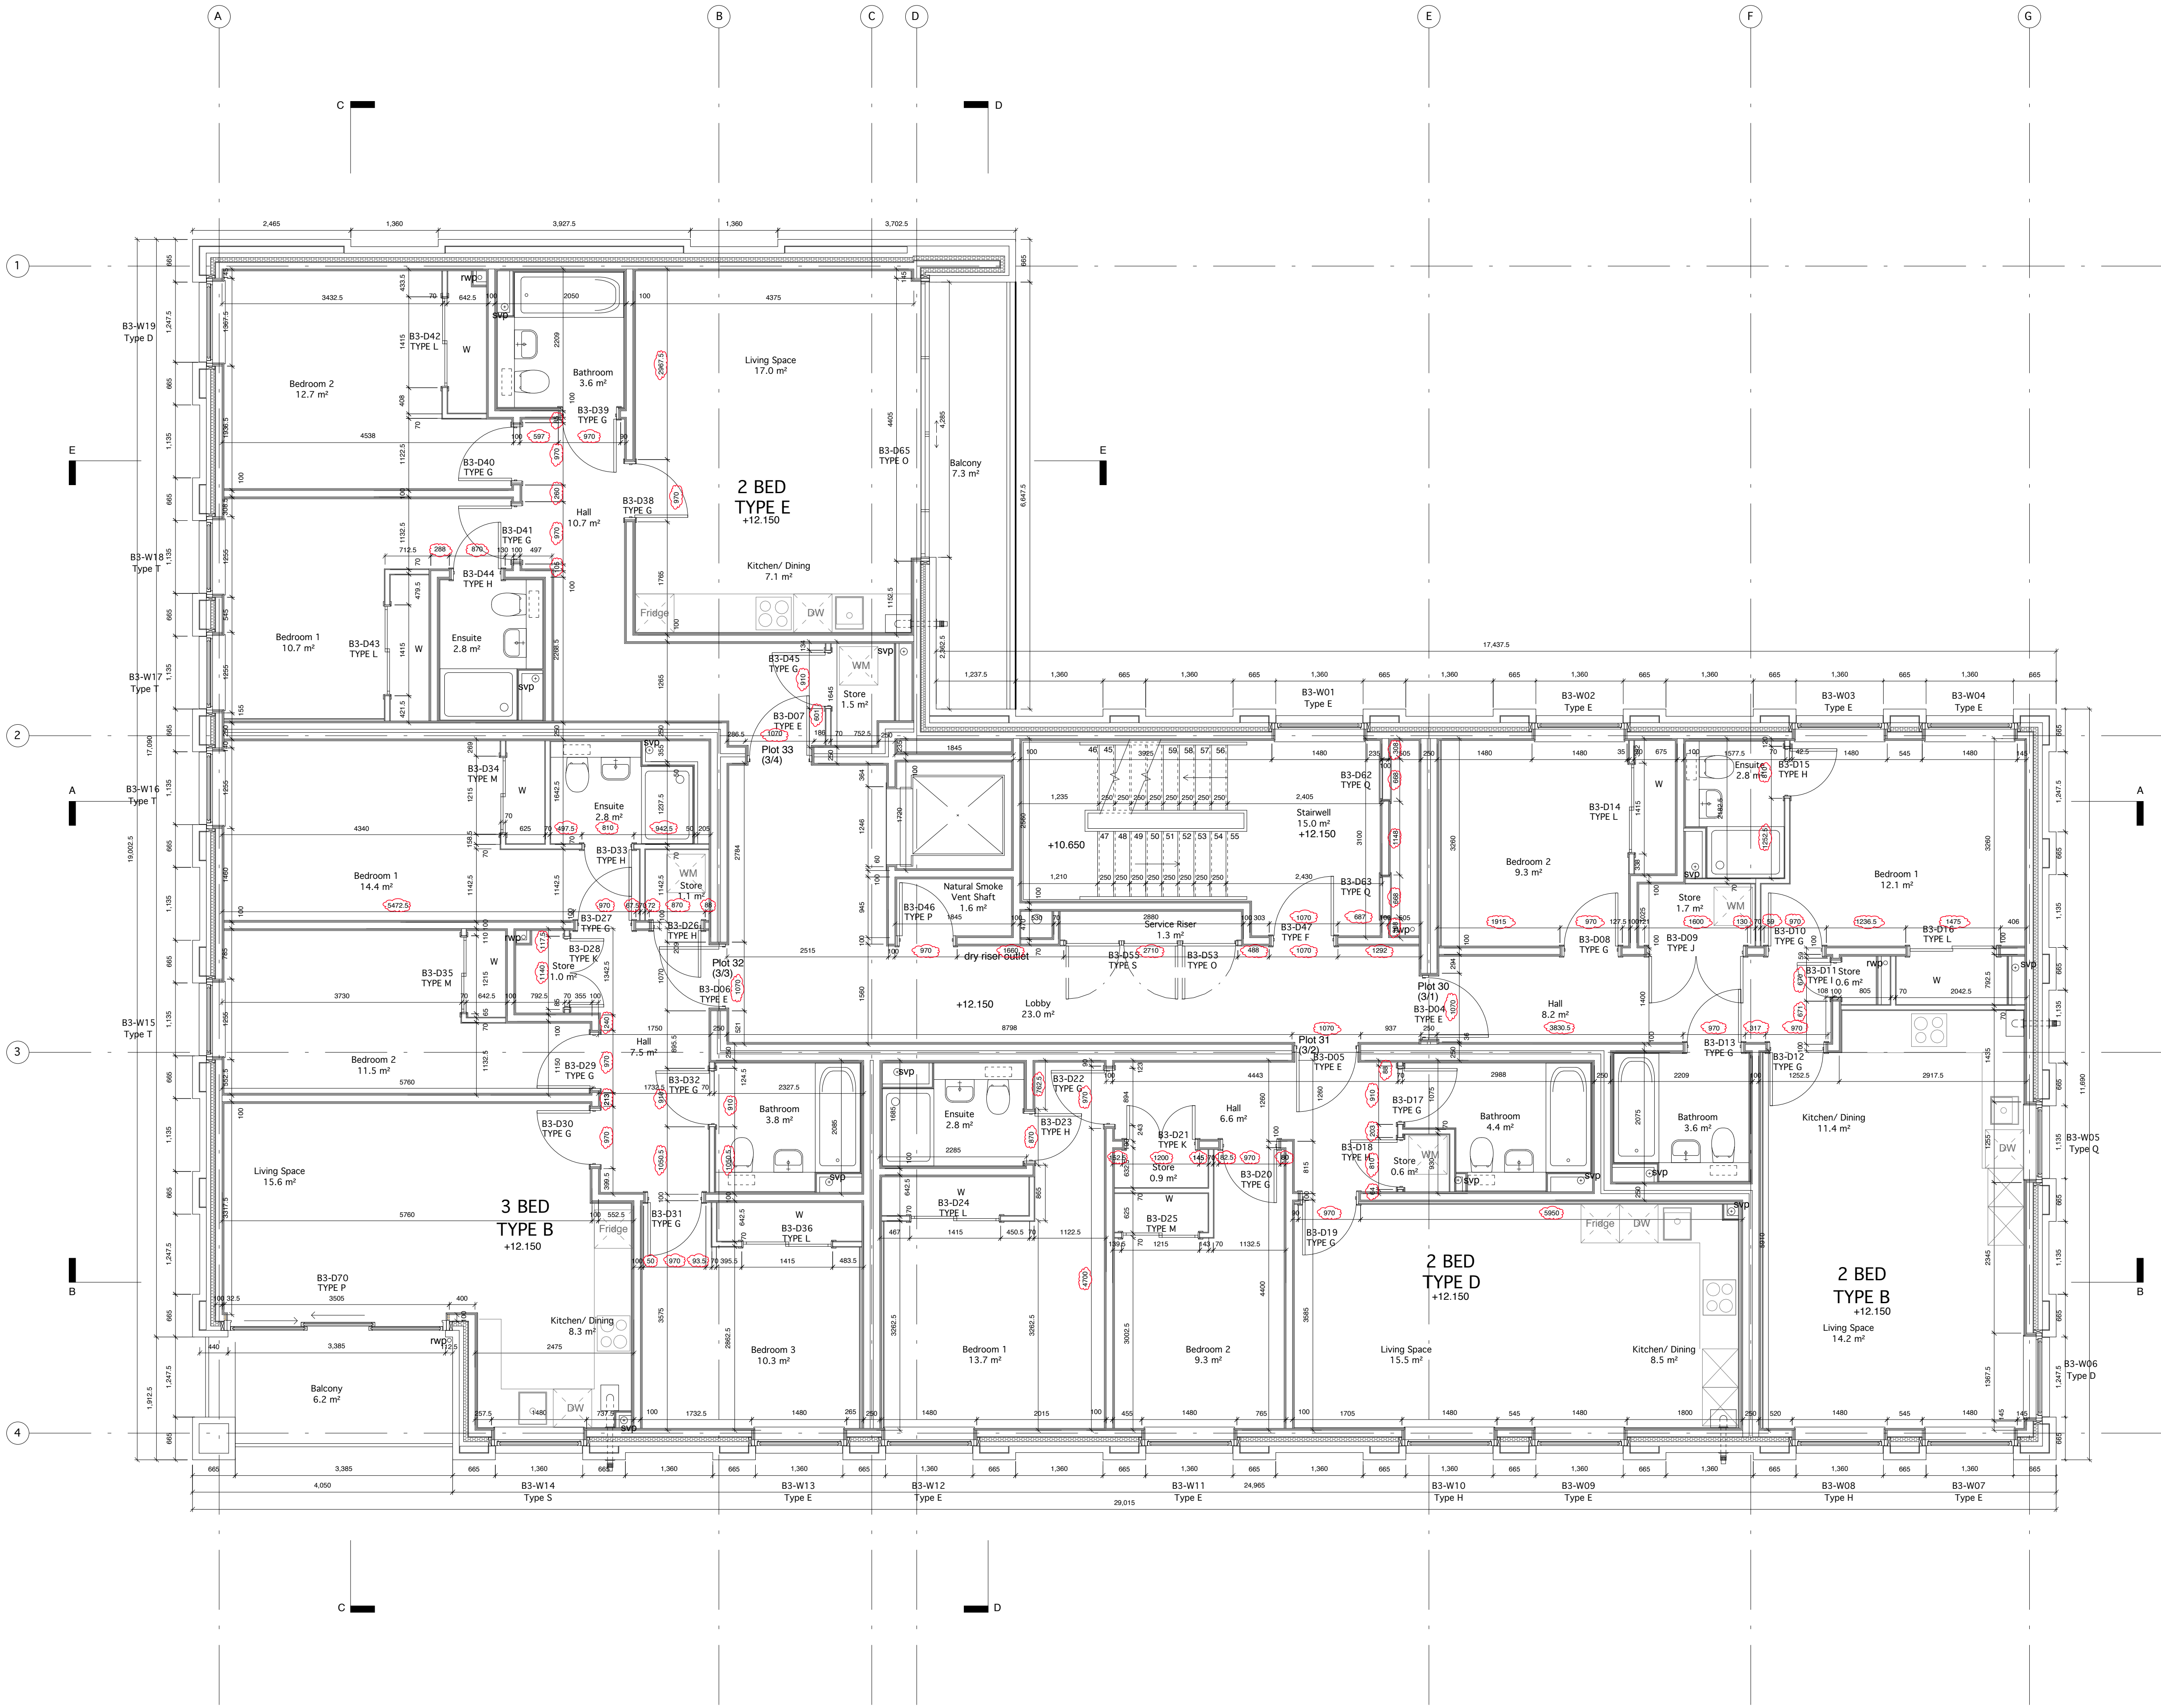

notes
This drawing is the copyright © property of Hypostyle Designs Ltd - no copying or distribution of this drawing or any part thereof is permitted without prior written permission.
Do not scale from this drawing. All existing dimensions to be checked on site prior to commencement of works or manufacturing of components.
Any discrepancies to be brought to the attention of the architect - if in doubt, ask.

S.H.E - safety health & environment information

1.
2.
3.

symbol indicates location & ref. no. of residual hazard/risk

Internal dimensions to steel frame
External dimensions to masonry

P15	Door opening dimensions altered to suit 33mm jambs	JA	MK	14.08.20
P14	SVP locations amended to respect NS clear zone	KC	MK	02.12.19
P13	Kitchens revised and SVP added as client request	KC	MK	21.11.19
P12	Kitchen revised as per client's request, stair dimensions added, windows corrected, steel revised in line with Block E	KC	MK	14.11.19
P11	Door dimensions revised, structural slab levels added, cavity resized, changed to monochrome, kitchen layouts added, window & door references, and section lines added	KC	MK	31.10.19
P10	Type B terrace doors, half brick rebate added, Type E Balcony opening width reduced to under 4400 as per balcony workshop discussion. Internal RWP positions amended following IKO workshop.	MK	MK	24.09.19
rev.	amendment	by	Checked	date

HYPO
STYLE

HYPOSTYLE Architects
www.hypostyle.co.uk

Glasgow

49 St. Vincent Crescent G3 8NG

T: 0141 204 4441 F: 0141 204 4897 E: glasgow@hypostyle.co.uk

Edinburgh

4 Sandport Place EH6 6EU

T: 0131 555 0888 F: 0131 553 4450 E: edinburgh@hypostyle.co.uk

client

CALA Homes

client's ref

project

Pacific Quay, Glasgow

drawing

Block B
Third Floor GA Plans

scale 1:50

page size A1

job ref 3693

drawn KC

date 08.08.19


drawing num 20_113

checked MK

date

rev P15

For Construction

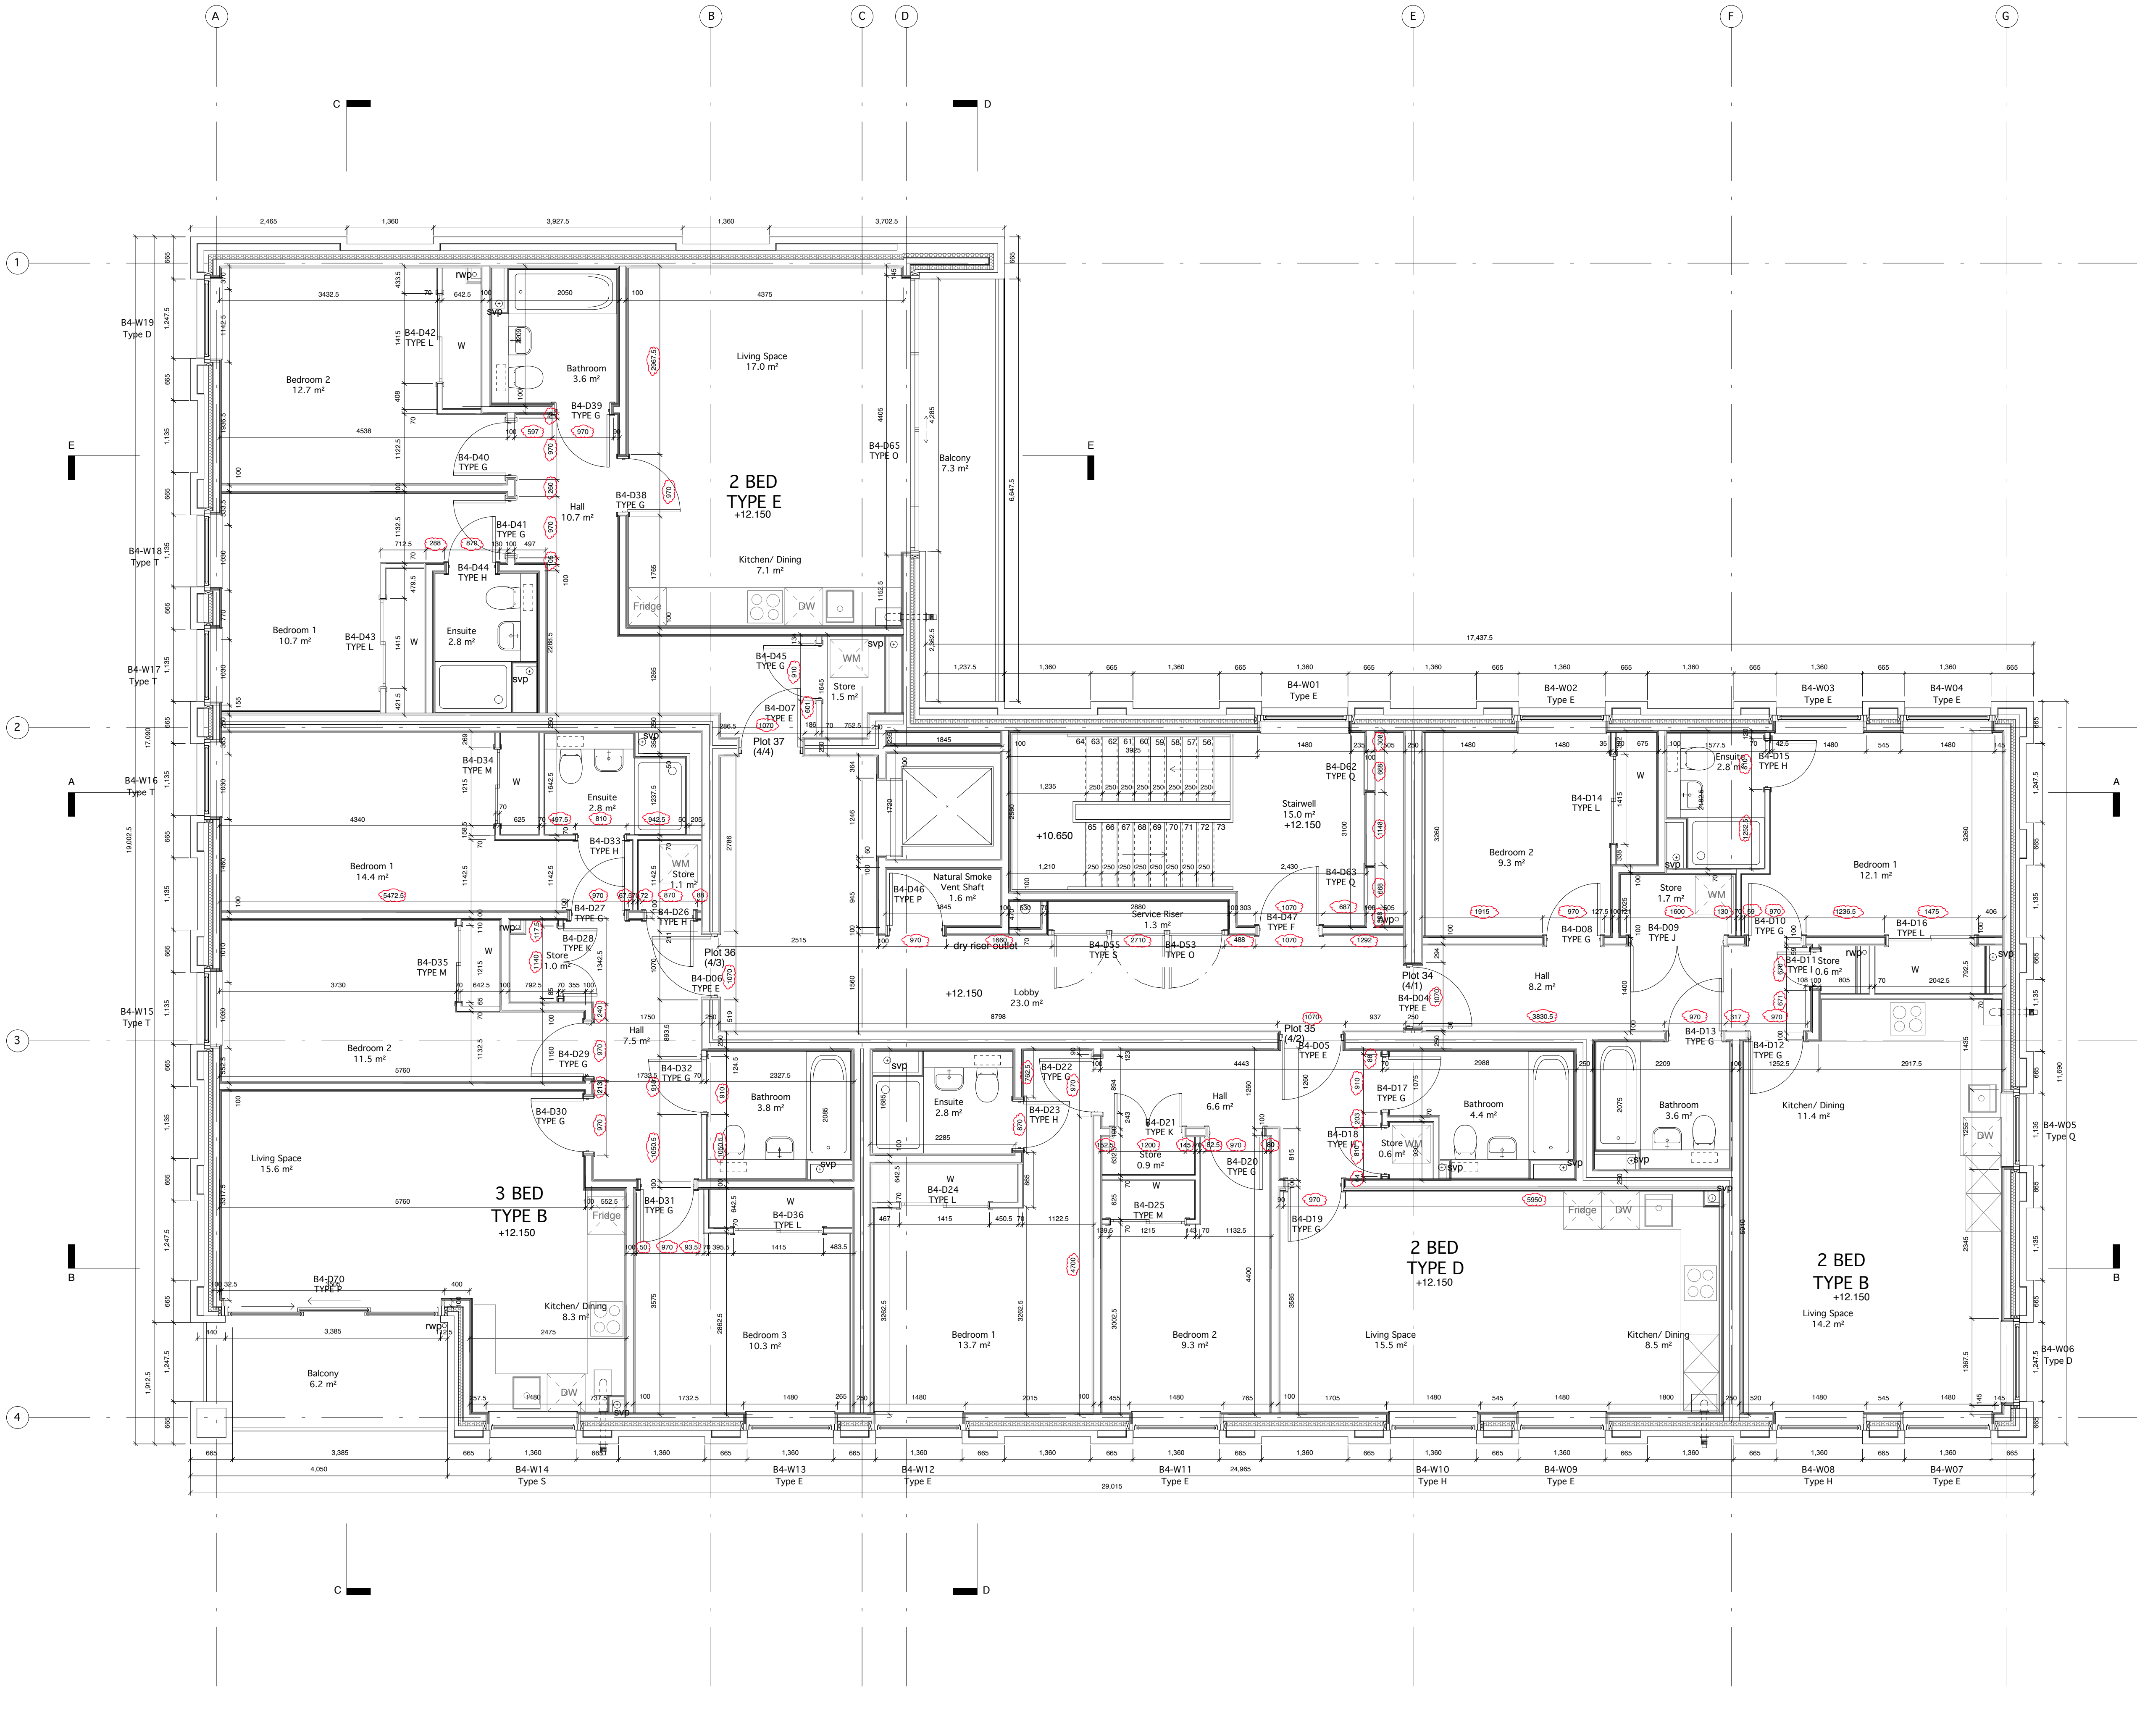

notes
This drawing is the copyright © property of Hypostyle Designs Ltd - no copying or distribution of this drawing or any part thereof is permitted without prior written permission.
Do not scale from this drawing. All existing dimensions to be checked on site prior to commencement of works or manufacturing of components.
Any discrepancies to be brought to the attention of the architect - if in doubt, ask.

S.H.E - safety health & environment information

1.
2.
3.

◊ - symbol indicates location & ref. no. of residual hazard/risk

Internal dimensions to steel frame
External dimensions to masonry

P15	Door opening dimensions altered to suit 33mm jambs	JA	KC	KC	14.08.20
P14	SVP locations amended to respect NS clear zone	KC	KC	KC	02.12.19
P13	Kitchens revised and SVP added as client request	KC	KC	MK	21.11.19
P12	Kitchen revised as per client request, stair dimensions added, windows corrected, pier and steel at large balcony amended in line with Block E	KC	KC	MK	06.11.19
P11	Door dimensions revised, structural slab levels added, cavity resized, changed to monochrome, kitchen layouts added, window & door references, and section lines added	KC	KC	MK	31.10.19
P10	Type B terrace doors, half brick rebate added. Type E Balcony opening width reduced to under 4400 as per balcony workshop discussion. Internal RWP positions amended following IKO workshop.	MK	MK	MK	24.09.19
rev.	amendment	by	Checked	date	

HYPO
STYLE

HYPOSTYLE Architects
www.hypostyle.co.uk

Glasgow

49 St. Vincent Crescent G3 8NG

T: 0141 204 4441 F: 0141 204 4897 E: glasgow@hypostyle.co.uk

Edinburgh

4 Sandport Place EH6 6EU

T: 0131 555 0888 F: 0131 553 4450 E: edinburgh@hypostyle.co.uk

client

CALA Homes

client's ref

project

**Pacific Quay,
Glasgow**

drawing

**Block B
Fourth Floor GA Plans**

scale 1:50

page size A1

date 08.08.19

job ref 3693

drawing num 20_114

checked MK

date

rev P15


notes
This drawing is the copyright © property of Hypostyle Designs Ltd - no copying or distribution of this drawing or any part thereof is permitted without prior written permission.
Do not scale from this drawing. All existing dimensions to be checked on site prior to commencement of works or manufacturing of components.
Any discrepancies to be brought to the attention of the architect - if in doubt, ask.

S.H.E - safety health & environment information

- 1.
- 2.
- 3.

symbol indicates location & ref. no. of residual hazard/risk

Refer to engineering drawings for setting out of steelwork.

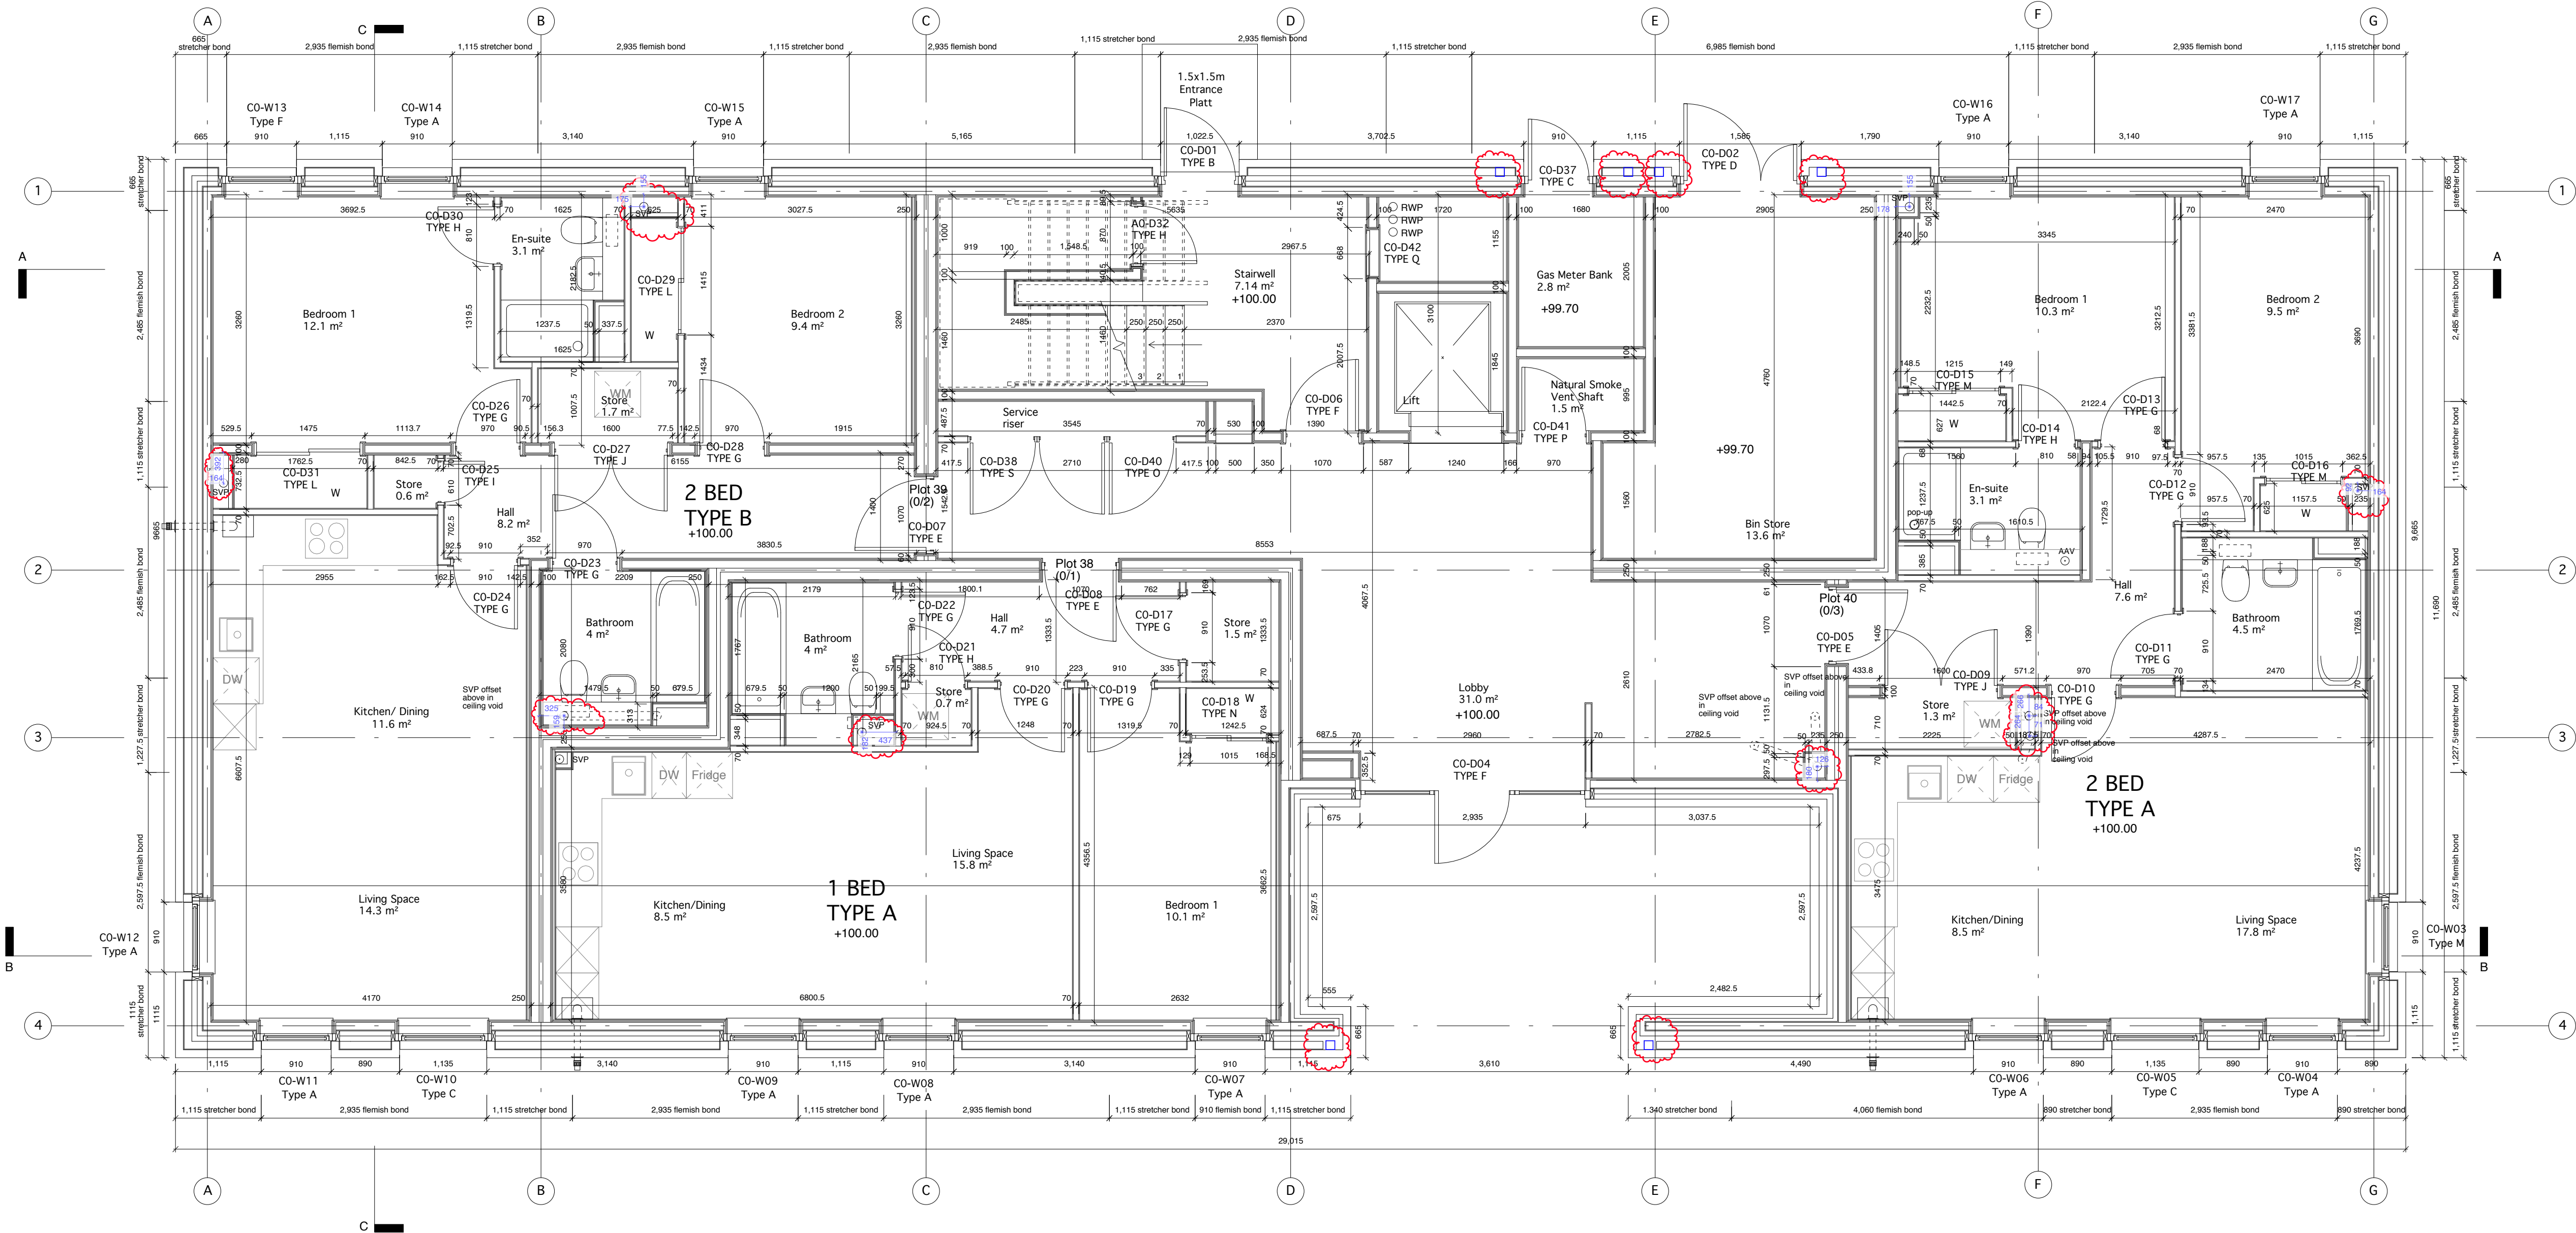

P22	Fill added to svp dims for clarity. Eng steelwork amended as per engineers drawing.	MK	MK	03.12.20
P21	Dims added to SVPs	MK	MK	08.10.20
P20	SVP positions revised. Offsets noted from above in ceiling void only.	JG	JG	04.09.20
P19	Door opening dimensions altered to suit 33mm jambs	JA	MK	14.08.20
P18	Store arrangement under stair altered	JG	JG	17.06.20
P17	Bathroom, en-suite and SVP arrangement altered at client's request	JA	MK	07.05.20
P16	Stair arrangement altered, door type CO-D32 changed from G to H	JA	JG	09.03.20
P15	Floor levels to bin store and stair altered, 4 No. risers removed, external door to stairwell moved, door to under stair cupboard moved, entrance opening reduced in width. Coalposts added. Window 'CO-W12' position corrected to reflect elevations flemish bond adjusted	JG	JG	20.02.20
P14	SVP locations revised and offsets shown, entrance door revised	KC	KC	04.12.19
P13	Kitchen layouts revised, SVPs added at client request	KC	MK	22.11.19
P12	Kitchen revised as per client request, stair dimensions added, sanitaryware shown, rwps relocated	KC	MK	06.11.19
P11	SVP and RWPs relocated	KC	MK	07.10.19
rev.	amendment	by	Checked	date

HYPO
STYLE

HYPOSTYLE Architects
www.hypostyle.co.uk

Glasgow 49 St. Vincent Crescent G3 8NG
T: 0141 204 4441 F: 0141 204 4897 E: glasgow@hypostyle.co.uk
Edinburgh 4 Sandport Place EH6 6EU
T: 0131 555 0888 F: 0131 553 4450 E: edinburgh@hypostyle.co.uk

client

CALA Homes

client's ref

project

Pacific Quay,

Glasgow

drawing

Block C

Ground Floor GA Plan

scale 1:50

page size A1

drawn KC

checked MK

date 08.08.19

date

job ref

drawing num


rev


3693

20_120

P22

For Construction

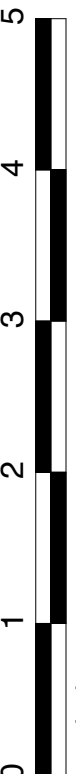

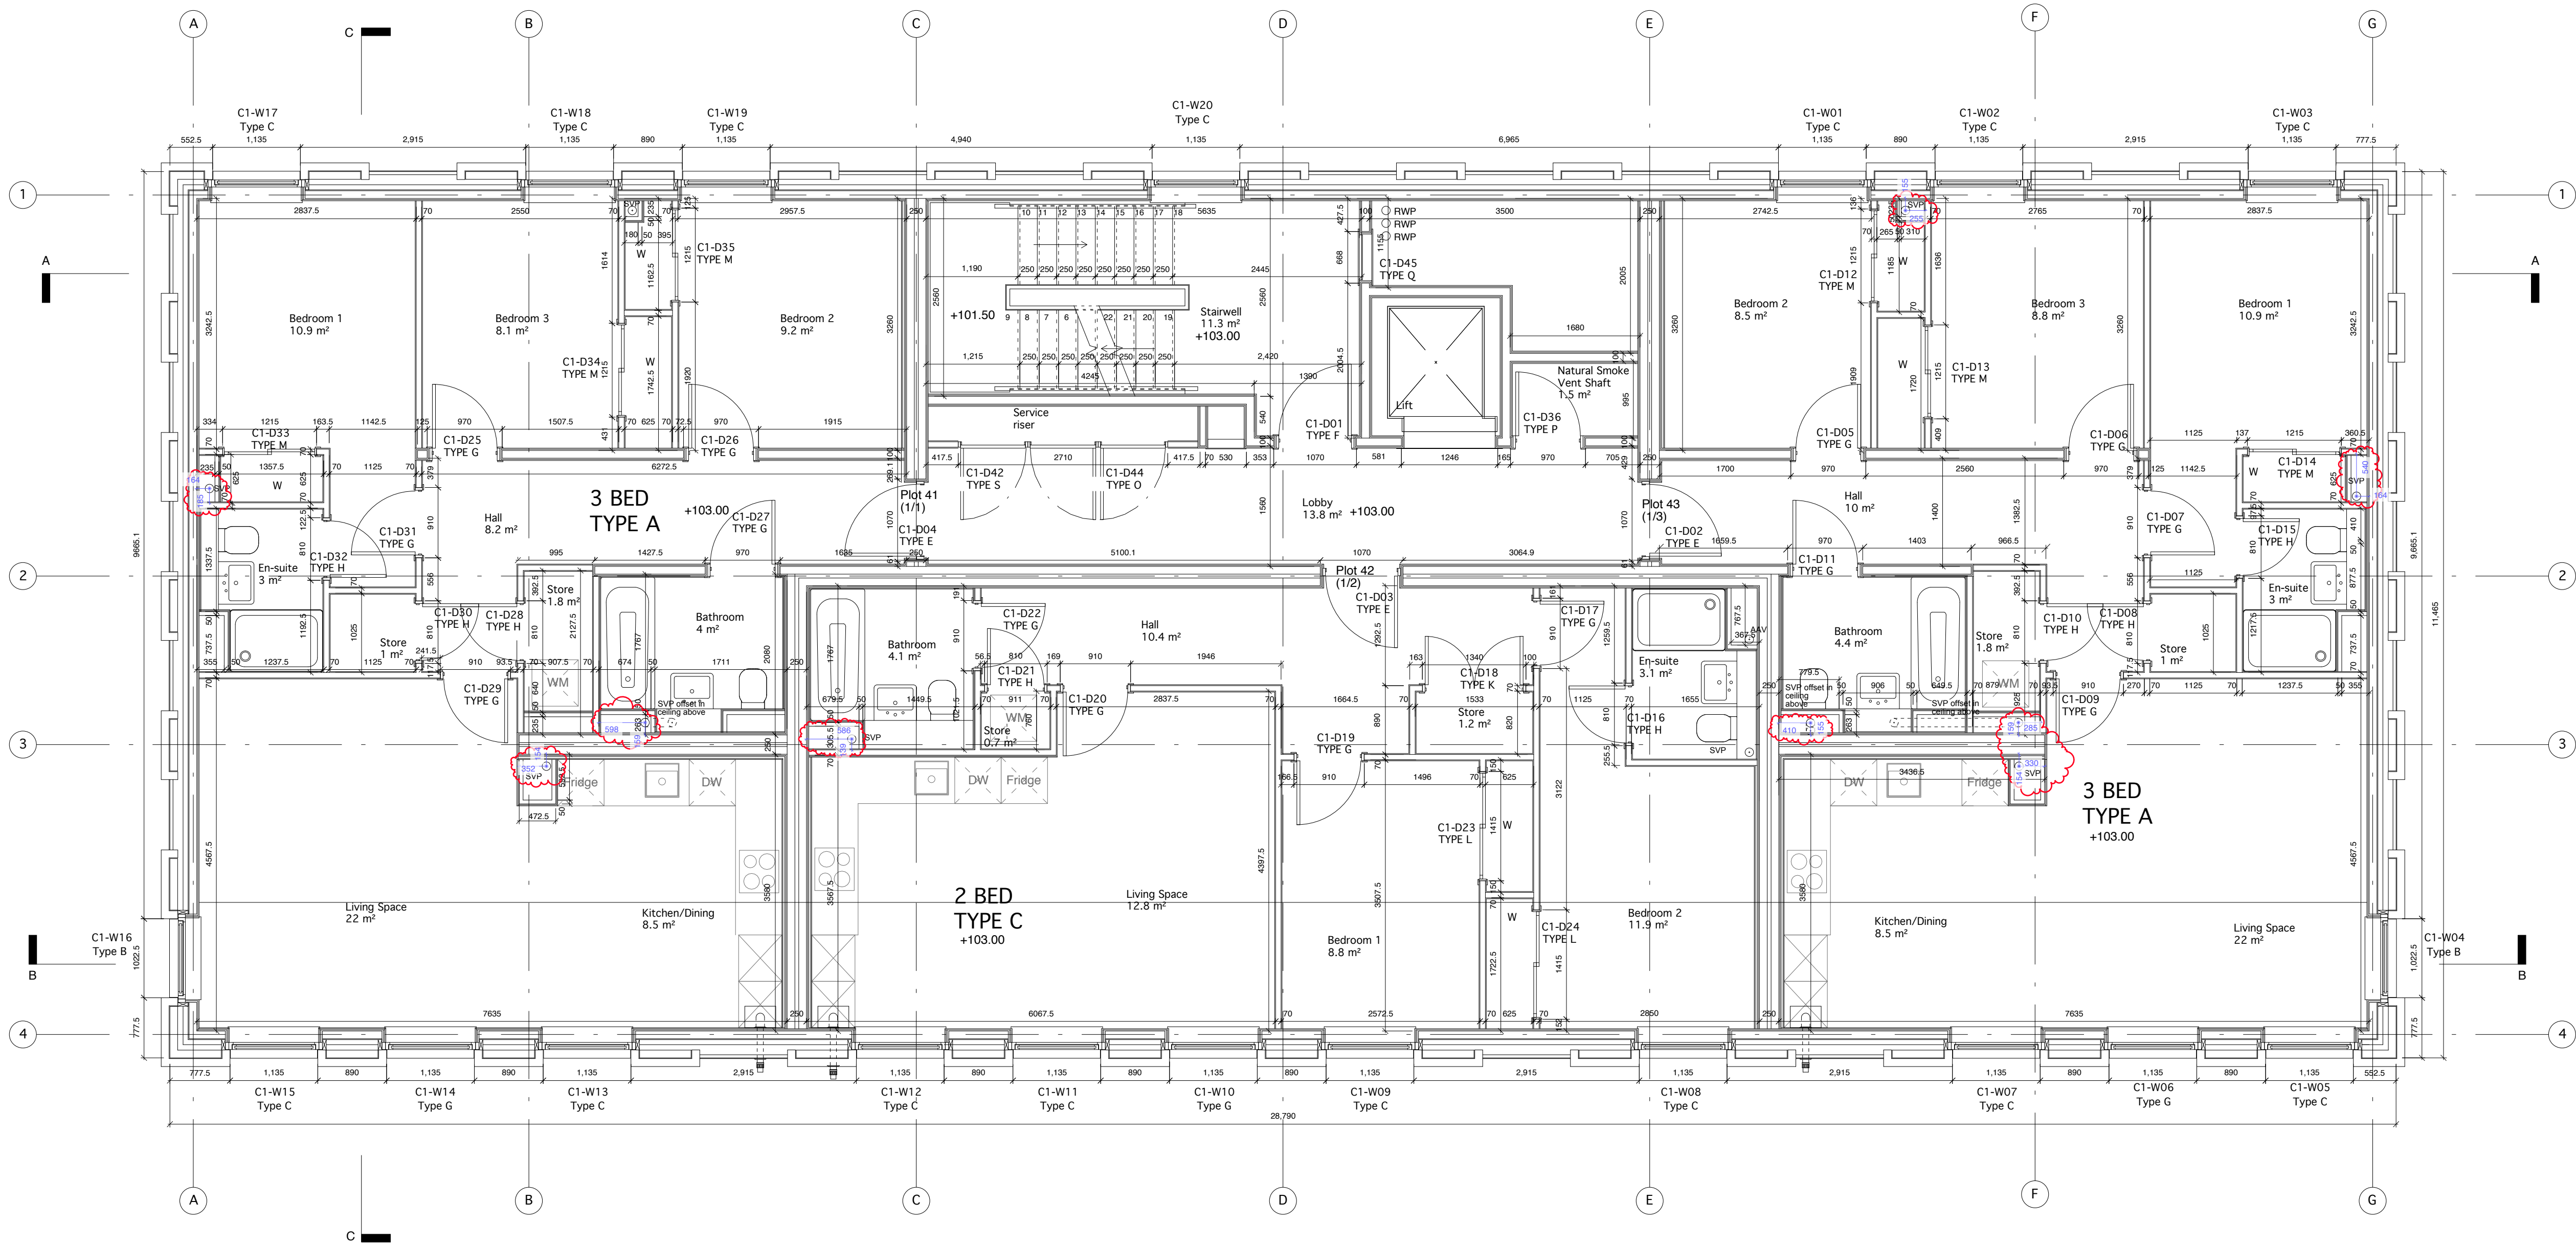

notes

This drawing is the copyright © property of Hypostyle Designs Ltd - no copying or distribution of this drawing or any part thereof is permitted without prior written permission.

Do not scale from this drawing. All existing dimensions to be checked on site prior to commencement of works or manufacturing of components.

Any discrepancies to be brought to the attention of the architect - if in doubt, ask.

S.H.E - safety health & environment information

1.

2.

3.

symbol indicates location & ref. no. of residual hazard/risk

Internal dimensions to steel frame
External dimensions to masonry

P21	Fill added to SVP for clarity. Boxing in 3 Bed Type A, amended as per Block D	MK	MK	03.12.20
P20	SVP dimensions added.	MK	MK	08.10.20
P19	SVP offsets noted as from above in ceiling void. SVP shown in en-suite, 2 Bed Type C to match HB	JG	JG	04.09.20
P18	Door opening dimensions altered to suit 33mm jambs	JA	MK	14.08.20
P17	SVP arrangement altered boxing behind WC extended and WC centred at client's request	JA	MK	07.05.20
P16	Stairs arrangement altered	JA	JA	05.03.20
P15	Window 'C1-W16' position corrected to reflect elevations, stair numbering corrected as a result of 4 omitted stairs from lower ground level	JA	JA	26.02.20
P14	SVP locations amended to respect NS clear zone. SVP offsets shown	KC	KC	04.12.19
P13	Kitchen layouts revised, SVPs added at client request	KC	MK	22.11.19
P12	framing out revised, stair dimensions added, rwp's relocated	KC	MK	06.11.19
P11	SVP and RWPs relocated	KC	MK	07.10.19
rev.	amendment	by	Checked	date

HYPO
STYLE

HYPOSTYLE Architects
www.hypostyle.co.uk

Glasgow 49 St. Vincent Crescent G3 8NG
T: 0141 204 4441 F: 0141 204 4897 E: glasgow@hypostyle.co.uk
Edinburgh 4 Sandport Place EH6 6EU
T: 0131 555 0888 F: 0131 553 4450 E: edinburgh@hypostyle.co.uk

client

CALA Homes

client's ref

project

**Pacific Quay,
Glasgow**

drawing

**Block C
First Floor GA Plan**

scale 1:50

page size A1

drawn KC

checked MK

job ref

drawing num


rev

3693

20_121

P21

For Construction

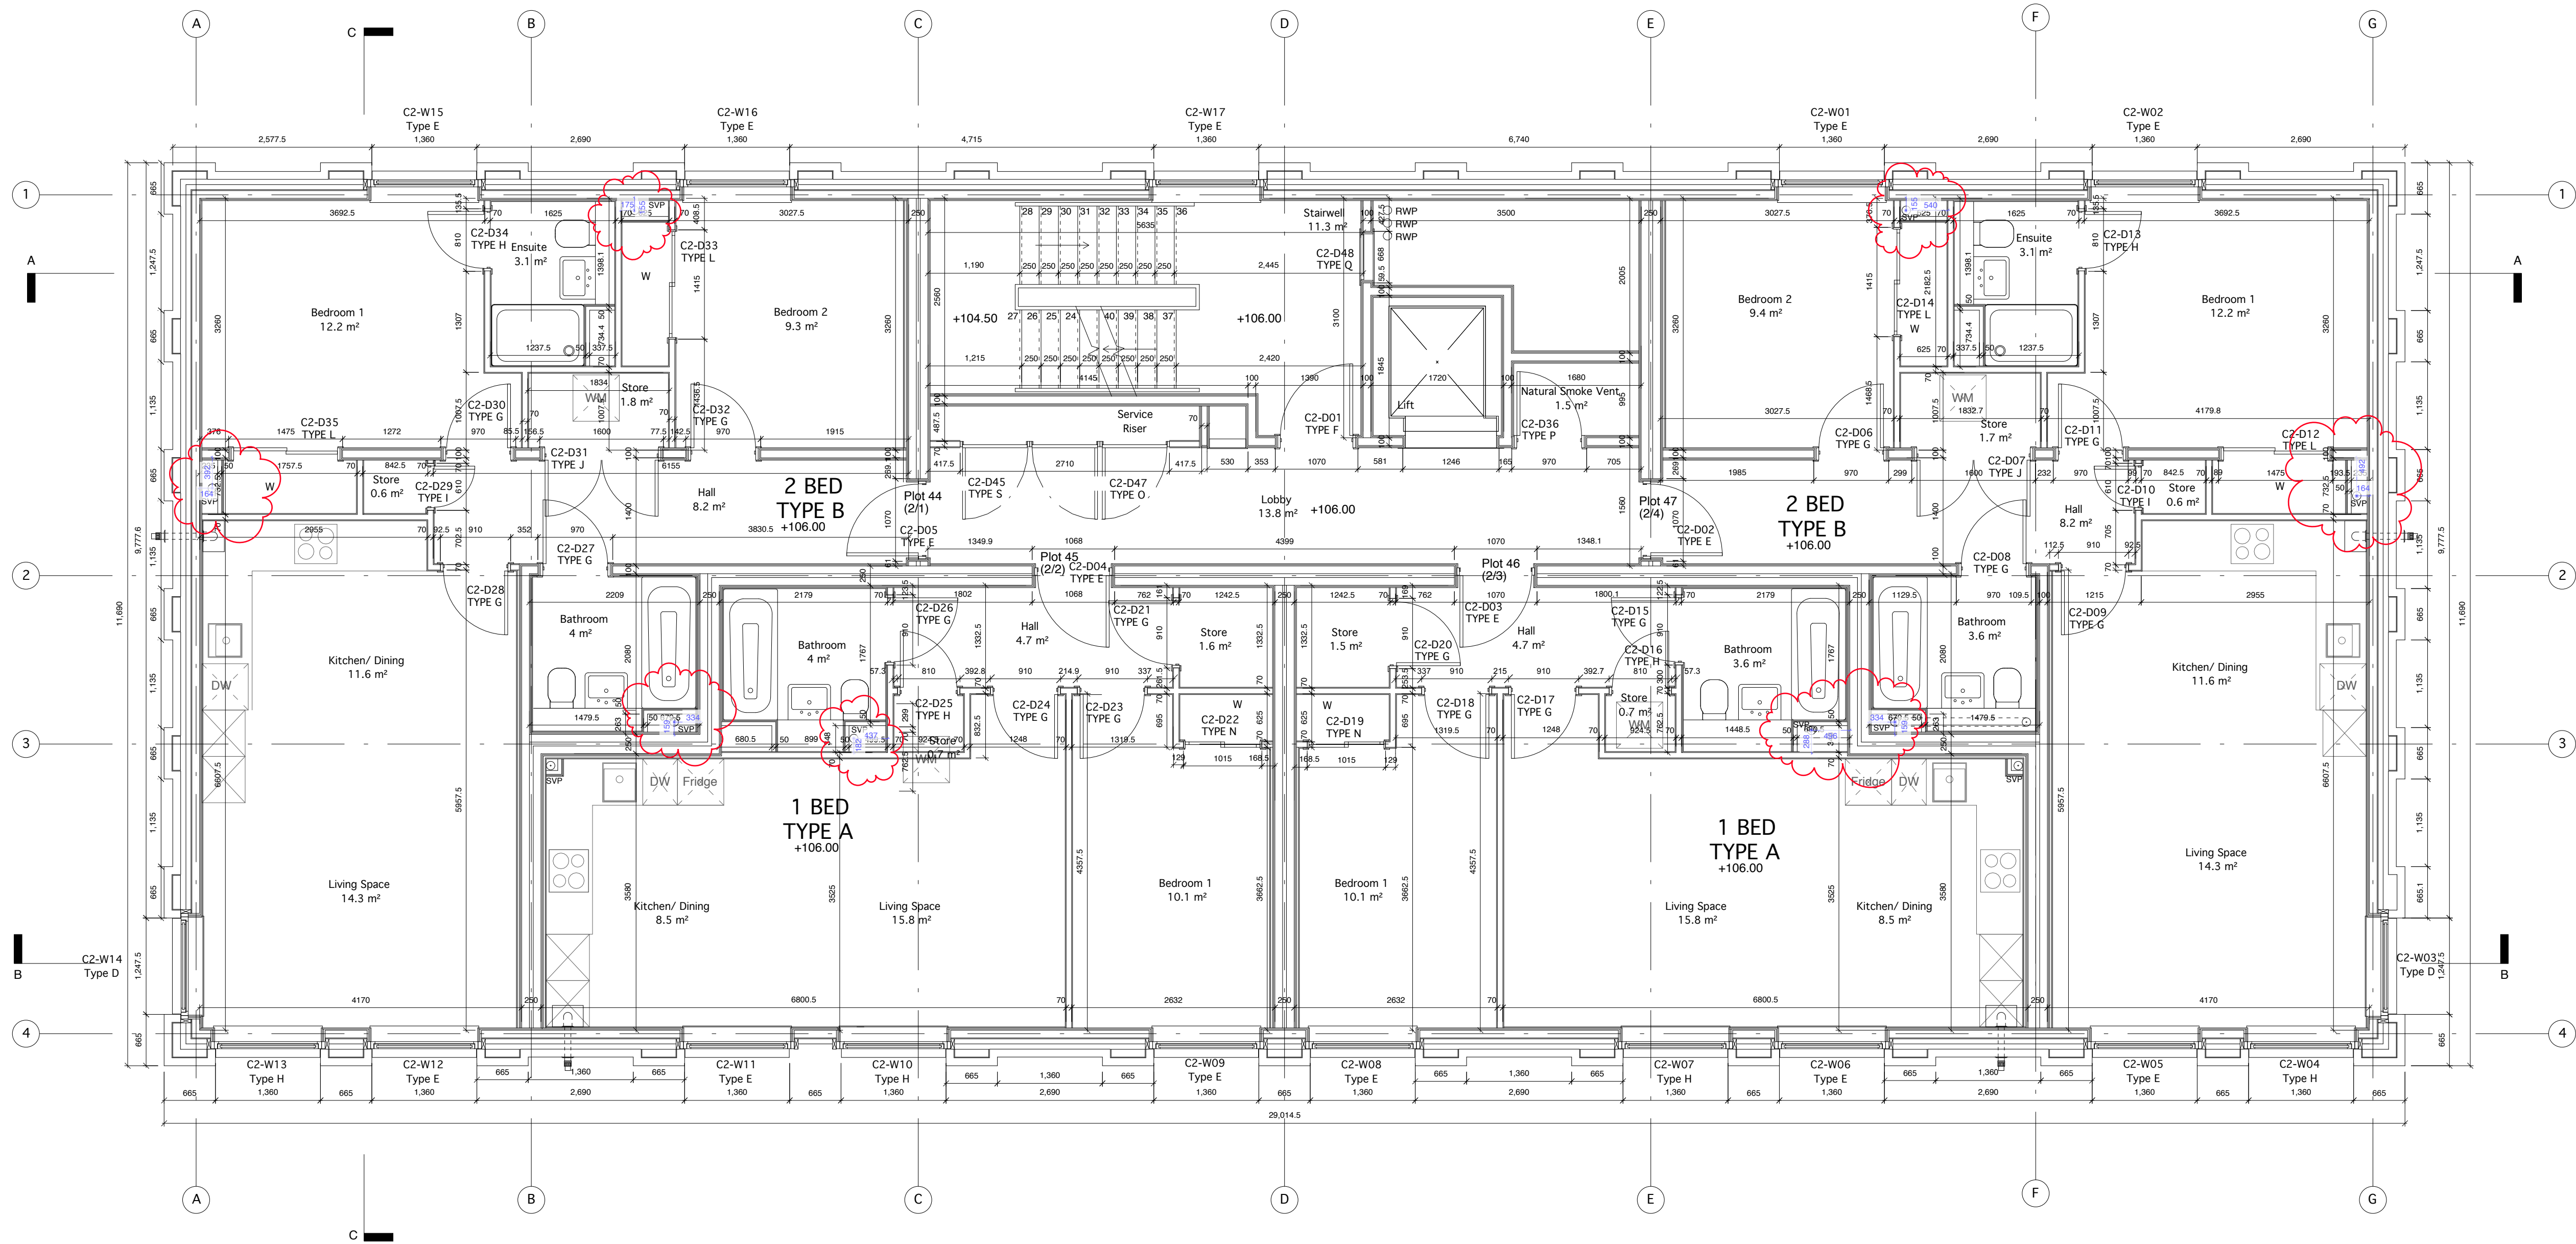

notes
This drawing is the copyright © property of Hypostyle Designs Ltd - no copying or distribution of this drawing or any part thereof is permitted without prior written permission.
Do not scale from this drawing. All existing dimensions to be checked on site prior to commencement of works or manufacturing of components.
Any discrepancies to be brought to the attention of the architect - if in doubt, ask.

- S.H.E - safety health & environment information
- 1.
 - 2.
 - 3.

◊ - symbol indicates location & ref. no. of residual hazard/risk

Internal dimensions to steel frame
External dimensions to masonry

P20	Fill added to SVP dimensions for clarity	MK	MK	03.12.20
P19	SVP dimensions added.	MK	MK	08.10.20
P18	Minor adjustments to SVP locations to match below	JG	JG	04.09.20
P17	Door opening dimensions altered to suit 33mm jamb	JA	MK	07.05.20
P16	Bathroom, en-suite and SVP arrangement altered at clients request	JA	MK	07.05.20
P15	Stair numbering corrected as a result of 4 omitted stairs from lower ground level	JA	JA	28.02.20
P14	SVP locations simplified and amended to respect NS clear zone, SVP offsets added, bathroom/en-suite layouts mirrored	KC	KC	04.12.19
P13	Kitchen layouts revised, SVPs added at client request	KC	MK	22.11.19
P12	Kitchen revised as per client request, stair dimensions added, tvps relocated	KC	MK	07.10.19
P11	SVP and RWP's relocated	KC	MK	07.10.19
rev.	amendment	by	Checked	date

HYPO
STYLE

HYPOSTYLE Architects
www.hypostyle.co.uk

Glasgow 49 St. Vincent Crescent G3 8NG
T: 0141 204 4441 F: 0141 204 4897 E: glasgow@hypostyle.co.uk
Edinburgh 4 Sandport Place EH6 6EU
T: 0131 555 0888 F: 0131 553 4450 E: edinburgh@hypostyle.co.uk

client

CALA Homes

client's ref

project

**Pacific Quay,
Glasgow**

drawing

**Block C
Second Floor GA Plan**

scale 1:50

page size A1

date 08.08.19

checked MK

date

job ref

drawing num


rev


3693

20_122

P20

For Construction

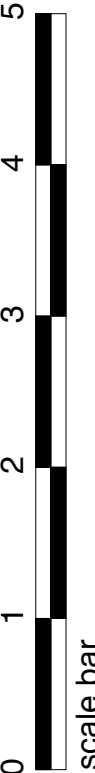

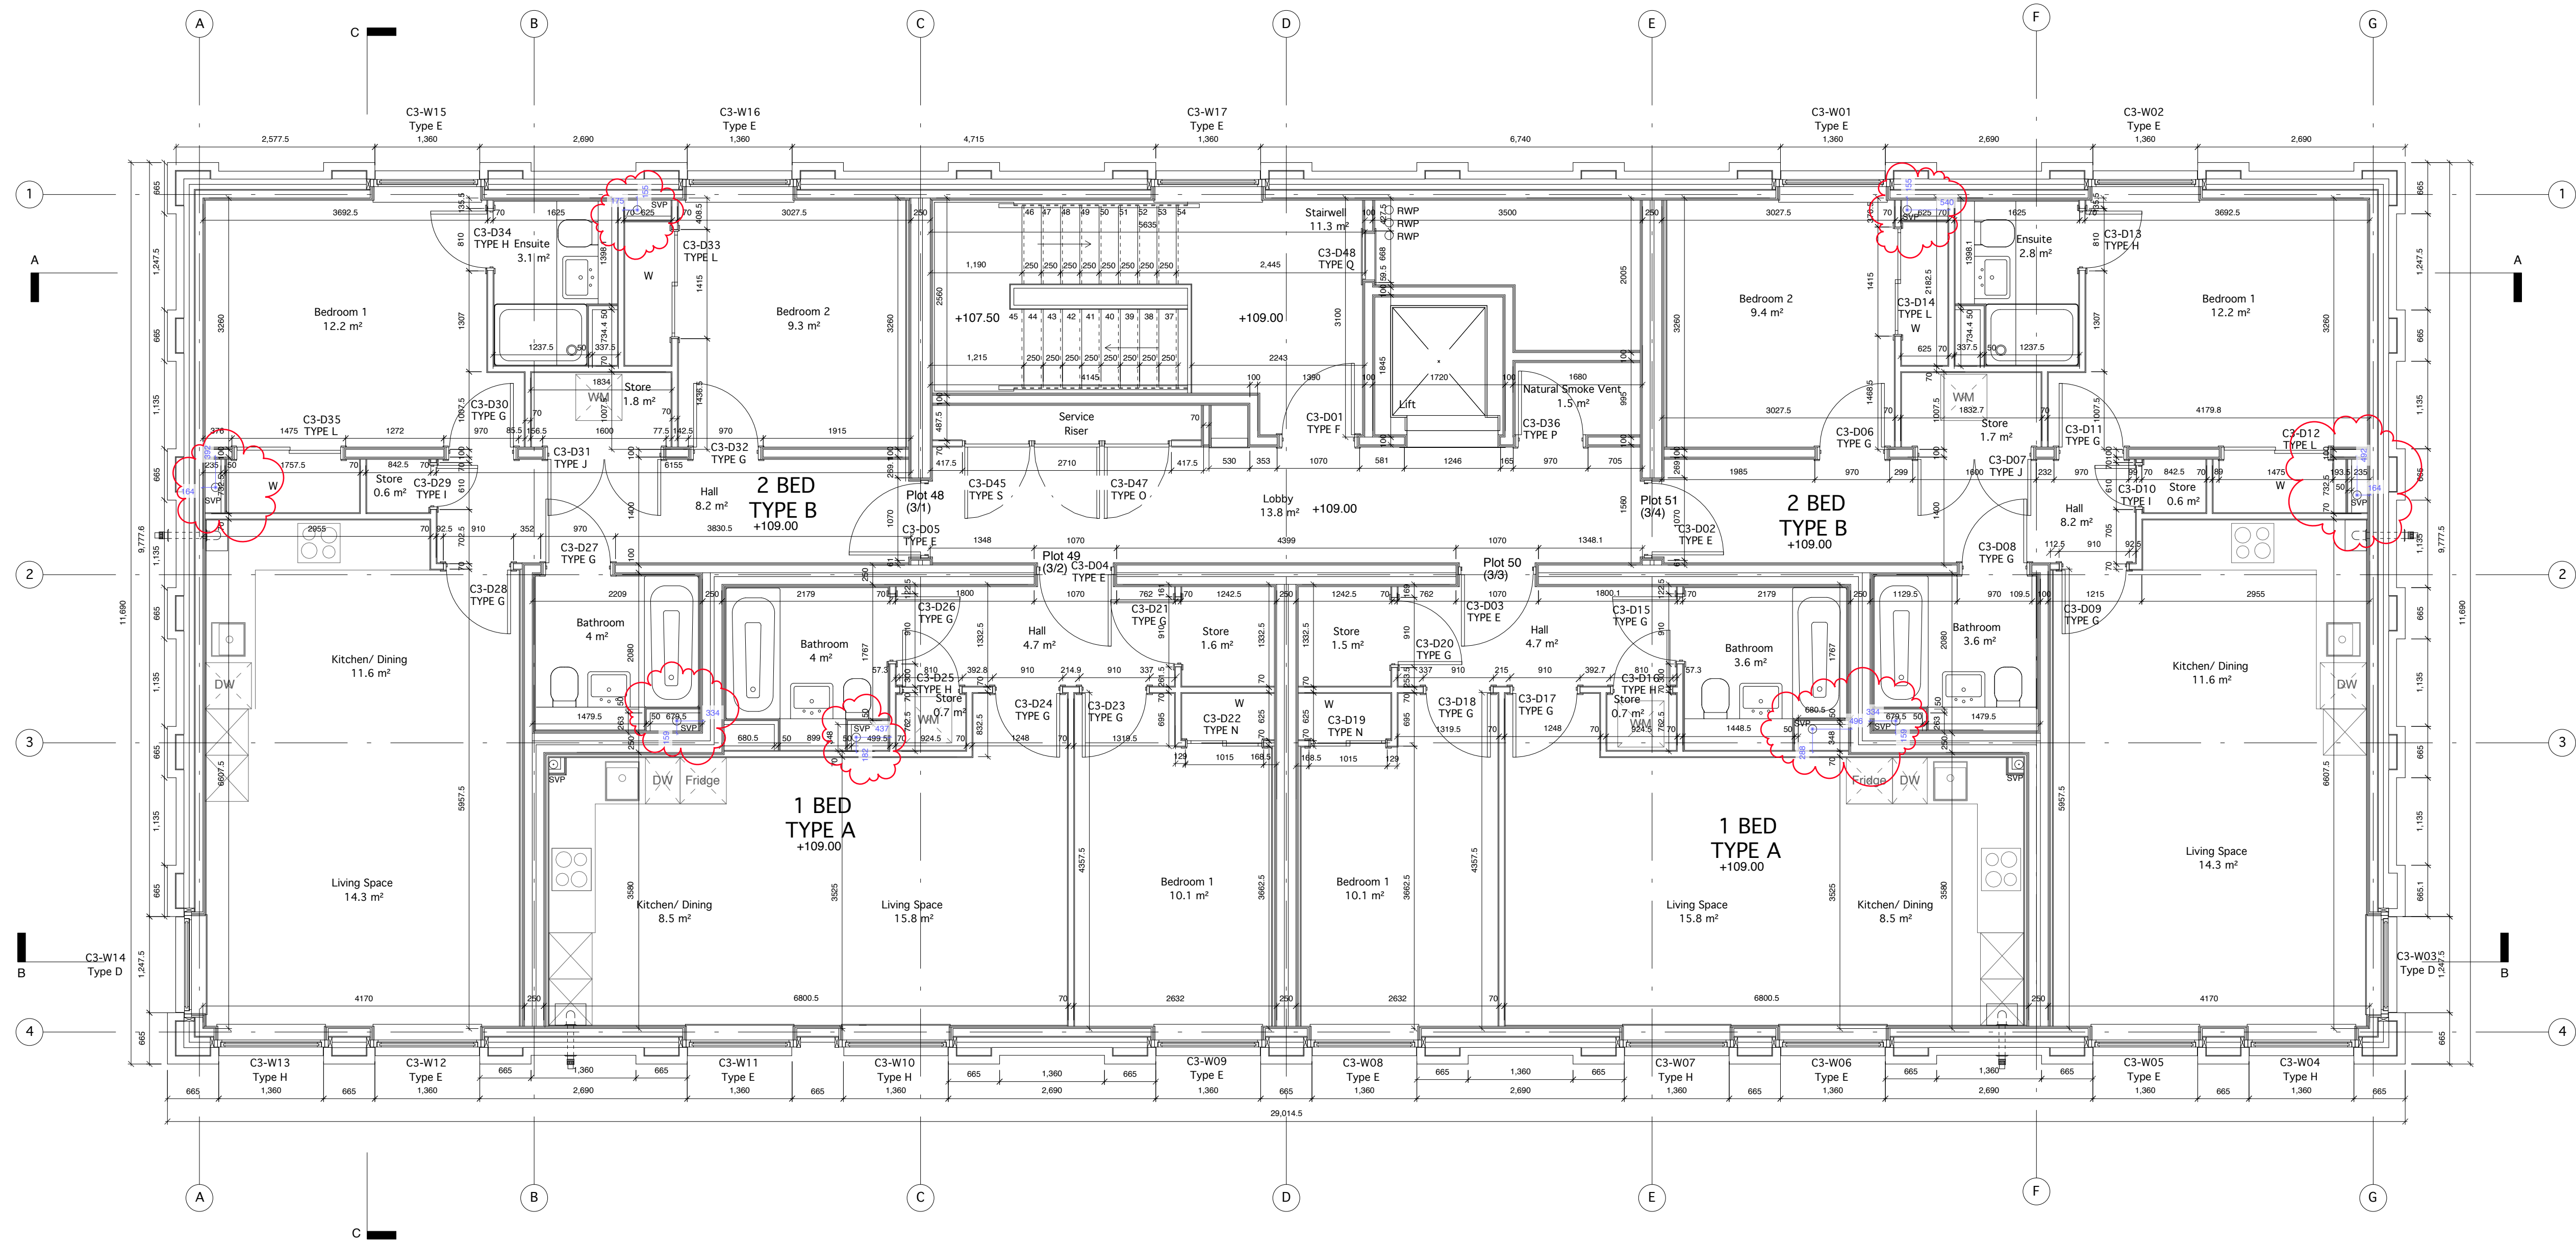

notes
This drawing is the copyright © property of Hypostyle Designs Ltd - no copying or distribution of this drawing or any part thereof is permitted without prior written permission.
Do not scale from this drawing. All existing dimensions to be checked on site prior to commencement of works or manufacturing of components.
Any discrepancies to be brought to the attention of the architect - if in doubt, ask.

S.H.E - safety health & environment information

1.
2.
3.

◊ - symbol indicates location & ref. no. of residual hazard/risk

Internal dimensions to steel frame
External dimensions to masonry

P20	Fill added to SVP dimensions for clarity	MK	MK	03.12.20
P19	SVP dimensions added.	MK	MK	08.10.20
P18	SVP offsets noted as above only. Offset below notation removed	JG	JG	04.09.20
P17	Door opening dimensions altered to suit 33mm jambs	JA	MK	14.08.20
P16	Bathroom, en-suite and SVP arrangement altered at client's request	JA	MK	07.05.20
P15	Stairs corrected	JA	JA	05.03.20
P14	SVP locations simplified and amended to respect NS clear zone, SVP offsets added, bathroom/en-suite layouts mirrored	KC	KC	04.12.19
P13	Kitchen layouts revised, SVPs added at client request	KC	MK	22.11.19
P12	Kitchen revised as per client request, stair dimensions added, tvps relocated	KC	MK	07.10.19
P11	SVP and RWP's relocated	KC	MK	07.10.19
rev.	amendment	by	Checked	date

HYPO
STYLE

HYPOSTYLE Architects
www.hypostyle.co.uk

Glasgow 49 St. Vincent Crescent G3 8NG
T: 0141 204 4441 F: 0141 204 4897 E: glasgow@hypostyle.co.uk
Edinburgh 4 Sandport Place EH6 6EU
T: 0131 555 0888 F: 0131 553 4450 E: edinburgh@hypostyle.co.uk

client

CALA Homes

client's ref

project

**Pacific Quay,
Glasgow**

drawing

**Block C
Third Floor GA Plan**

scale 1:50

page size A1

date 08.08.19

checked MK

date

job ref

drawing num

rev

3693

20_123

P20


For Construction

notes
This drawing is the copyright © property of Hypostyle Designs Ltd - no copying or distribution of this drawing or any part thereof is permitted without prior written permission.
Do not scale from this drawing. All existing dimensions to be checked on site prior to commencement of works or manufacturing of components.
Any discrepancies to be brought to the attention of the architect - if in doubt, ask.

- S.H.E - safety health & environment information
- 1.
 - 2.
 - 3.

symbol indicates location & ref. no. of residual hazard/risk

Refer to engineering drawings for setting out of steelwork.

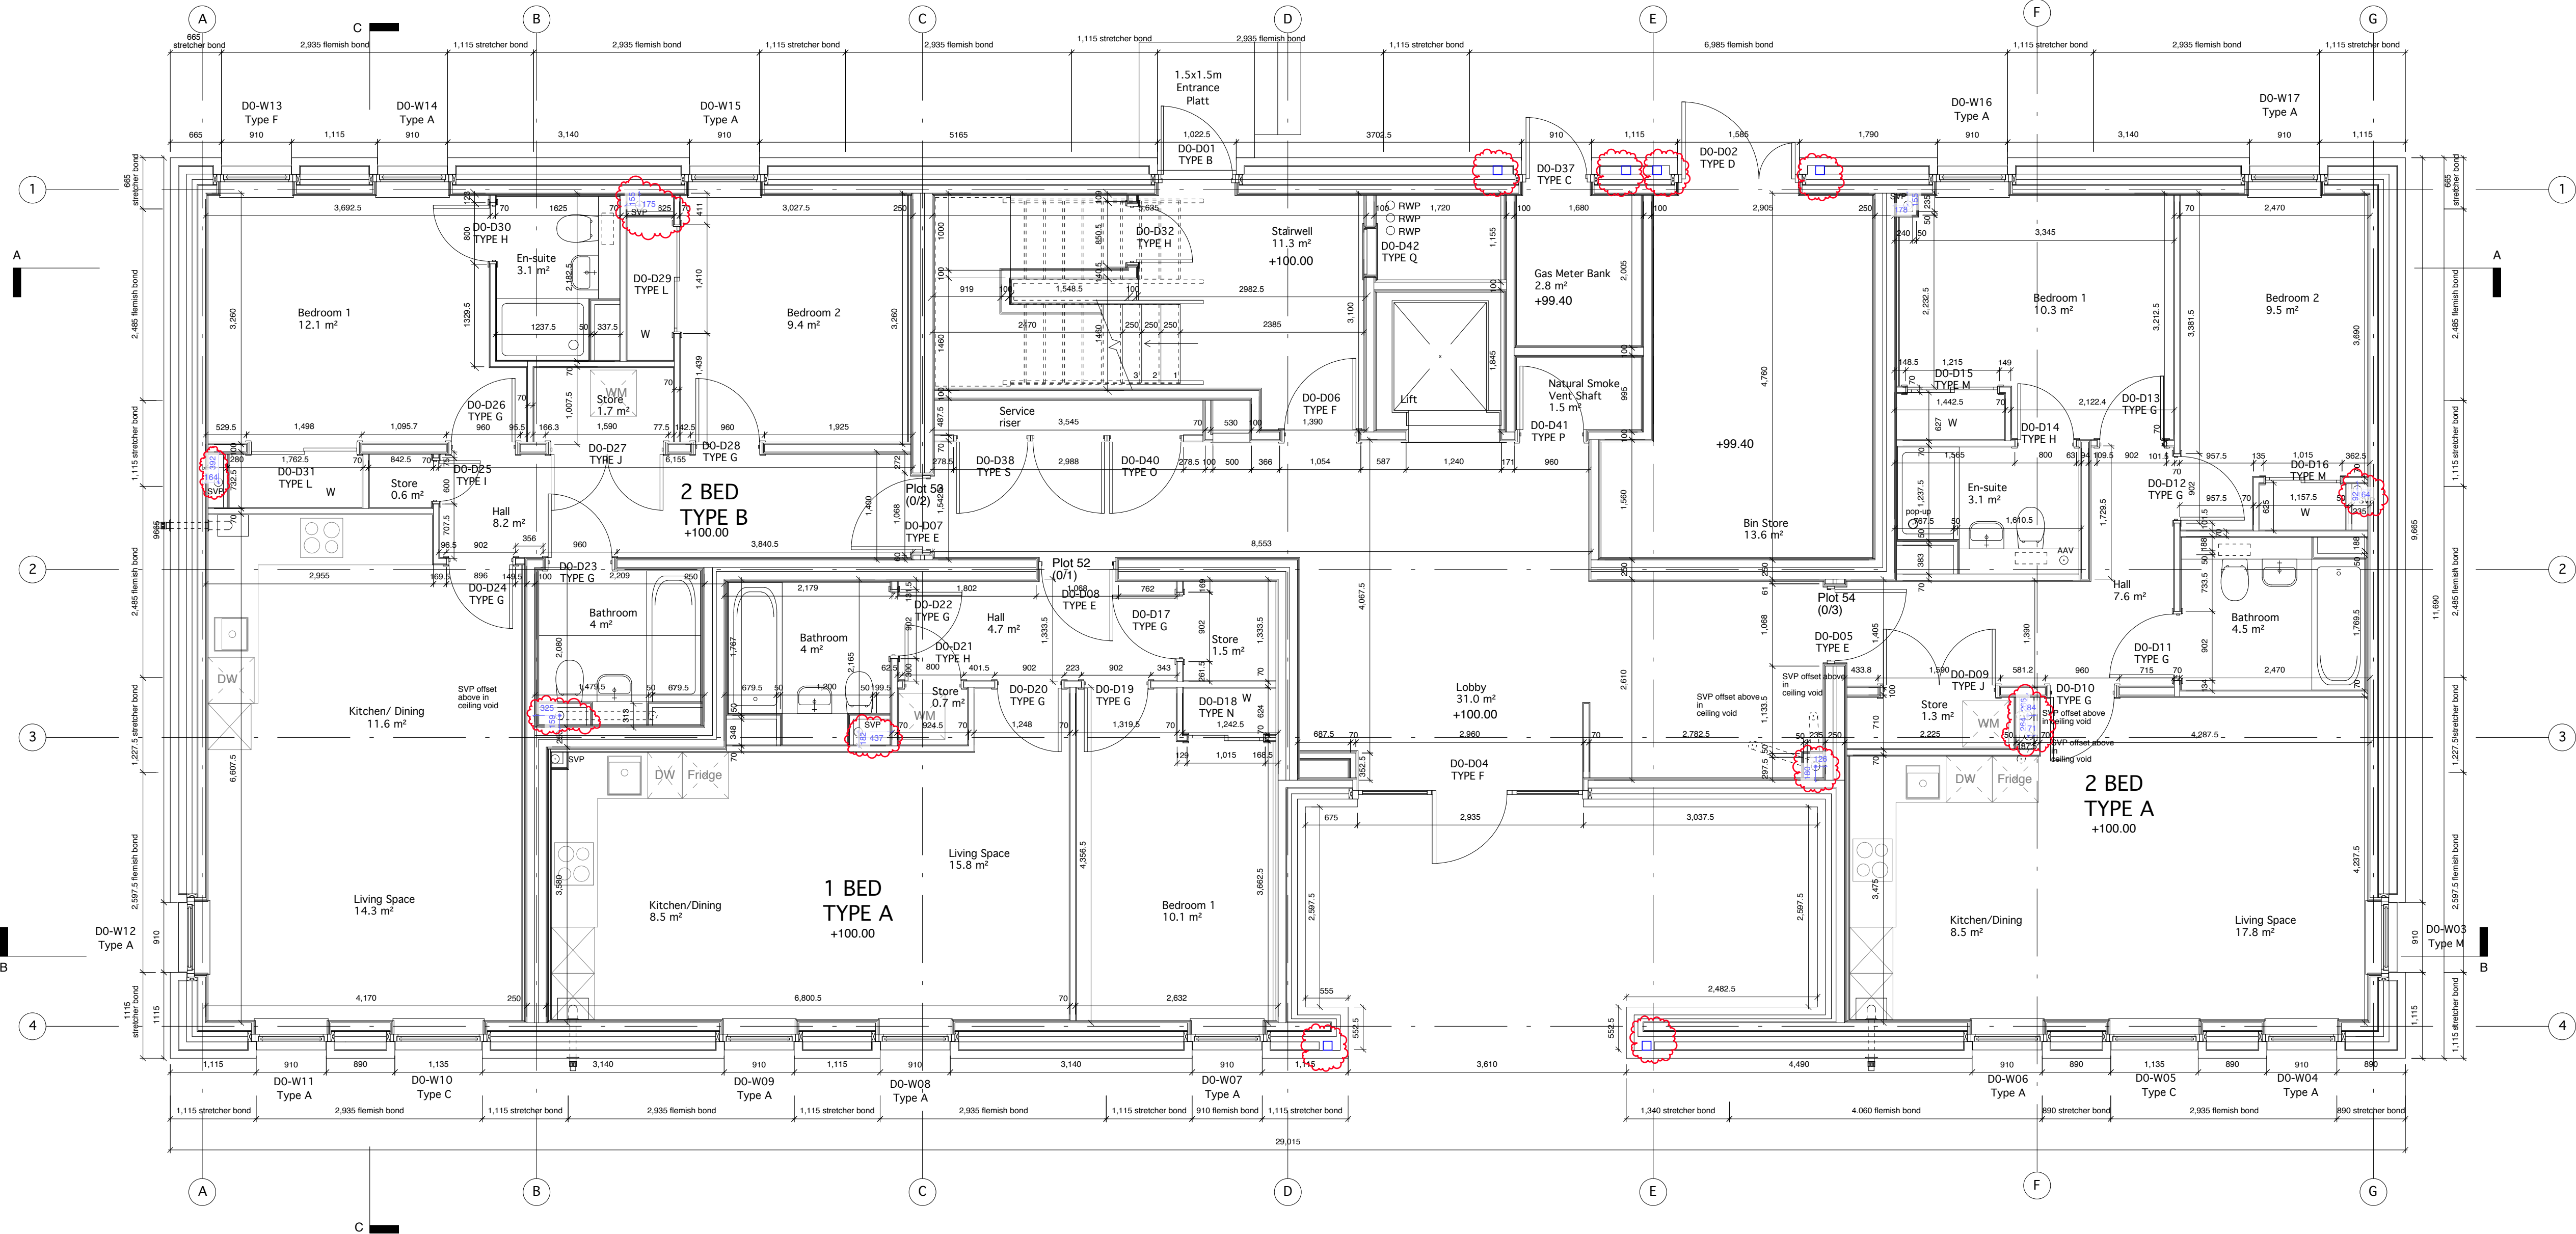

P24	Fill added to svp dims for clarity. Eng steelwork amended as per engineers drawing	MK	MK	03.12.20
P23	Dims added to SVPs	MK	MK	08.10.20
P22	SVp positions revised. Offsets noted from above in ceiling void only.	JG	JG	02.09.20
P21	SVp positions revised. Offsets noted from above only.	JG	JG	01.09.20
P20	Store arrangement under stair altered	JG	JG	17.06.20
P19	Bathroom, en-suite and SVp arrangement altered at client's request	JA	MK	07.05.20
P18	Stair arrangement altered as a result of levelling ground floor, entrance platt added, door type D0-D32 changed from G to H	JA	JG	09.03.20
P17	Window 'D0-W12' position corrected to reflect elevations, fleish bond adjusted, goalposts added	JA	JA	24.02.20
P16	Omitted 1 internal riser and rised lowered FFL by 150mm, door D0-D04 changed to 31_002-Type F	JA	JA	21.02.20
P15	Entrance opening reduced, goalposts added	JG	JG	19.02.20
P14	SVp locations revised and offsets shown, Entrance door updated	KC	KC	04.12.19
P13	Kitchen layouts revised, SVPs added at client request	KC	MK	22.11.19
P12	Kitchen revised as per client request, stair dimensions added, sanitaryware shown, rwps relocated	KC	MK	06.11.19
P11	SVp and RWPs relocated	KC	MK	07.10.19
rev.	amendment	by	Checked	date

HYPOSTYLE
HYPOSTYLE Architects
www.hypostyle.co.uk


Glasgow 49 St. Vincent Crescent G3 8NG
T: 0141 204 4441 F: 0141 204 4897 E: glasgow@hypostyle.co.uk
Edinburgh 4 Sandport Place EH6 6EU
T: 0131 555 0888 F: 0131 553 4450 E: edinburgh@hypostyle.co.uk

client
CALA Homes

client's ref
project
**Pacific Quay,
Glasgow**

drawing
**Block D
Ground Floor GA Plan**

scale 1:50
page size A1
job ref 3693
date 08.08.19
drawing num 20_130
checked MK
date
rev P24

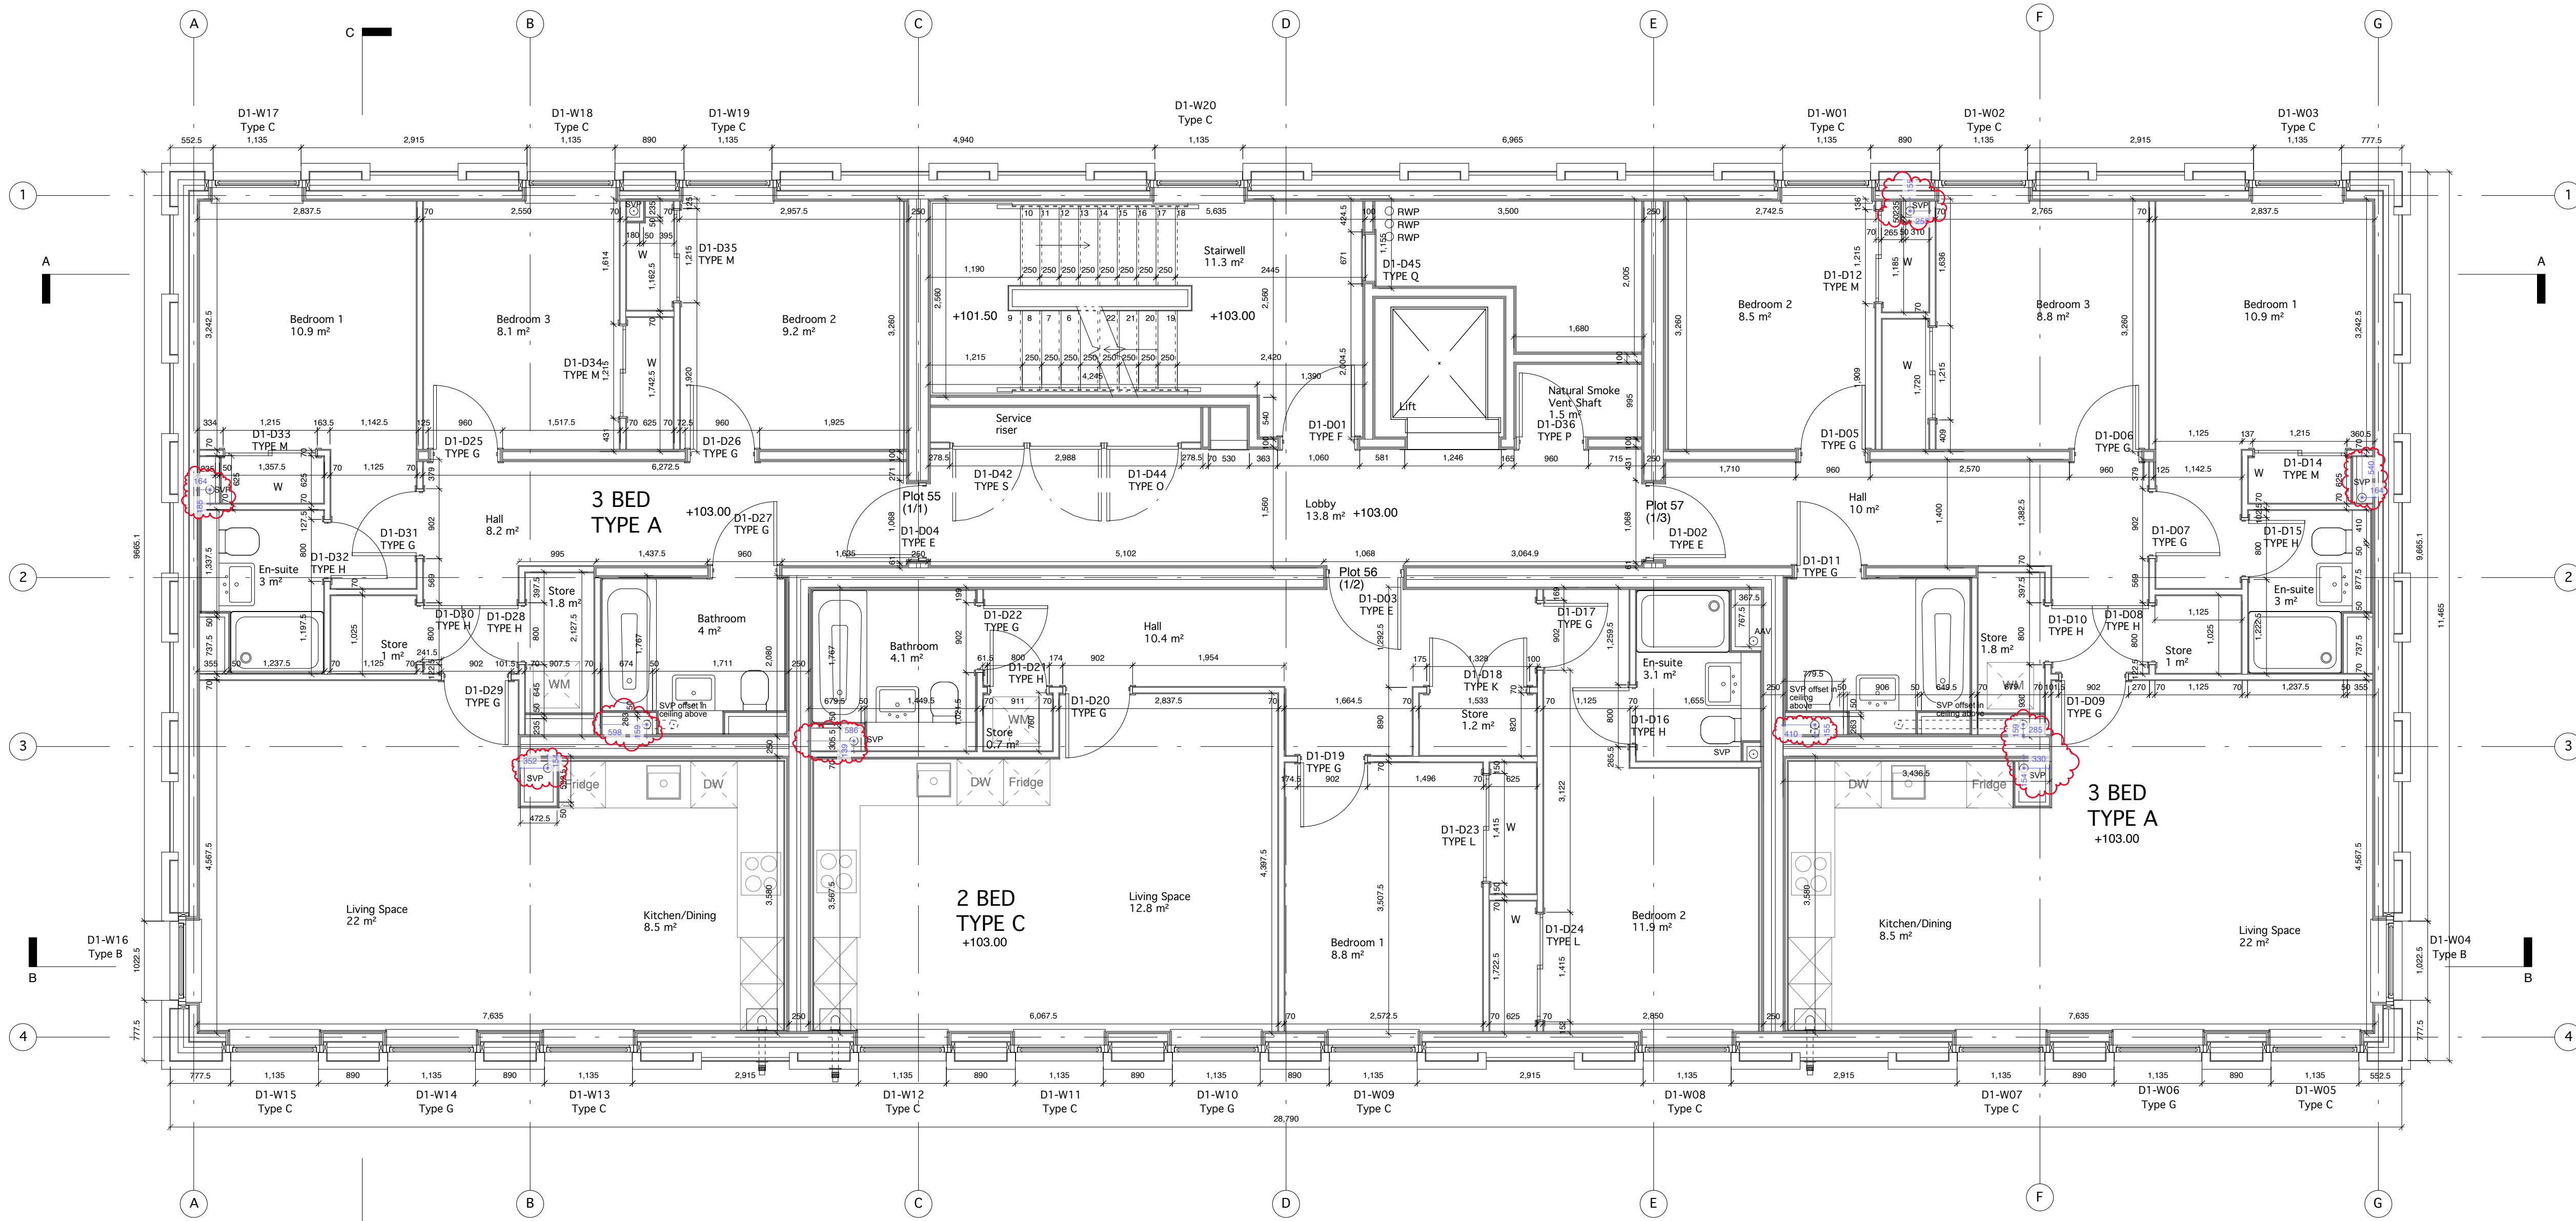

notes

This drawing is the copyright © property of Hypostyle Designs Ltd - no copying or distribution of this drawing or any part thereof is permitted without prior written permission.

Do not scale from this drawing. All existing dimensions to be checked on site prior to commencement of works or manufacturing of components.

Any discrepancies to be brought to the attention of the architect - if in doubt, ask.

S.H.E - safety health & environment information

1.

2.

3.

◊ - symbol indicates location & ref. no. of residual hazard/risk

Internal dimensions to steel frame

External dimensions to masonry

P22	Fill added to SVP dimensions for clarity	MK	MK	03.12.20
P21	SVP dimensions added.	MK	MK	08.10.20
P20	SVP offsets noted as from above in ceiling void. SVP shown in en-suite. 2 Bed Type C to match HB	JG	JG	02.09.20
P19	SVP positions revised. Offsets noted from above only. Kitchen to 3 BED TYPE A arrangement revised. Dishwasher & sink relocated, svp boxing increased in size.	JG	JG	01.09.20
P18	SVP arrangement altered boxing behind WC extended and WC centred at client's request	JA	MK	07.05.20
P17	Stair arrangement altered as a result of leveling ground floor	JA	JA	04.03.20
P16	Window 'D1-W16' position corrected to reflect elevations	JA	JA	24.02.20
P15	Stair numbering corrected as a result of 1 omitted stair from ground level	JA	JA	21.02.20
P14	SVP locations amended to respect NS clear zone. SVP offsets shown.	KC	KC	04.12.19
P13	Kitchen layouts revised, SVPs added at client request	KC	MK	22.11.19
P12	framing out revised, stair dimensions added, rwps relocated	KC	MK	06.11.19
P11	SVP and RWPs relocated	KC	MK	07.10.19
rev.	amendment	by	Checked	date

HYPOSTYLE

HYPOSTYLE Architects
www.hypostyle.co.uk

Glasgow

49 St. Vincent Crescent G3 8NG

T: 0141 204 4441 F: 0141 204 4897 E: glasgow@hypostyle.co.uk

Edinburgh

4 Sandport Place EH6 6EU

T: 0131 555 0888 F: 0131 553 4450 E: edinburgh@hypostyle.co.uk

client

CALA Homes

client's ref

project

Pacific Quay, Glasgow

drawing

Block D
First Floor GA Plan

scale 1:50

page size A1

drawn KC

checked MK


date 08.08.19

date

job ref 3693

drawing num 20_131

rev P22

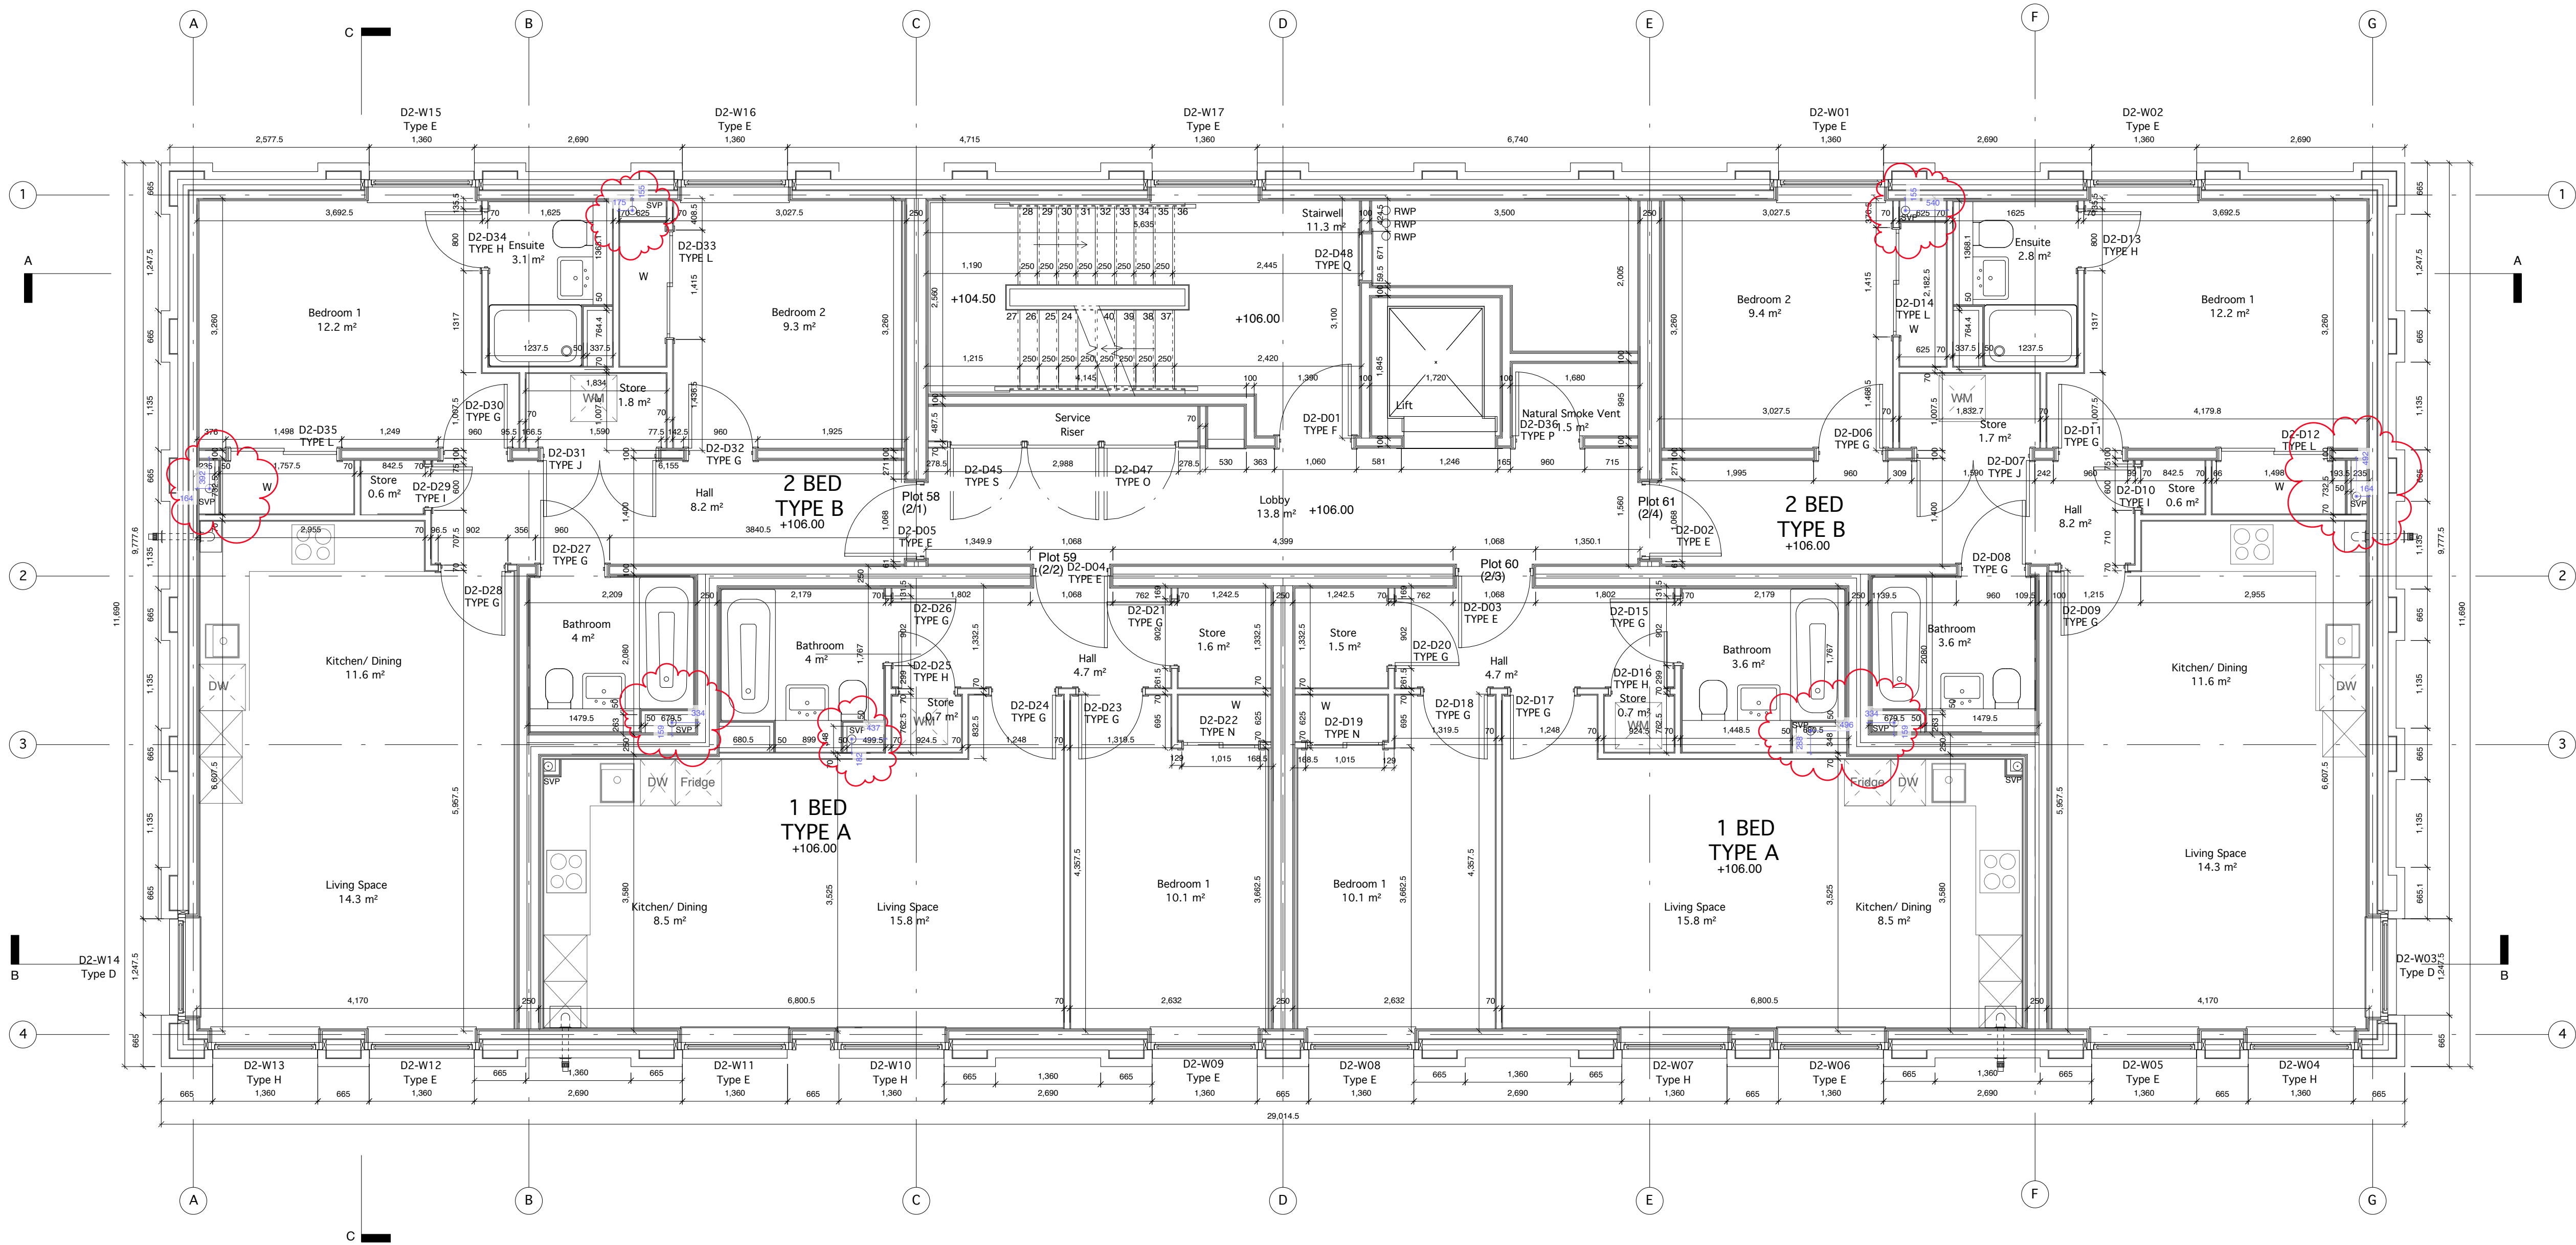

notes
This drawing is the copyright © property of Hypostyle Designs Ltd - no copying or distribution of this drawing or any part thereof is permitted without prior written permission.
Do not scale from this drawing. All existing dimensions to be checked on site prior to commencement of works or manufacturing of components.
Any discrepancies to be brought to the attention of the architect - if in doubt, ask.

- S.H.E - safety health & environment information
- 1.
 - 2.
 - 3.

symbol indicates location & ref. no. of residual hazard/risk

Internal dimensions to steel frame
External dimensions to masonry

P21	Fill added to SVP dimensions for clarity	MK	MK	03.12.20
P20	SVP dimensions added.	MK	MK	08.10.20
P19	Minor adjustments to SVP locations to match below	JG	JG	02.09.20
P18	SVP offsets noted as above only. Offset below notation removed	JG	JG	01.09.20
P17	Bathroom, en-suite and SVP arrangement altered at clients request	JA	MK	07.05.20
P16	Stair numbering corrected	JA	JA	04.03.20
P15	Stair numbering corrected as a result of 1 omitted stair from ground level	JA	JA	21.02.20
P14	SVP locations simplified and amended to respect NS clear zone, SVP offsets added, bathroom/en-suite layouts mirrored	KC	KC	04.12.19
P13	Kitchen layouts revised, SVPs added at client request	KC	MK	22.11.19
P12	Kitchen revised as per client request, stair dimensions added, tvps relocated	KC	MK	07.10.19
P11	SVP and RWP's relocated	KC	MK	07.10.19
rev.	amendment	by	Checked	date

HYPO

STYLE

HYPOSTYLE Architects

www.hypostyle.co.uk

Glasgow 49 St. Vincent Crescent G3 8NG
T: 0141 204 4441 F: 0141 204 4897 E: glasgow@hypostyle.co.uk
Edinburgh 4 Sandport Place EH6 6EU
T: 0131 555 0888 F: 0131 553 4450 E: edinburgh@hypostyle.co.uk

client

client's ref

project

Pacific Quay,
Glasgow

drawing

Block D
Second Floor GA Plan

scale 1:50

page size A1

date 08.08.19


checked MK

date

job ref 3693

drawing num 20_132

rev P21

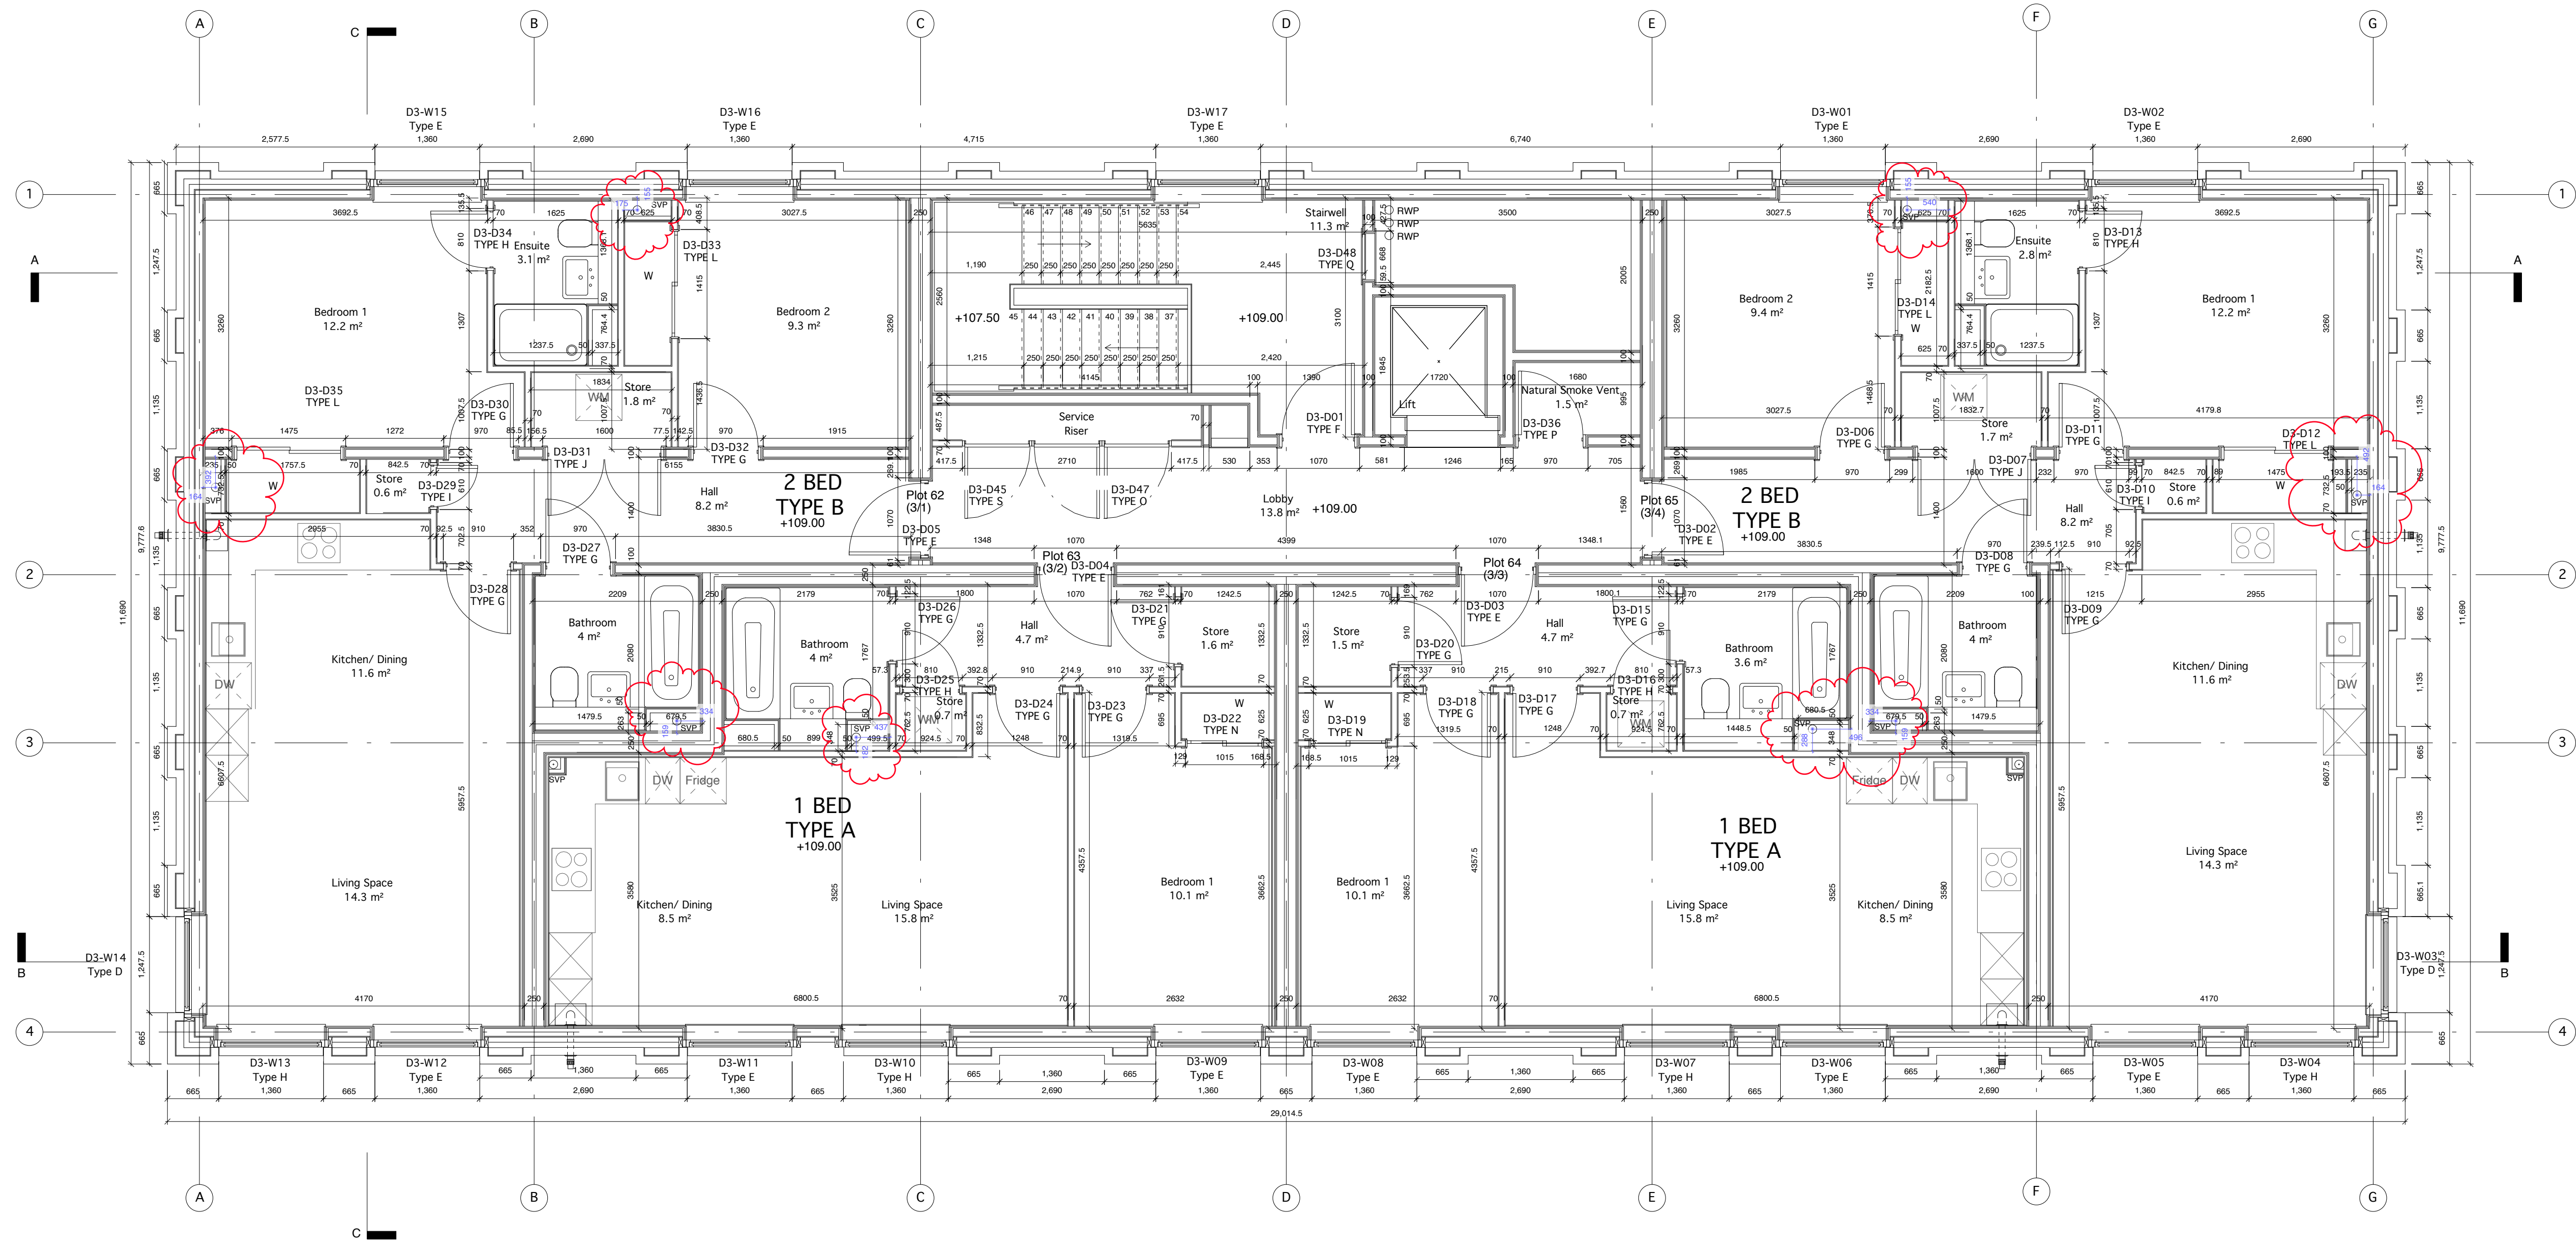

notes
This drawing is the copyright © property of Hypostyle Designs Ltd - no copying or distribution of this drawing or any part thereof is permitted without prior written permission.
Do not scale from this drawing. All existing dimensions to be checked on site prior to commencement of works or manufacturing of components.
Any discrepancies to be brought to the attention of the architect - if in doubt, ask.

S.H.E - safety health & environment information
1.
2.
3.

symbol indicates location & ref. no. of residual hazard/risk

Internal dimensions to steel frame
External dimensions to masonry

P22	Fill added to SVP dimensions for clarity	MK	MK	03.12.20
P21	SVP dimensions added.	MK	MK	08.10.20
P20	Minor adjustments to SVP locations to match below	JG	JG	02.09.20
P19	SVP offsets noted as above only. Offset below notation removed	JG	JG	01.09.20
P18	Door opening dimensions altered to suit 33mm jambs	JA	MK	14.08.20
P17	Bathroom, en-suite and SVP arrangement altered at client's request	JA	MK	07.05.20
P16	Stair numbering corrected	JA	JA	04.03.20
P15	Stair numbering corrected as a result of 1 omitted stair from ground level	JA	JA	21.02.20
P14	SVP locations simplified and amended to respect NS clear zone, SVP offsets added, bathroom/en-suite layouts mirrored	KC	KC	04.12.19
P13	Kitchen layouts revised, SVPs added at client request	KC	MK	22.11.19
P12	Kitchen revised as per client request, stair dimensions added, typs relocated	KC	MK	07.10.19
P11	SVP and RWP's relocated	KC	MK	07.10.19
rev.	amendment	by	Checked	date

HYPO
STYLE

HYPOSTYLE Architects
www.hypostyle.co.uk

Glasgow 49 St. Vincent Crescent G3 8NG
T: 0141 204 4441 F: 0141 204 4897 E: glasgow@hypostyle.co.uk
Edinburgh 4 Sandport Place EH6 6EU
T: 0131 555 0888 F: 0131 553 4450 E: edinburgh@hypostyle.co.uk

client

CALA Homes

client's ref

project

**Pacific Quay,
Glasgow**

drawing

**Block D
Third Floor GA Plan**

scale 1:50

page size A1

date 08.08.19

checked MK

date

job ref

drawing num


rev

3693

20_133

P22

For Construction
scale bar
0 1 2 3 4 5

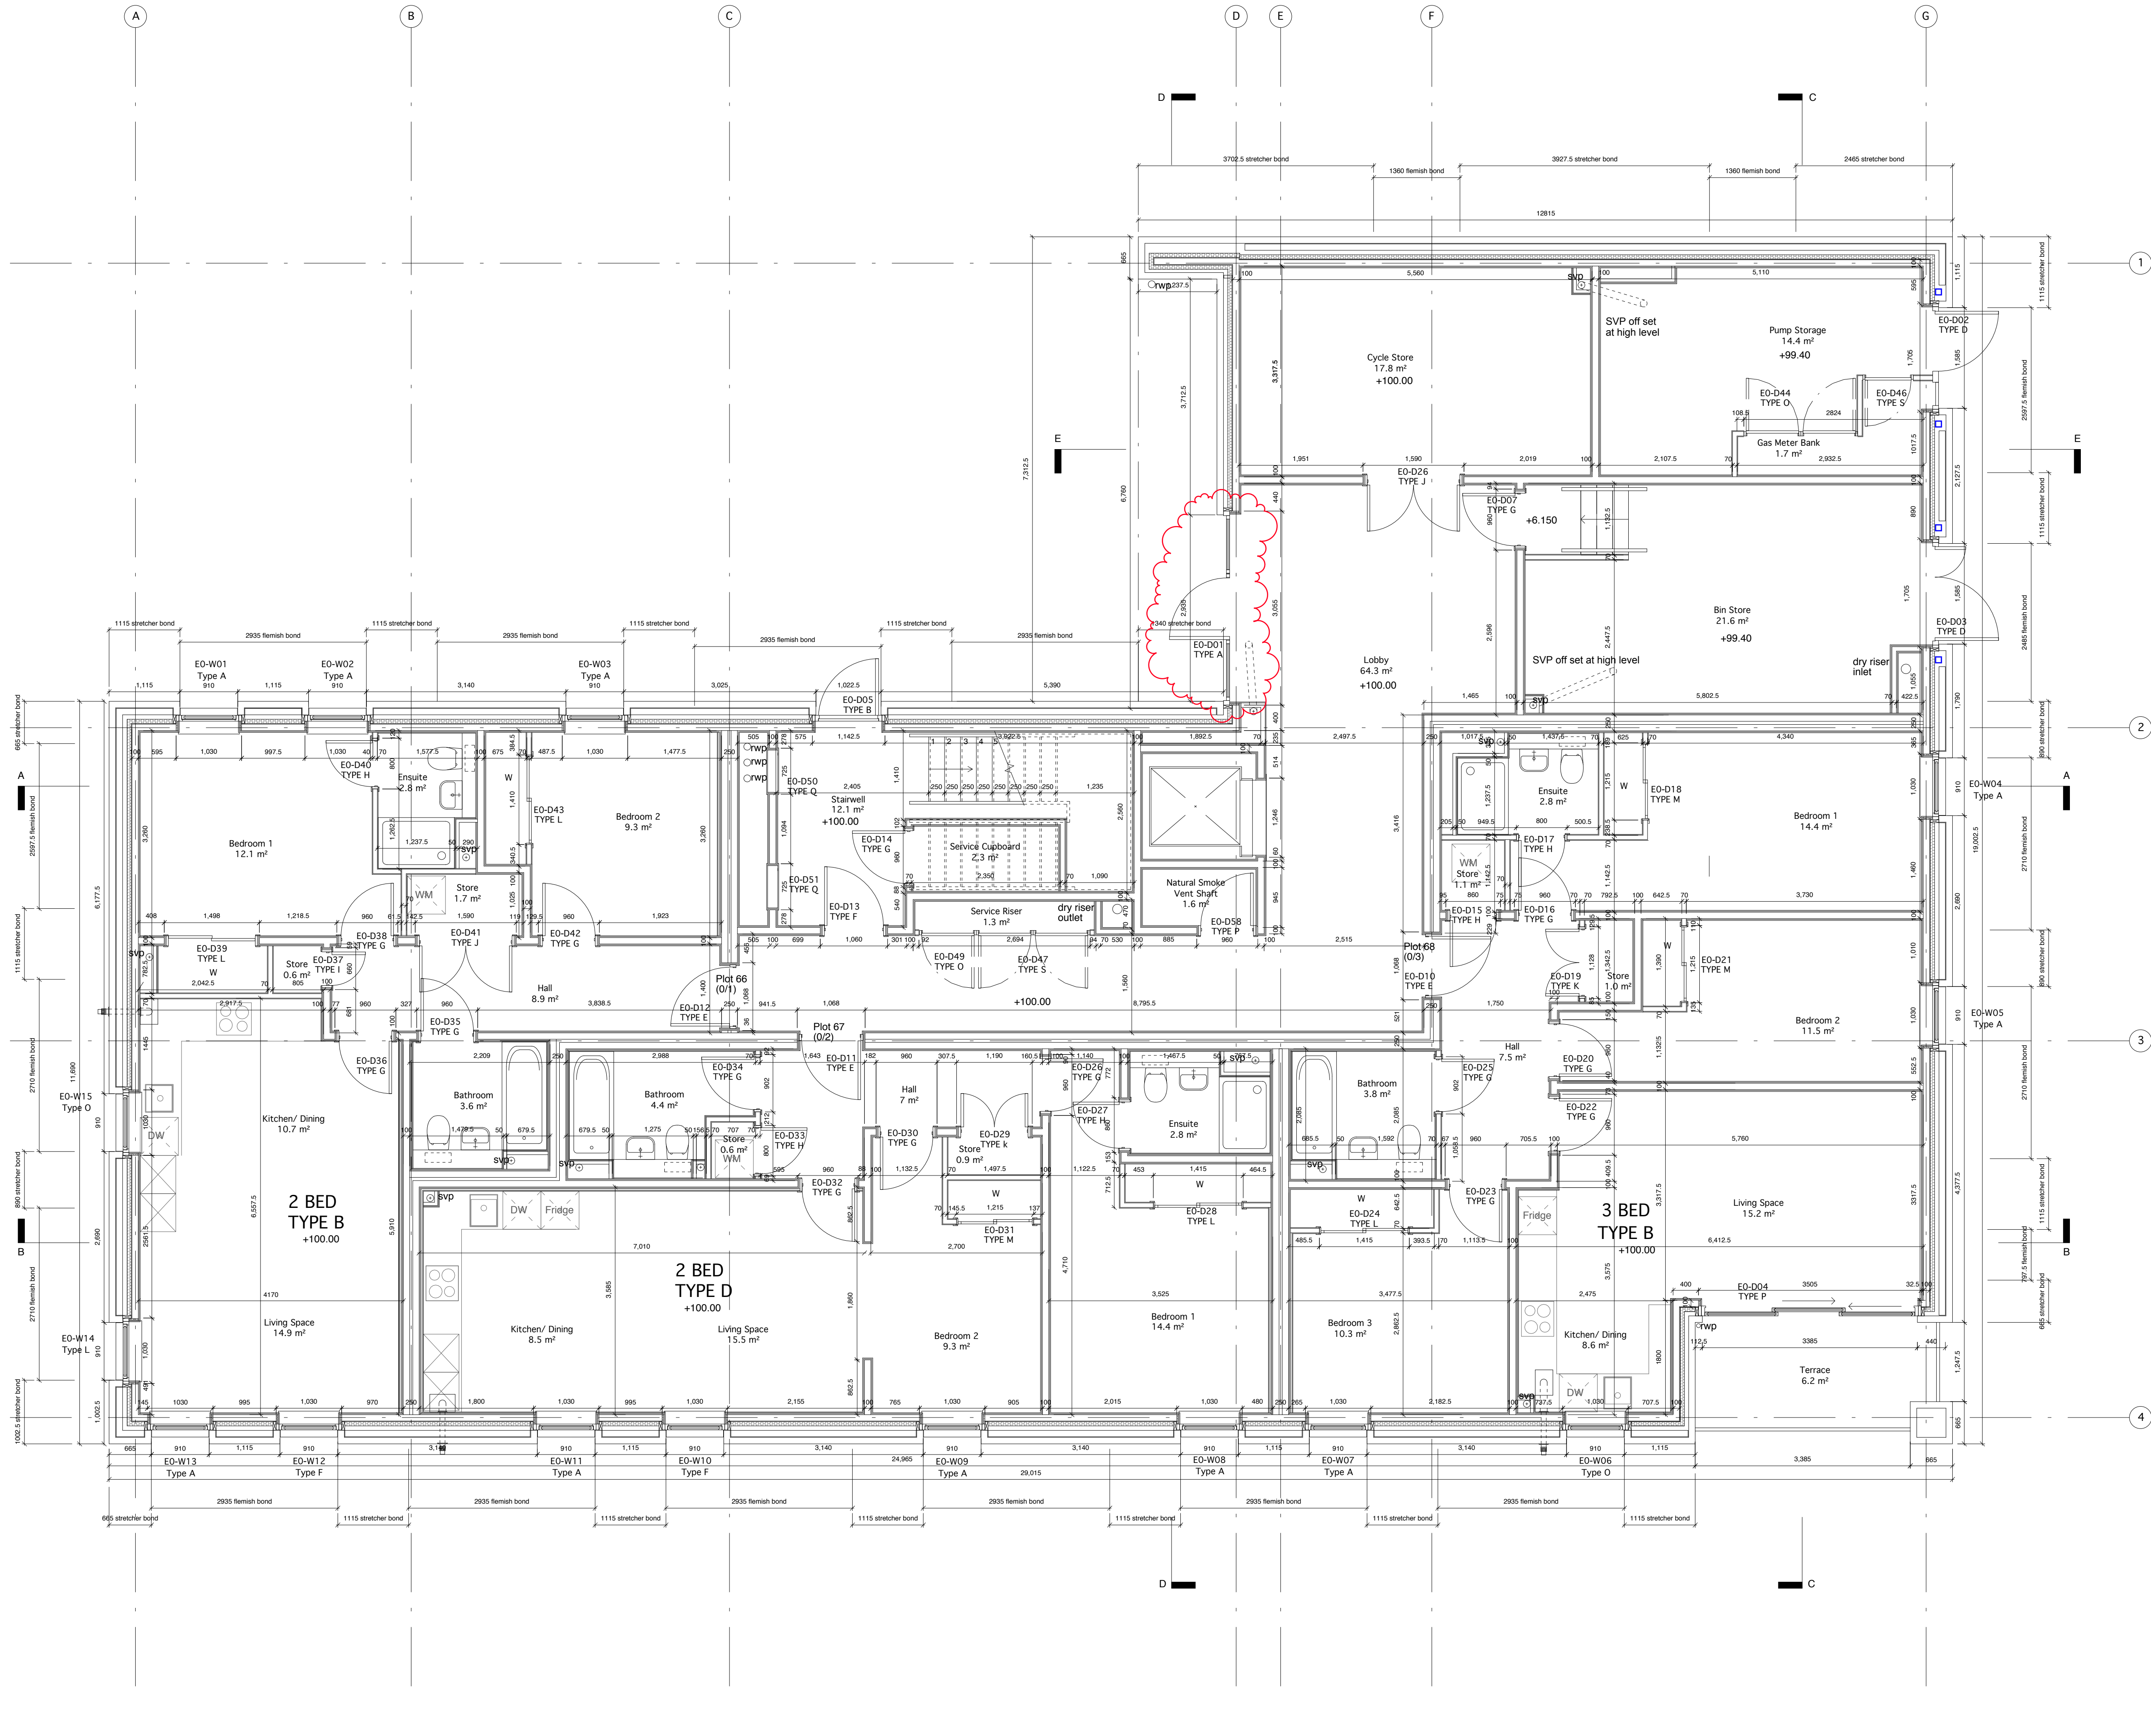

notes
This drawing is the copyright © property of Hypostyle Designs Ltd - no copying or distribution of this drawing or any part thereof is permitted without prior written permission.
Do not scale from this drawing. All existing dimensions to be checked on site prior to commencement of works or manufacturing of components.
Any discrepancies to be brought to the attention of the architect - if in doubt, ask.

S.H.E - safety health & environment information

- 1.
- 2.
- 3.

symbol indicates location & ref. no. of residual hazard/risk

Internal dimensions to steel frame
External dimensions to masonry

P17	Main Entrance Handed.	MK	MK	16.10.20
P16	Gas bank adjusted, and fixed louvre panel introduced to Gas Bank as per client design. E0-D01 type amended.	MK	MK	06.10.20
P15	Flemish bond adjusted, Door 'E0-D01' altered, goilposts added	JA	JA	26.02.20
P14	SVP locations amended to respect NS clear zone.	GMCA	KC	25.11.19
P13	Kitchen layouts revised, SVP added	KC	KC	21.11.19
P12	Pier and steelwork at large balcony amended in line with sketch issued to NS & Striver.	MK	MK	14.11.19
P11	Kitchen revised as per client request, stair dimensions added, Flemish and stretcher bond panels, rmps relocated	KC	MK	06.11.19
P10	Changed to monochrome. Kitchen layouts added, window and door references, & section lines added	KC	MK	31.10.19
P09	Door dimensions revised, structural slab levels added, cavity resized, opening for show flat added	KC	MK	16.10.19
P08	Type B terrace doors, half brick rebate added as per balcony workshop discussion, internal RWP positions amended following IKO workshop	MK	MK	24.09.19
rev.	amendment		by	Checked date

HYPO
STYLE

HYPOSTYLE Architects
www.hypostyle.co.uk

Glasgow 49 St. Vincent Crescent G3 8NG
T: 0141 204 4441 F: 0141 204 4897 E: glasgow@hypostyle.co.uk
Edinburgh 4 Sandport Place EH6 6EU
T: 0131 555 0888 F: 0131 553 4450 E: edinburgh@hypostyle.co.uk

client

client's ref

project

drawing

CALA Homes

**Pacific Quay,
Glasgow**

**Block E
Ground Floor GA Plans**

scale 1:50

page size A1

job ref 3693

drawing num 20_140


checked MK

date 06.08.19

date 06.10.20

rev P17

For Construction

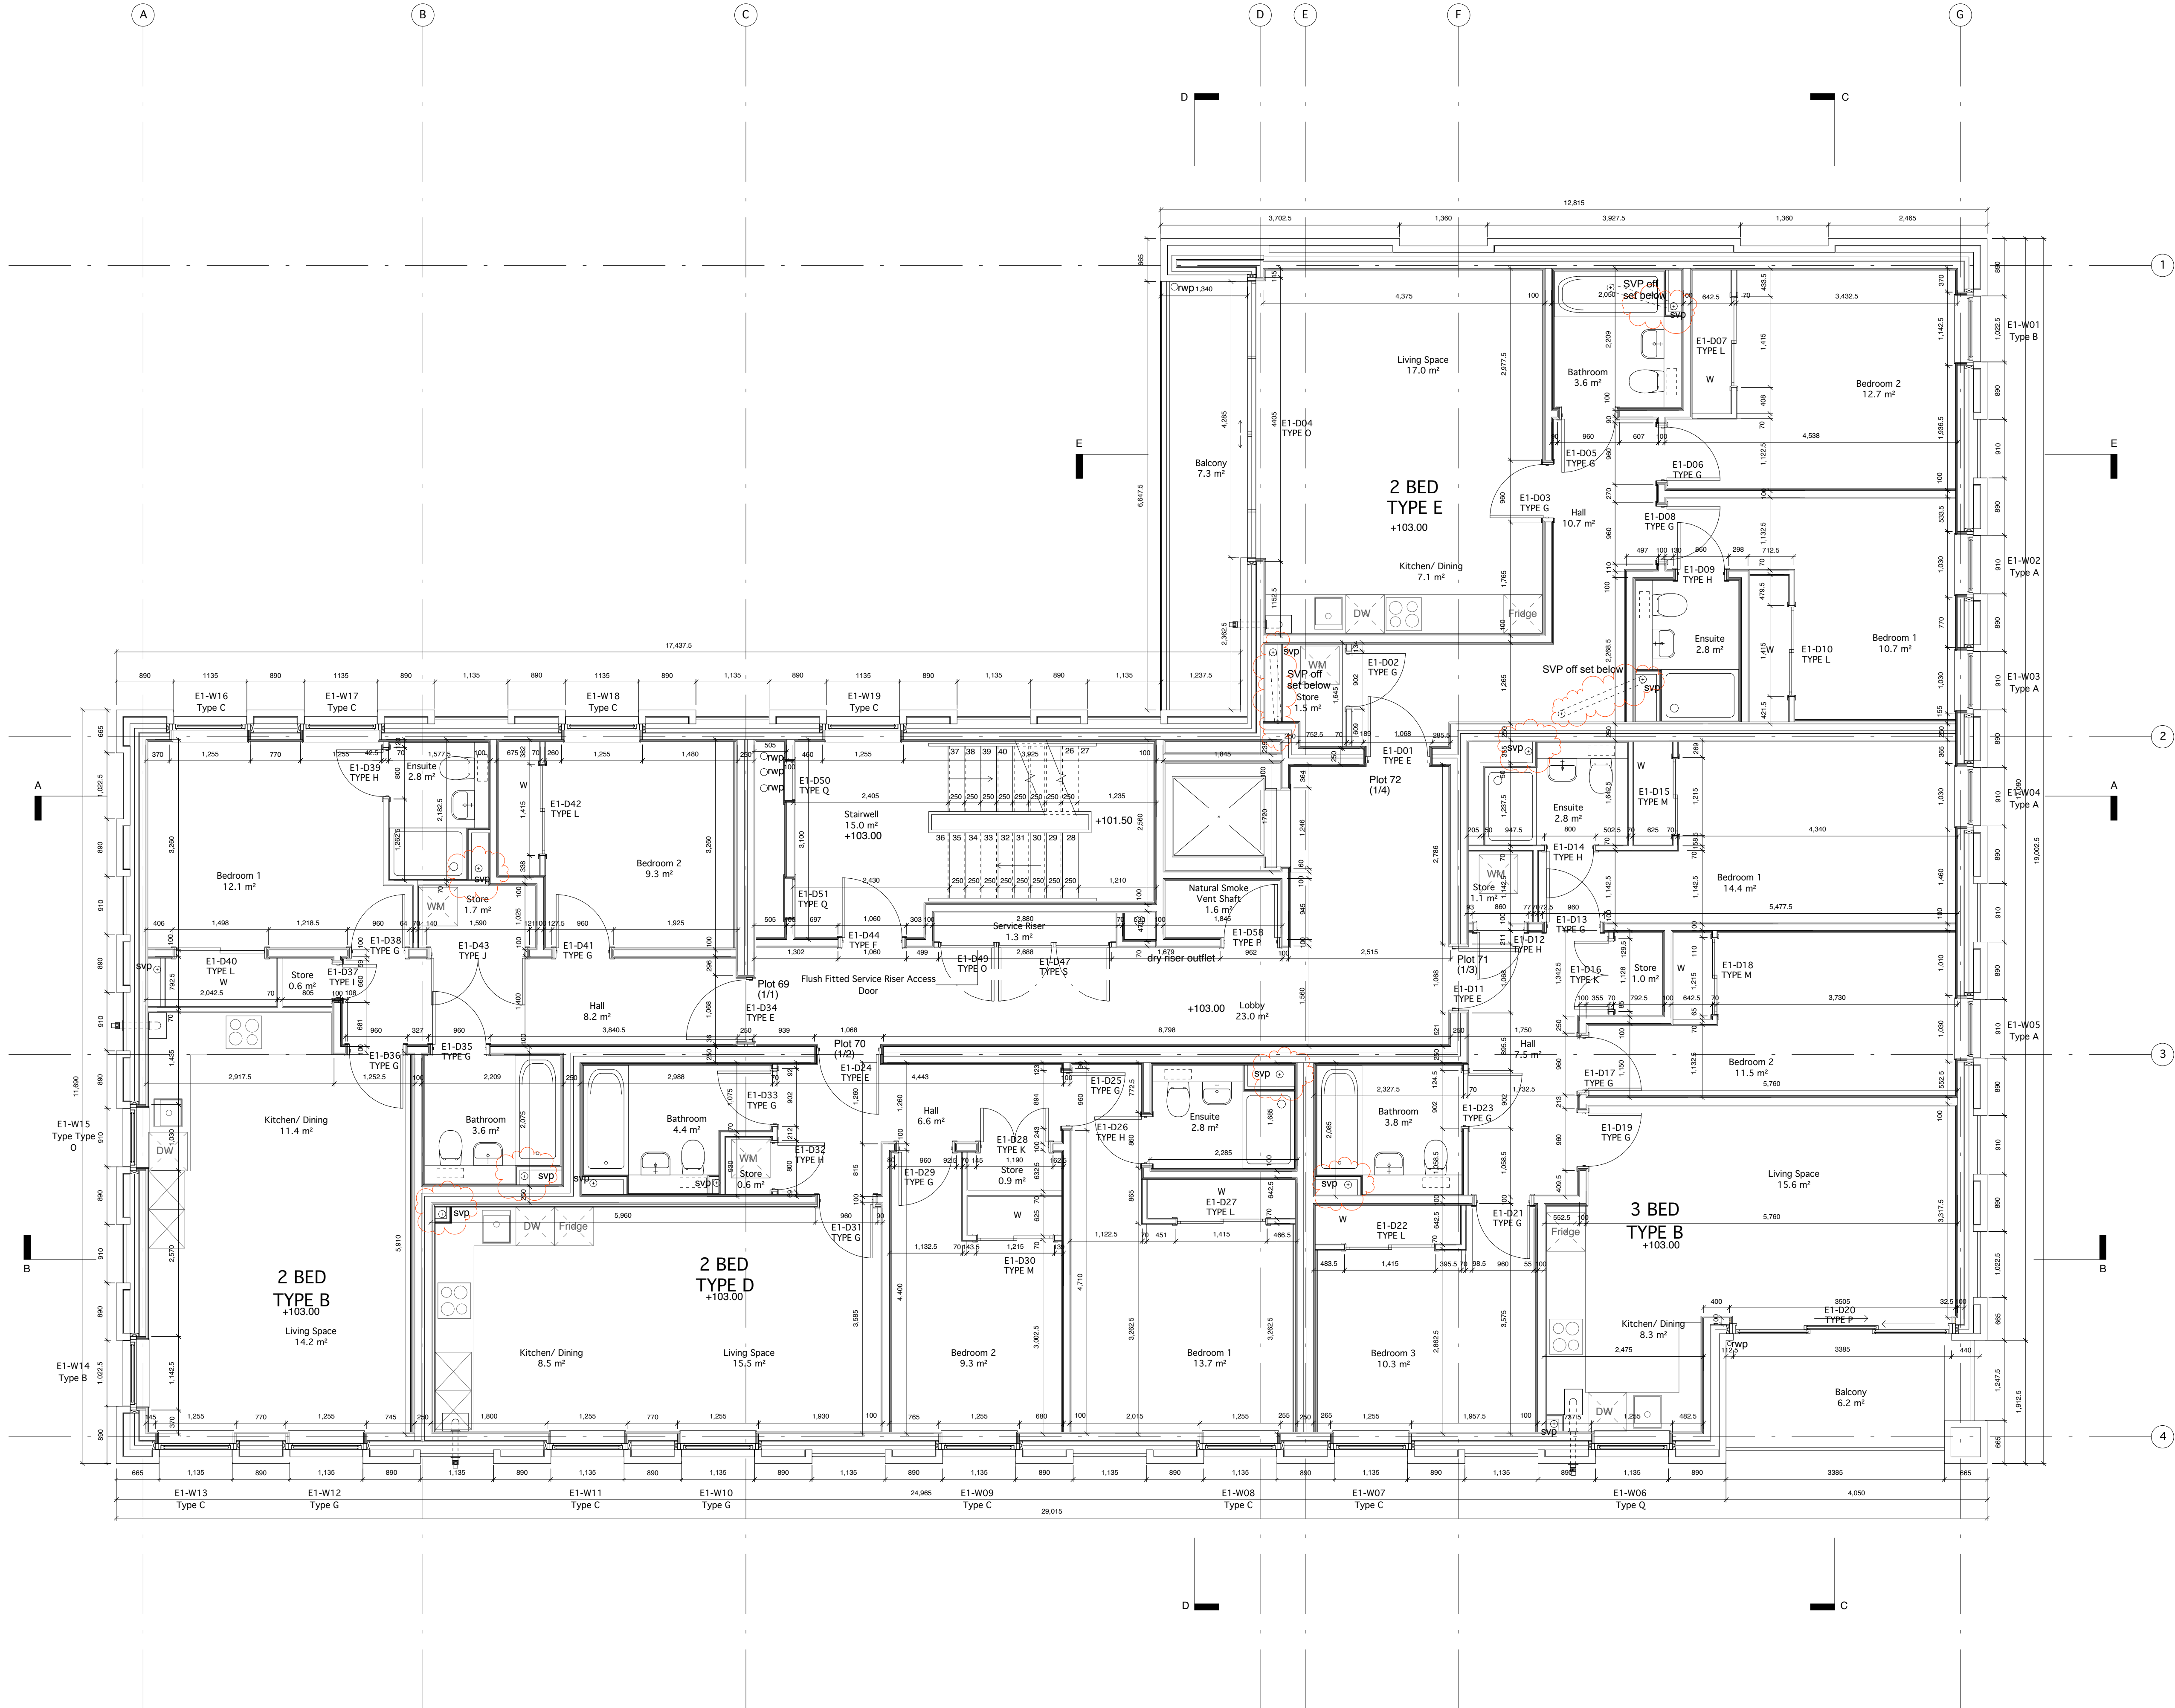

notes

This drawing is the copyright © property of Hypostyle Designs Ltd - no copying or distribution of this drawing or any part thereof is permitted without prior written permission.

Do not scale from this drawing. All existing dimensions to be checked on site prior to commencement of works or manufacturing of components.

Any discrepancies to be brought to the attention of the architect - if in doubt, ask.

S.H.E - safety health & environment information

1.

2.

3.

◊ - symbol indicates location & ref. no. of residual hazard/risk

Internal dimensions to steel frame

External dimensions to masonry

P14	SVP locations amended to respect NS clear zone.	GMCA/KC	25.11.19
P13	Kitchen layouts revised, SVP added	KC	21.11.19
P12	Pier and steelwork at large balcony amended in line with sketch issued to NS & Struer.	MK	14.11.19
P11	Kitchen revised as per client request, stair dimensions added, nips relocated	MK	31.10.19
P10	Changed to monochrome, Kitchen layouts added, door & window references and section lines added	MK	31.10.19
P09	Door dimensions revised, structural slab levels added, cavity resized	MK	08.10.19
P08	Type B terrace doors, half brick rebate added. Type E Balcony opening width reduced to under 4400 as per balcony workshop discussion. Internal RWP positions amended following IKO workshop.	MK	24.09.19
rev.	amendment	by	Checked date

HYPO
STYLE

HYPOSTYLE Architects
www.hypostyle.co.uk

Glasgow 49 St. Vincent Crescent G3 8NG
T: 0141 204 4441 F: 0141 204 4897 E: glasgow@hypostyle.co.uk
Edinburgh 4 Sandport Place EH6 6EU
T: 0131 555 0888 F: 0131 553 4450 E: edinburgh@hypostyle.co.uk

client

CALA Homes

client's ref

project

**Pacific Quay,
Glasgow**

drawing

**Block E
First Floor GA Plans**

scale 1:50

page size A1

date 06.08.19


job ref 3693

drawing num 20_141

checked MK

date

rev P14

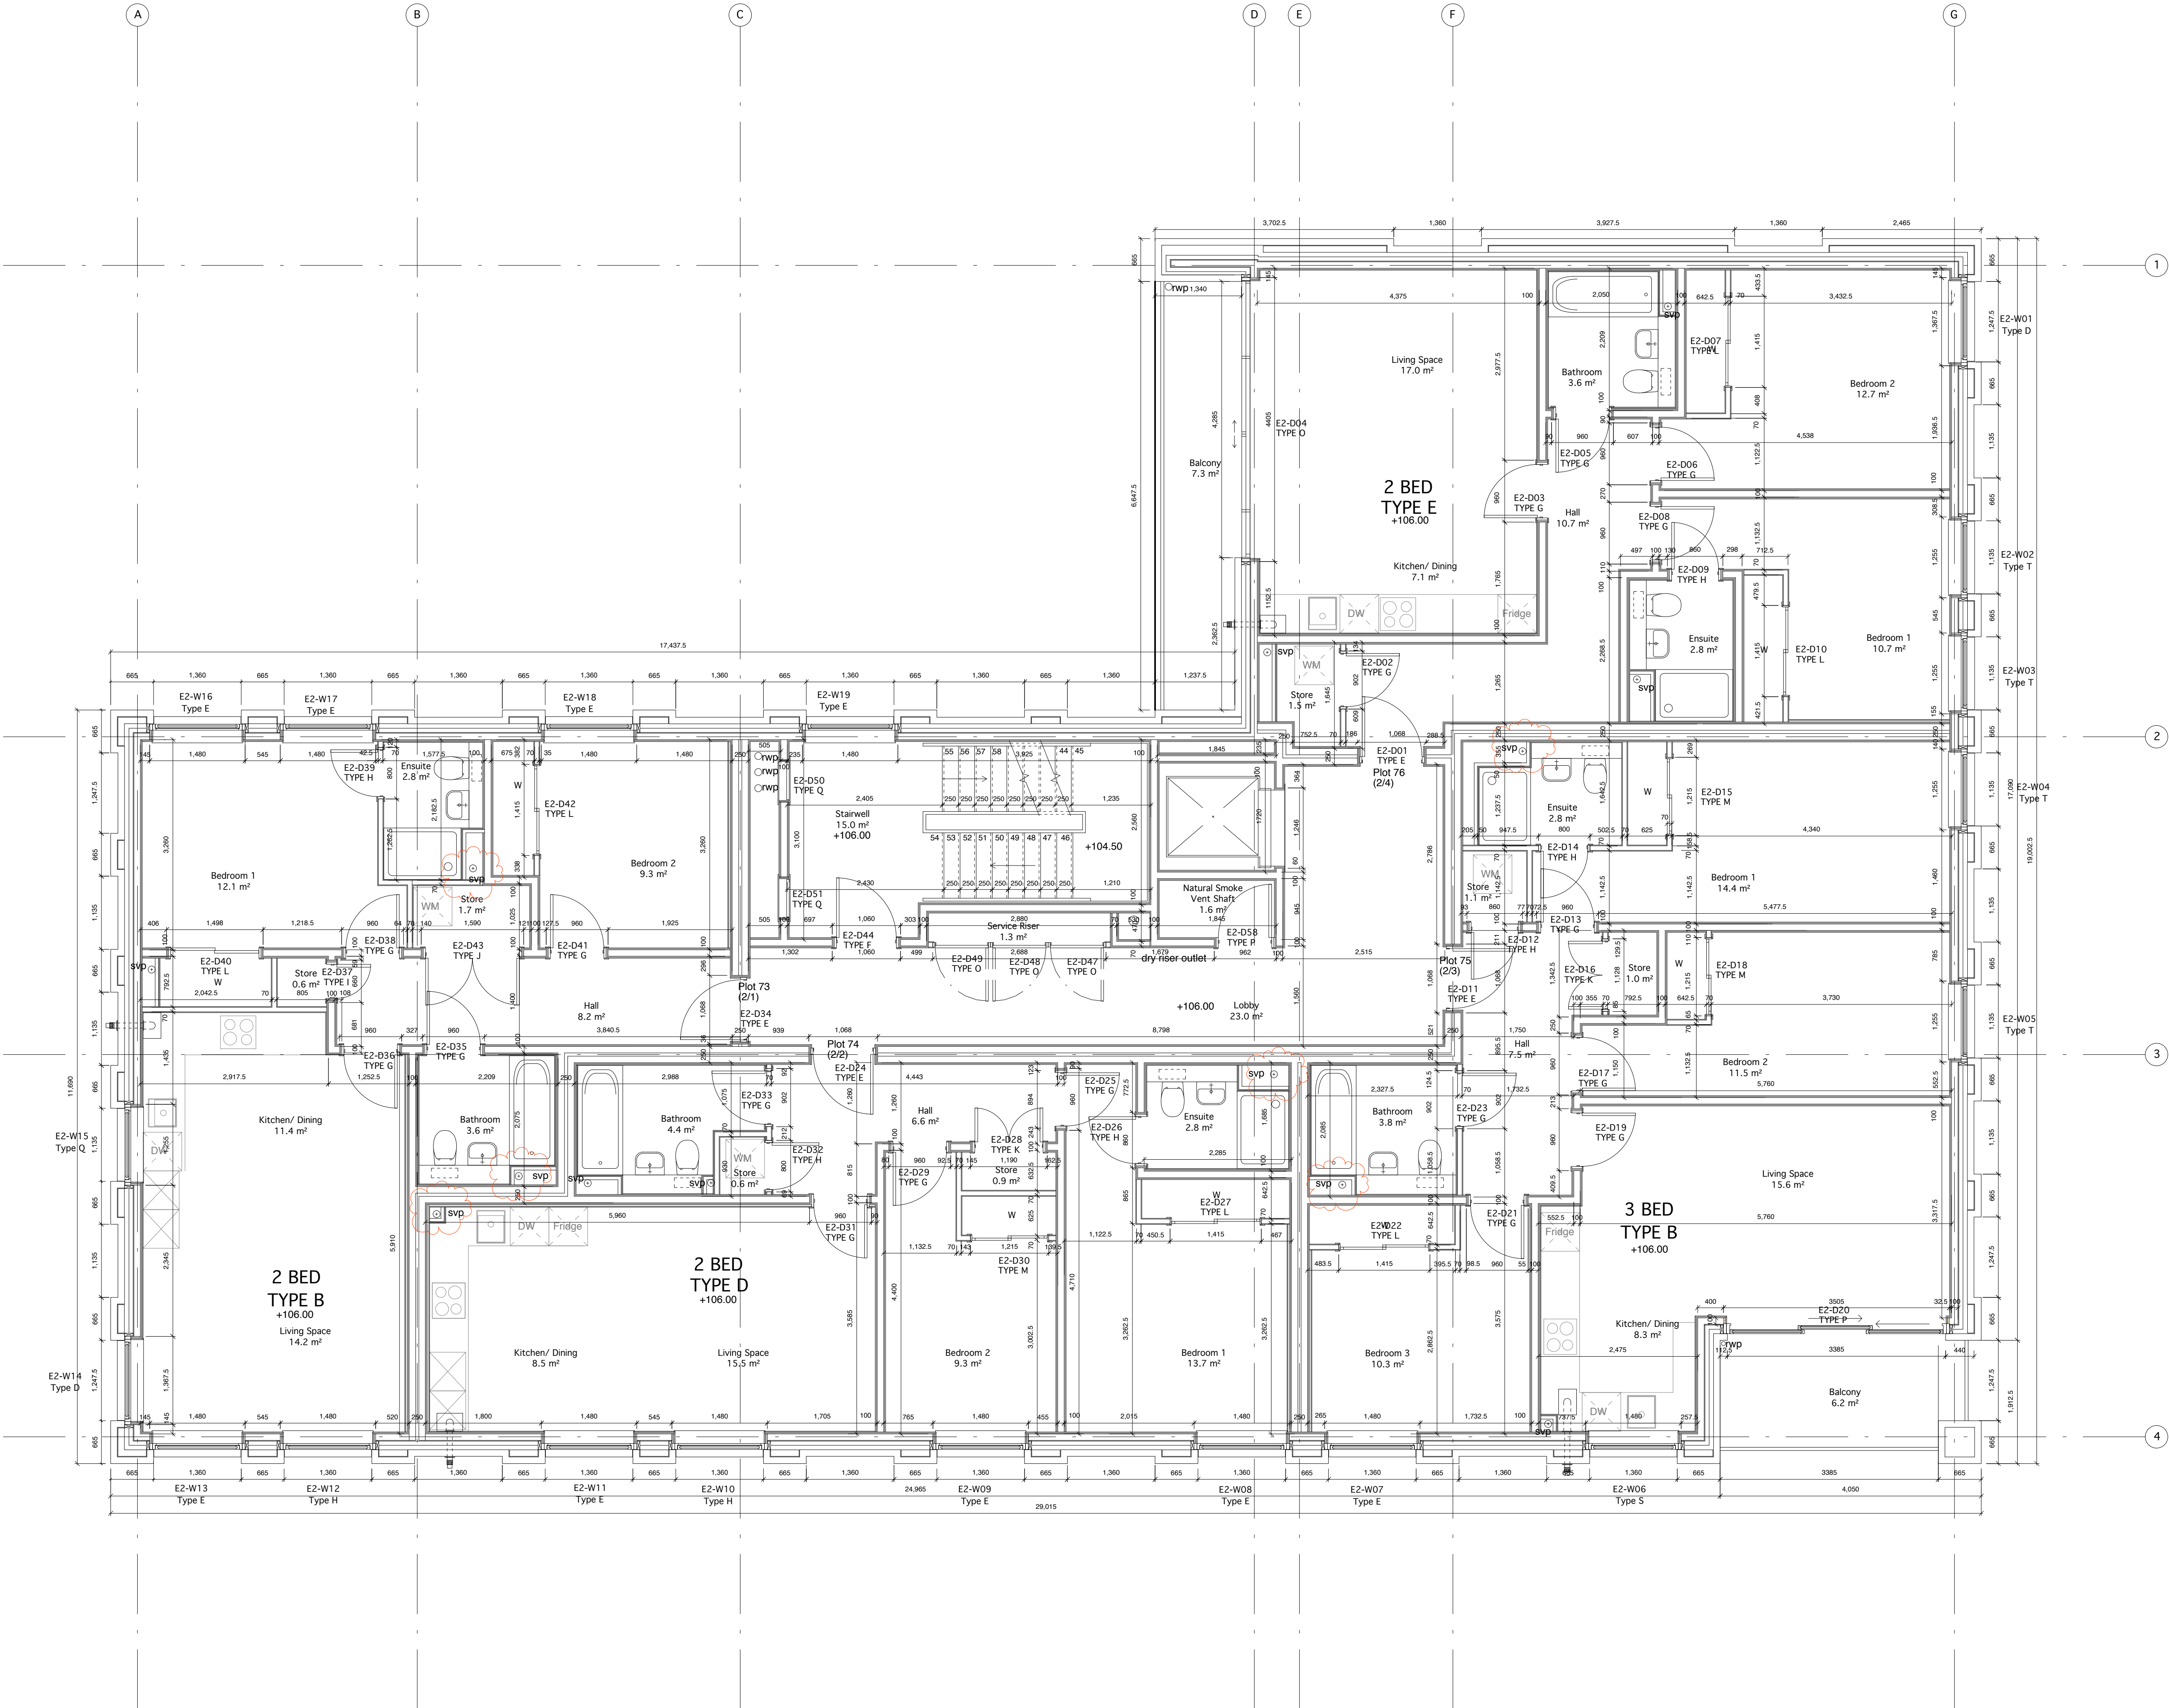

notes

This drawing is the copyright © property of Hypostyle Designs Ltd - no copying or distribution of this drawing or any part thereof is permitted without prior written permission.

Do not scale from this drawing. All existing dimensions to be checked on site prior to commencement of works or manufacturing of components.

Any discrepancies to be brought to the attention of the architect - if in doubt, ask.

S.H.E - safety health & environment information

1.

2.

3.

symbol indicates location & ref. no. of residual hazard/risk

Internal dimensions to steel frame
External dimensions to masonry

P15	SVP locations amended to respect NS clear zone.	GMCA	KC	25.11.19
P14	Kitchen layouts revised, SVP added	KC	KC	21.11.19
P13	Window dimensions corrected to type D, Windoe type 'C' amended to type 'I'	KC	KC	18.11.19
P12	Pier and steelwork at large balcony amended in line with sketch issued to NS & Struer.	MK	MK	14.11.19
P11	Kitchen layout revised at client request, stair dimensions added window openings corrected, naps relocated	KC	MK	06.11.19
P10	Changed to monochrome, kitchen layouts added, window and door refs added	KC	MK	31.10.19
P09	Door dimensions revised, structural slab levels added, cavity resized	KC	MK	08.10.19
P08	Type B terrace doors, half brick rebate added, Type E Balcony opening width reduced to under 4400 as per balcony workshop discussion. Internal RWP positions amended following IKO workshop.	MK	MK	24.09.19
rev.	amendment	by	Checked	date

HYPOSTYLE

HYPOSTYLE Architects
www.hypostyle.co.uk

Glasgow 49 St. Vincent Crescent G3 8NG
T: 0141 204 4441 F: 0141 204 4897 E: glasgow@hypostyle.co.uk
Edinburgh 4 Sandport Place EH6 6EU
T: 0131 555 0888 F: 0131 553 4450 E: edinburgh@hypostyle.co.uk

client

client's ref

project

**Pacific Quay,
Glasgow**

drawing

**Block E
Second Floor GA Plans**

scale 1:50

page size A1

date 06.08.19

job ref 3693


drawing num 20_142

checked MK

date

rev

P15

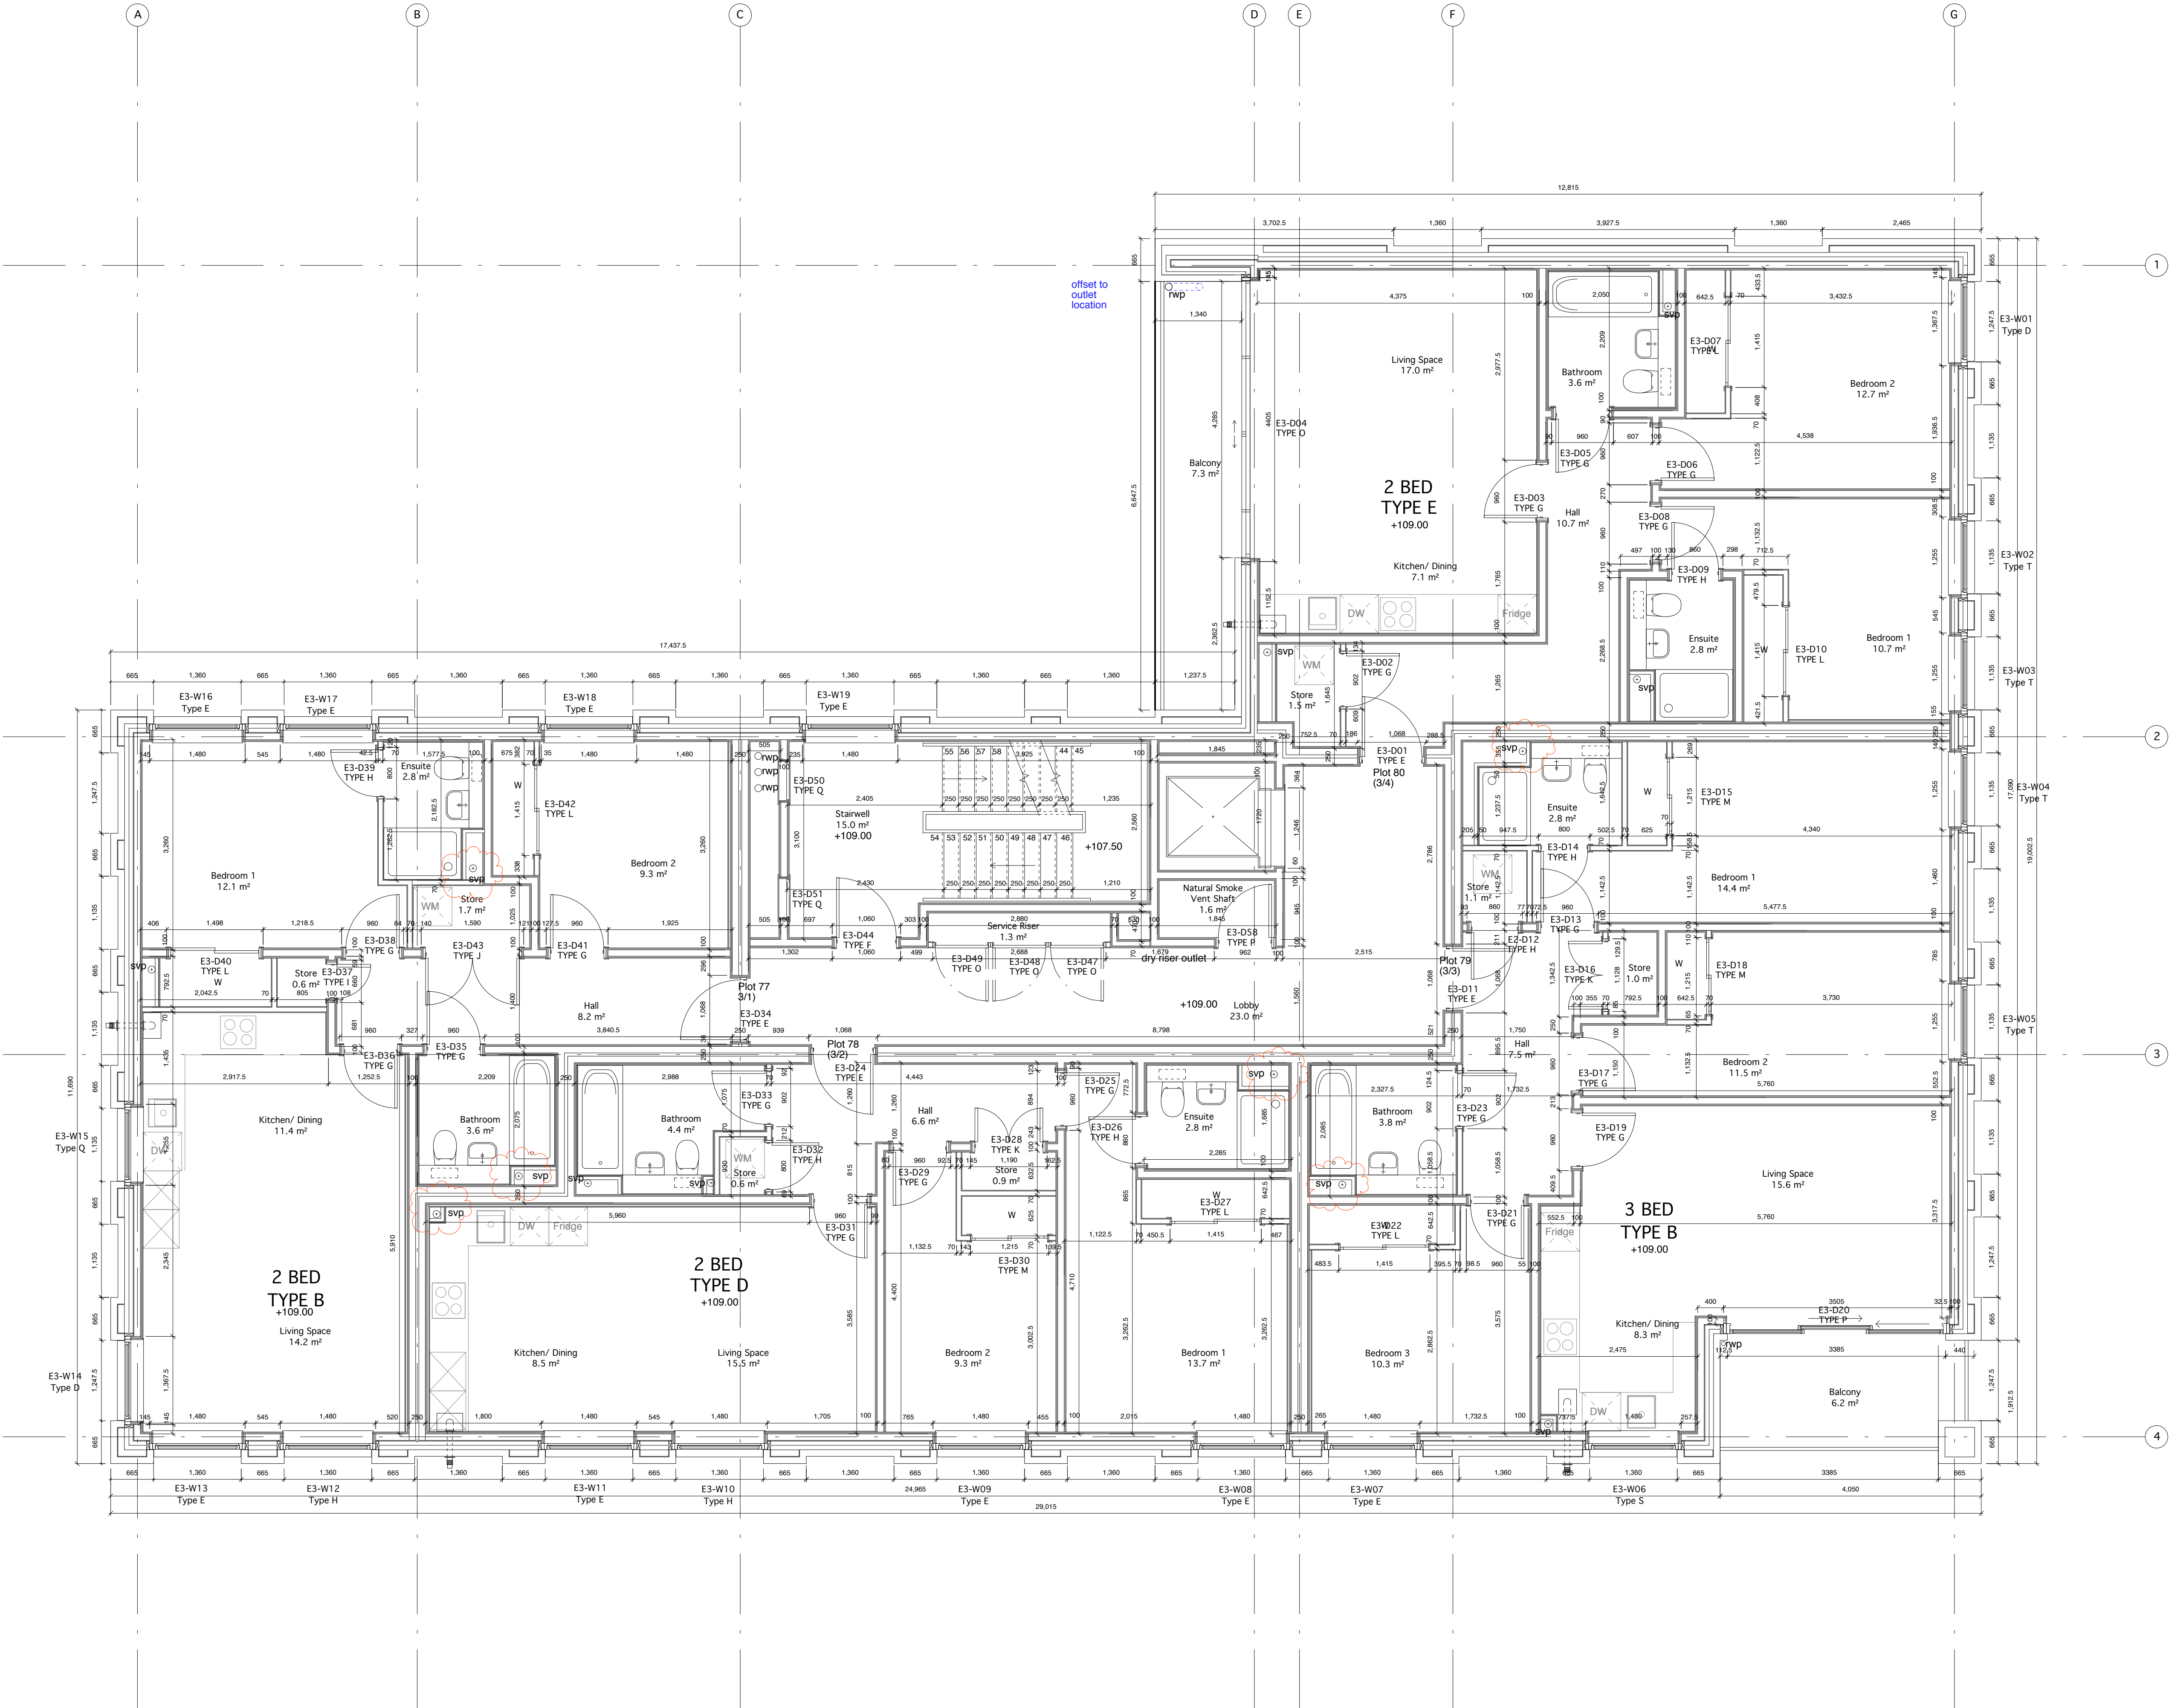

notes

This drawing is the copyright © property of Hypostyle Designs Ltd - no copying or distribution of this drawing or any part thereof is permitted without prior written permission.

Do not scale from this drawing. All existing dimensions to be checked on site prior to commencement of works or manufacturing of components.

Any discrepancies to be brought to the attention of the architect - if in doubt, ask.

S.H.E - safety health & environment information

1.

2.

3.

symbol indicates location & ref. no. of residual hazard/risk

Internal dimensions to steel frame
External dimensions to masonry

P15	SVP locations amended to respect NS clear zone.	GMCA/KC	25.11.19
P14	Kitchen layouts revised, SVP added	KC	21.11.19
P13	Window dimensions corrected to type D. Window type 'C' amended to type 'T'	KC	18.11.19
P12	Pier and steelwork at large balcony amended in line with sketch issued to NS & Struer.	MK	14.11.19
P11	Kitchen layout revised at client request, stair dimensions added window openings corrected, naps relocated	MK	06.11.19
P10	Changed to monochrome, kitchen layouts added, window and door refs added	KC	31.10.19
P09	Door dimensions revised, structural slab levels added, cavity resized	KC	08.10.19
P08	Type B terrace doors, half brick rebate added. Type E Balcony opening width reduced to under 4400 as per balcony workshop discussion. Internal RWP positions amended following IKO workshop.	MK	24.09.19
rev.	amendment	by	Checked date

HYPOSTYLE

HYPOSTYLE Architects
www.hypostyle.co.uk

Glasgow 49 St. Vincent Crescent G3 8NG
T: 0141 204 4441 F: 0141 204 4897 E: glasgow@hypostyle.co.uk
Edinburgh 4 Sandport Place EH6 6EU
T: 0131 555 0888 F: 0131 553 4450 E: edinburgh@hypostyle.co.uk

client

CALA Homes

client's ref

project

**Pacific Quay,
Glasgow**

drawing

**Block E
Third Floor GA Plans**

scale 1:50

page size A1 drawn KC checked MK
date 08.08.19 date

job ref 3693 drawing num 20_143 rev P15