

Drawing to be scaled for planning purposes only. Dimensions must not be scaled from this drawing for construction. All dimensions to be checked prior to commencing work or prior to any components being manufactured. Any discrepancy to be reported. All work and material to comply fully with all current & relevant British Standards Codes of Practice, building regulations, IEE regulations and all HSE acts.


Revisions		
Rev	Date	Comment
B	Jan 25	Plots 05-08 amended to MMR. Plots 77-78 amended to SE CRE parking within fenced plots identified in green/blue hatch
C	Jan 25	Plots 40,46,105, 131, 135 & 180
D	June 25	Updated shared path ownership. Plots 152, 153 & 164, general layout boundaries updated to construction phase site layout plan
E	Aug 25	Plots 146-151 rear footpath identified as shared
F	Sept 25	Legend updated to colours and notes re Fencing
G	Dec 25	Plot number corrected - 52 to 162 re Fencing
H	Jan 26	Plot boundaries corrected - 52 to 162 re Fencing
I	Mar 26	Boundary updates to plots 26, 27, 76 per PIP/Legals comments. common areas setts indicated in red
J	July 26	Layout amended: Corrm 57 parking, Plot 86/87 parking, Plots 146-151

Development boundary

Legend

- | | |
|---|--|
|  | Development boundary |
|  | Individual plot boundary |
|  | Adopted roads |
|  | Adopted footpaths |
|  | Adopted verge |
|  | Shared external area between plots 41-47 inclusive (<i>Car parking areas</i>) |
|  | Shared external area between plots 48, 49 & 50 (<i>footpath</i>) |
|  | Shared external area between plots 48-63 inclusive (<i>Car parking areas</i>) |
|  | Shared external area between plots 156-159 inclusive (<i>footpath</i>) |
|  | Shared external area between plots 146-151 inclusive (<i>footpath</i>) |
|  | Shared external area between plots 156-157 inclusive (<i>footpath</i>) |
|  | Shared external area between plots 158-159 inclusive (<i>footpath</i>) |
|  | Area Owned by EDC (landowner) with rights of access provided to plots 178 & 179 |
|  | Parking space (1no) for Plot 45 |
|  | Parking space (1no) for Plot 125 |
|  | Parking space (1no) for Plot 132 |
|  | Parking space (1no) for Plot 179 |
|  | Units owned by Castle Rock Edinvar |
|  | Common stairwell to apartments - owned by Castle Rock Edinvar |
|  | Car parking area road surface owned by CRE with access rights to adjacent plots for access |
|  | Car parking spaces owned by CRE |
|  | External spaces owned by CRE (<i>Hard and soft landscaping to internal courtyards</i>) |
|  | EV charging point |
|  | Adopted Street Lighting Column (<i>adopted road areas</i>) |
|  | Private Street Lighting Column (<i>Private Parking courtyards</i>) |

Notes :
Site Grid Reference: NH783506
E: 278389 N: 850607
all dimensions 'or thereby;

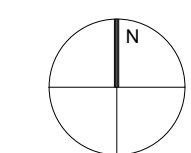

MGA ARCHITECTURE
www.mgaarchitecture.co.uk

Project
Residential Development
Geddes Sqaure, Chapelton
Place for People

Drawing
DPA
Ground Floor West

Date Sept 23 Scales 1:500@A1


Project Nr. 1403 Drawing Nr. DPA01 Rev. i

22 Rubislaw Terrace, Aberdeen, AB10 1XE - 01224 643117 - office@m-g-a.co.uk
This drawing is copyright of Michael Gilmour Associates Ltd. ©

The development to be registered under title KNC32958 and KNC32959 and all plots within have been DPA approved.

The Keeper - 25 August 2026
Keeper for the Registers of Scotland

refer to DPA02 for Ground Floor East

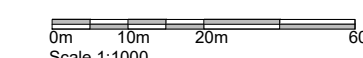


Drawing to be scaled for planning purposes only. Dimensions must not be scaled from this drawing for construction. All dimensions to be checked prior to commencing work or prior to any components being manufactured. Any discrepancy to be reported. All work and material to comply fully with all current & relevant British Standards Codes of Practice, building regulations, IEE regulations and all HSE acts.

Revisions		
Rev	Date	Comment
B	Jan 25	Plot 154/155 amended to MMR, Plots 147-150 amended to SE
C	Jan 25	CRE parking within FOG units identified in green/blue hatch (plots 40, 46, 105, 131, 135 & 180)
D	June 25	Updated shared path ownership plots 156/157 and 158/159, plot boundaries updated to plots 95, 162, 163 & 164, general layout updates to construction phase site layout plan
E	Aug 25	Plots 146-151 rear footpath identified as shared
F	Sept 25	Legend updated colours and notes re FOG parking
G	Feb 26	Colour to plots 146-151 omitted (SE plots)
H	Mar 26	Boundary updates to plots 26, 27, 76 per PIP/Legals comments - common areas setts indicated to layout
I	July 26	Layout amends; Comm 57 parking, Plot 86/87 parking, Plots 177-180 change control HTs

Legend

- Development boundary
- Individual plot boundary
- Adopted roads
- Adopted footpaths
- Adopted verge
- Shared external area between plots 41-47 inclusive (*Car parking areas*)
- Shared external area between plots 48, 49 & 50 (*footpath*)
- Shared external area between plots 48-63 inclusive (*Car parking areas*)
- Shared external area between plots 156-159 inclusive (*footpath*)
- Shared external area between plots 146-151 inclusive (*footpath*)
- Shared external area between plots 156-157 inclusive (*footpath*)
- Shared external area between plots 158-159 inclusive (*footpath*)
- Area Owned by EDC (landowner) with rights of access provided to plots 178 & 179
- Parking space (1no) for Plot 45
- Parking space (1no) for Plot 125
- Parking space (1no) for Plot 132
- Parking space (1no) for Plot 179
- Units owned by Castle Rock Edinvar
- Common stairwell to apartments - owned by Castle Rock Edinvar
- Car parking area road surface owned by CRE with access rights to adjacent plots for access
- Car parking spaces owned by CRE
- External spaces owned by CRE (*Hard and soft landscaping to internal courtyards*)
- EV charging point
- Adopted Street Lighting Column (*adopted road areas*)
- Private Street Lighting Column (*Private Parking courtyards*)

Notes :
Site Grid Reference: NH783506
E: 278389 N: 850607
all dimensions 'or thereby;

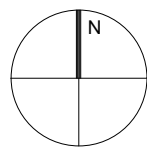

MGA ARCHITECTURE
www.mgaarchitecture.co.uk

Project
Residential Development
Geddes Sqaure, Chapelton
Place for People


Drawing
DPA
Ground Floor West

Date **Sept 23** Scales **1:500@A1**

Project Nr. **1403** Drawing Nr. **DPA01** Rev. **H**


0m 10m 20m 60m
Scale 1:1000

22 Rubislaw Terrace, Aberdeen, AB10 1XE - 01224 643117 - office@m-g-a.co.uk
This drawing is copyright of Michael Gilmore Associates Ltd. ©

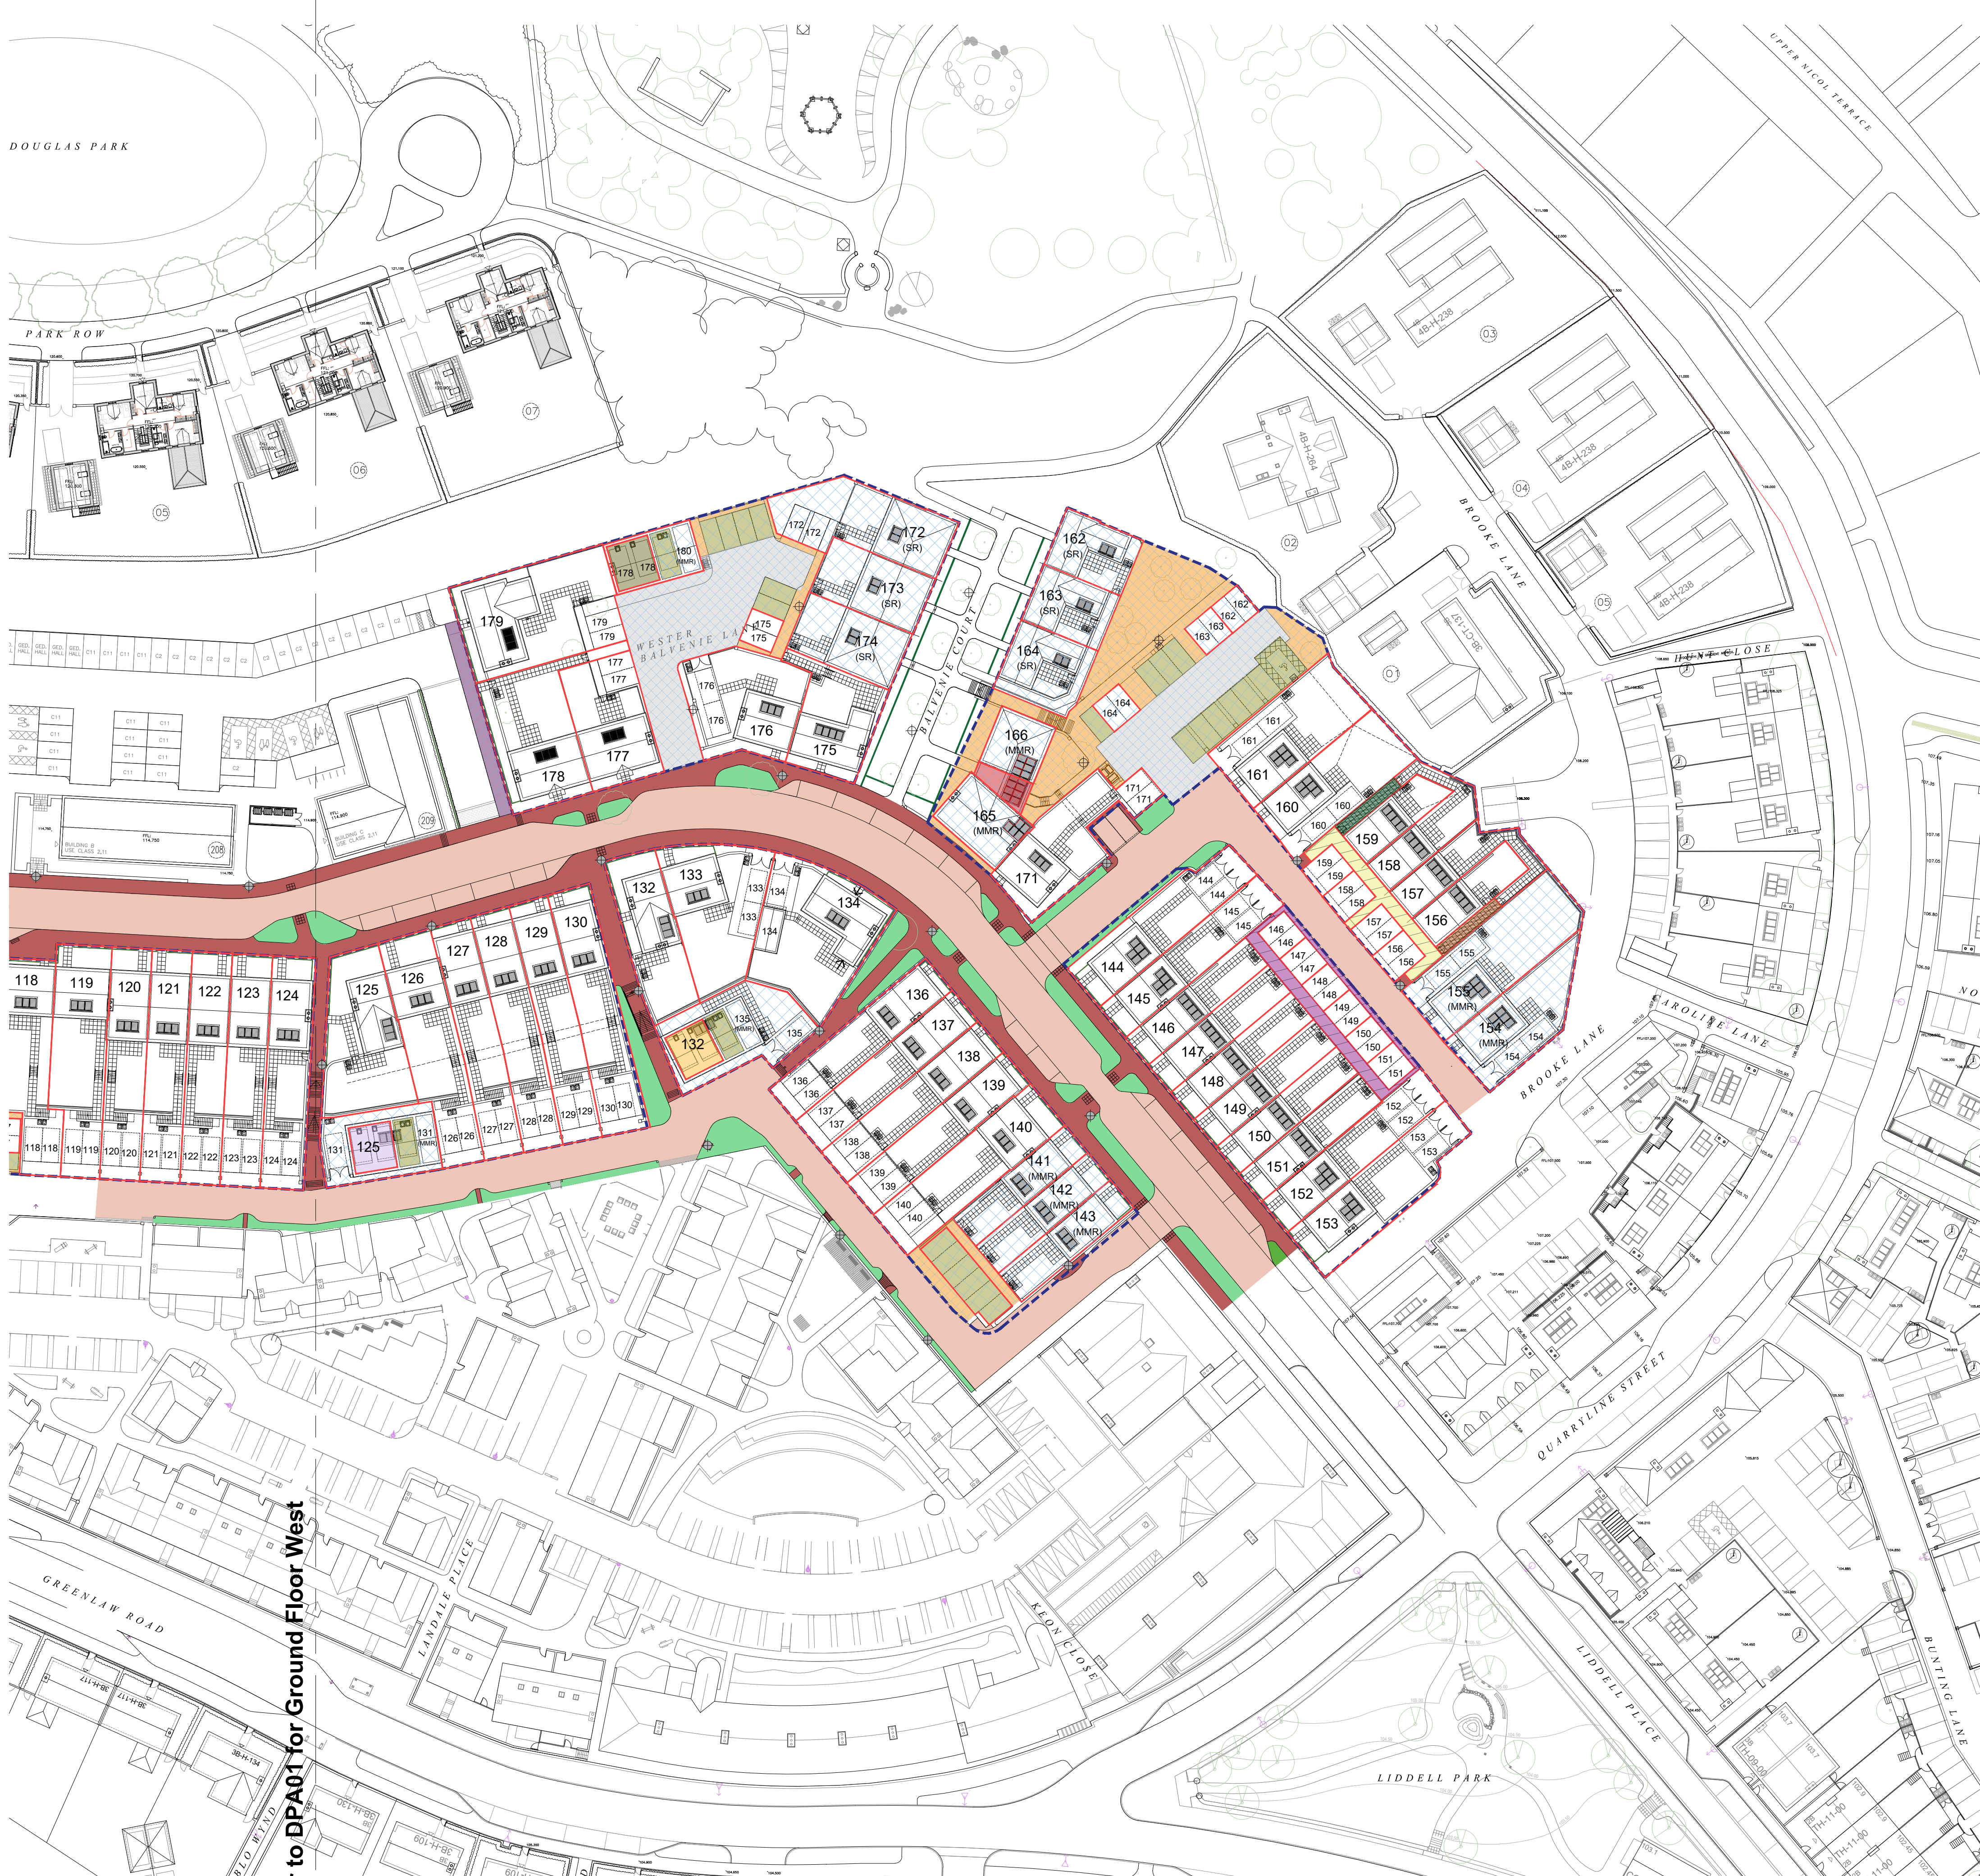

refer to DPA01 for Ground Floor West

PRIMARY SCHOOL

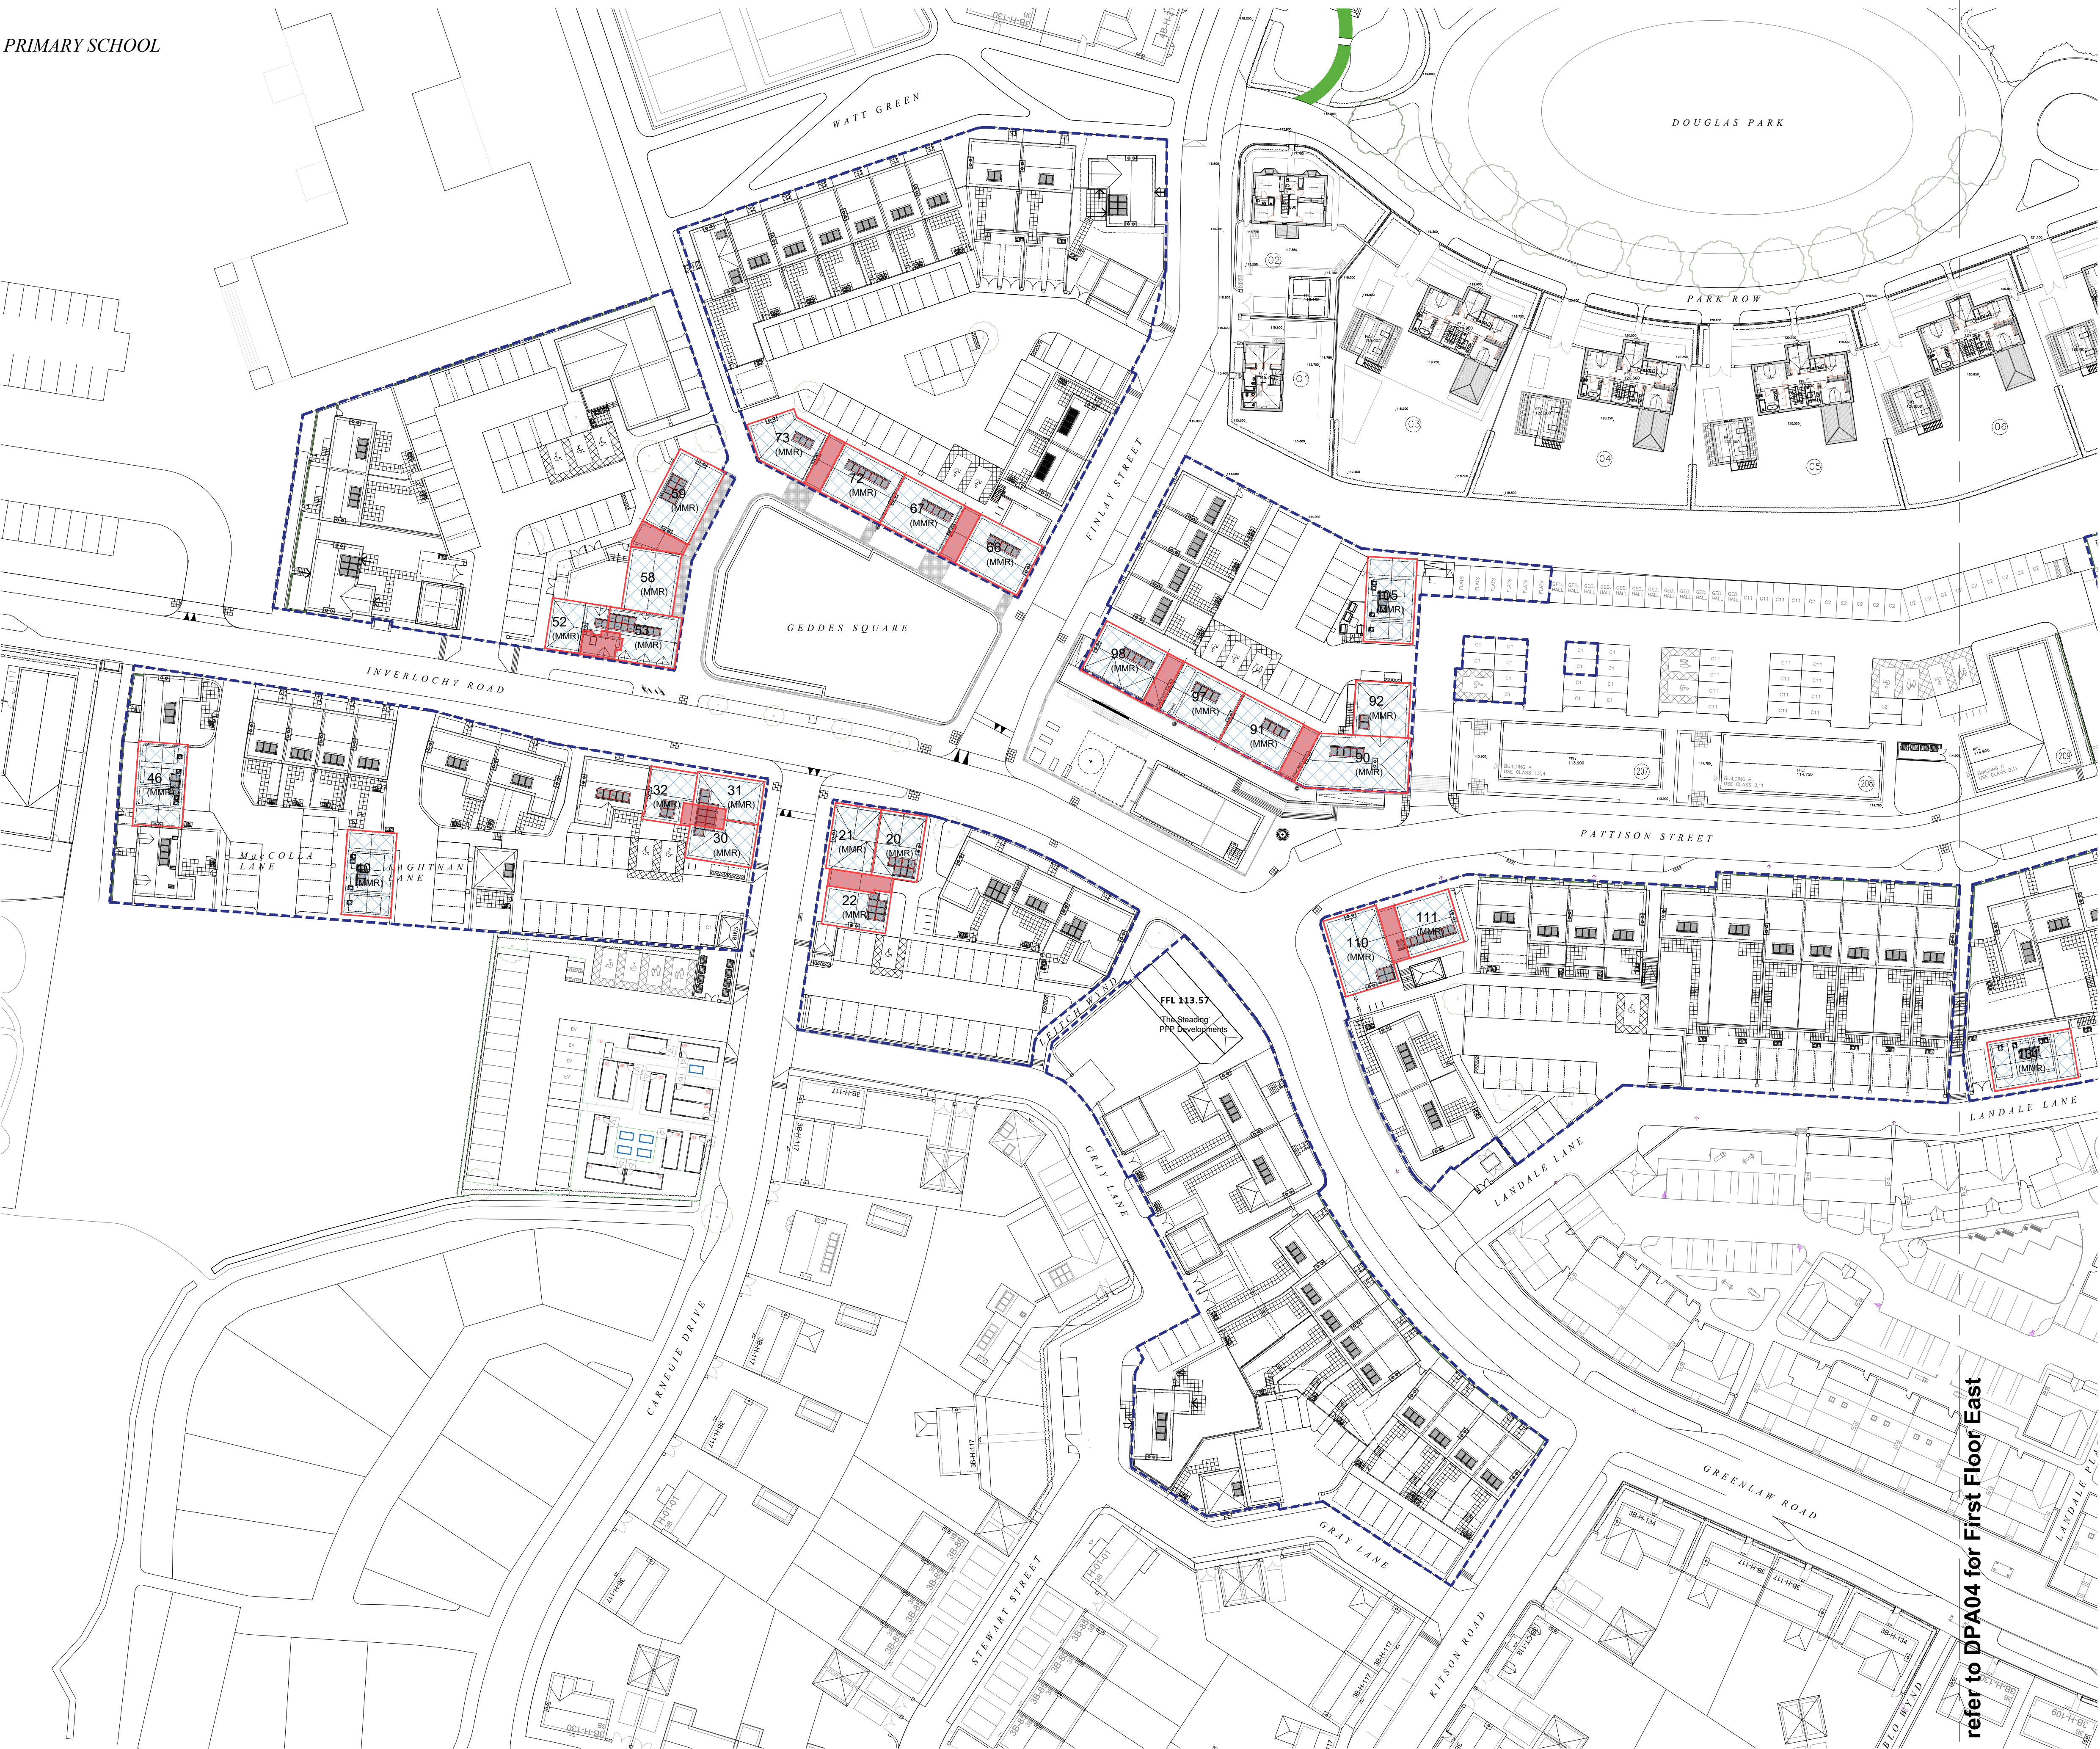

refer to DPA04 for First Floor East


Drawing to be scaled for planning purposes only. Dimensions must not be scaled from this drawing for construction. All dimensions to be checked prior to commencing work or prior to any components being manufactured. Any discrepancy to be reported. All work and material to comply fully with all current & relevant British Standards Codes of Practice, building regulations, IEE regulations and all HSE acts.

Revisions	Rev	Date	Comment
B	June 25	Updated shared path ownership plots 156/157 and 158/159, plot boundaries updated to plots 95, 162, 163 & 164, general layout updates to construction phase site layout plan	
C	Aug 25	Plots 146-151 rear footpath identified as shared	
D	Sept 25	Legend updated colours and notes re FOG parking	
E	Mar 26	Boundary updates to plots 26, 27, 76 per PIP/Legals comments, common areas sets indicated to layout	
F	July 26	Layout amends: Comm 57 parking, Plot 96/97 parking, Plots 177-180 change control HTs	

Legend

- Development boundary
- Individual plot boundary
- Adopted roads
- Adopted footpaths
- Adopted verge
- Shared external area between plots 41-47 inclusive (*Car parking areas*)
- Shared external area between plots 48, 49 & 50 (*footpath*)
- Shared external area between plots 48-63 inclusive (*Car parking areas*)
- Shared external area between plots 156-159 inclusive (*footpath*)
- Shared external area between plots 146-151 inclusive (*footpath*)
- Shared external area between plots 156-157 inclusive (*footpath*)
- Shared external area between plots 158-159 inclusive (*footpath*)
- Area Owned by EDC (landowner) with rights of access provided to plots 178 & 179
- Parking space (1no) for Plot 45
- Parking space (1no) for Plot 125
- Parking space (1no) for Plot 132
- Parking space (1no) for Plot 179
- Units owned by Castle Rock Edinvar
- Common stairwell to apartments - owned by Castle Rock Edinvar
- Car parking area road surface owned by CRE with access rights to adjacent plots for access
- Car parking spaces owned by CRE
- External spaces owned by CRE (*Hard and soft landscaping to internal courtyards*)
- EV charging point
- Adopted Street Lighting Column (*adopted road areas*)
- Private Street Lighting Column (*Private Parking courtyards*)

Notes :
Site Grid Reference: NH783506
E: 278389 N: 850607
all dimensions 'or thereby';

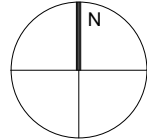

MGA ARCHITECTURE
www.mgaarchitecture.co.uk

Project
Residential Development
Geddes Sqaure, Chapelton
Place for People

Drawing
DPA
First Floor West

Date Sept 23 Scales 1:500@A1

Project Nr. 1403 Drawing Nr. DPA03 Rev. E

22 Rubislaw Terrace, Aberdeen, AB10 1XE - 01224 643117 - office@m-g-a.co.uk
Scale 1:1000
This drawing is copyright of Michael Gilmore Associates Ltd. ©


Drawing to be scaled for planning purposes only. Dimensions must not be scaled from this drawing for construction. All dimensions to be checked prior to commencing work or prior to any components being manufactured. Any discrepancy to be reported. All work and material to comply fully with all current & relevant British Standards Codes of Practice, building regulations, IEE regulations and all HSE acts.

Revisions			
Rev	Date	Comment	
B	June 25	Updated shared path ownership plots 156/157 and 158/159, plot boundaries updated to plots 85, 162, 163 & 164, general layout updates to construction phase site layout plan	
C	Aug 25	Plots 146-151 rear footpath identified as shared	
D	Sept 25	Legend updated colours and notes re FOG parking	
E	Mar 26	Boundary updates to plots 26, 27, 76 per PIP/Legals comments, common areas setts indicated to layout	
F	July 26	Layout amends: Comm 57 parking, Plot 66/67 parking, Plots 177-180 change control HTS	

Legend

- Development boundary
- Individual plot boundary
- Adopted roads
- Adopted footpaths
- Adopted verge
- Shared external area between plots 41-47 inclusive (*Car parking areas*)
- Shared external area between plots 48, 49 & 50 (*footpath*)
- Shared external area between plots 48-63 inclusive (*Car parking areas*)
- Shared external area between plots 156-159 inclusive (*footpath*)
- Shared external area between plots 146-151 inclusive (*footpath*)
- Shared external area between plots 156-157 inclusive (*footpath*)
- Shared external area between plots 158-159 inclusive (*footpath*)
- Area Owned by EDC (landowner) with rights of access provided to plots 178 & 179
- Parking space (1no) for Plot 45
- Parking space (1no) for Plot 125
- Parking space (1no) for Plot 132
- Parking space (1no) for Plot 179
- Units owned by Castle Rock Edinvar
- Common stairwell to apartments - owned by Castle Rock Edinvar
- Car parking area road surface owned by CRE with access rights to adjacent plots for access
- Car parking spaces owned by CRE
- External spaces owned by CRE (*Hard and soft landscaping to internal courtyards*)
- EV charging point
- Adopted Street Lighting Column (*adopted road areas*)
- Private Street Lighting Column (*Private Parking courtyards*)

Notes :
Site Grid Reference: NH783506
E: 278389 N: 850607
all dimensions 'or thereby';

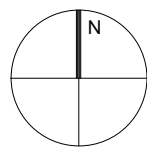

MGA ARCHITECTURE
www.mgaarchitecture.co.uk

Project
Residential Development
Geddes Sqaure, Chapelton
Place for People


Drawing
DPA
First Floor West

Date **Sept 23** Scales **1:500@A1**

Project Nr. **1403** Drawing Nr. **DPA04** Rev. **E**


0m 10m 20m 60m
Scale 1:1000

22 Rubislaw Terrace, Aberdeen, AB10 1XE - 01224 643117 - office@m-g-a.co.uk
This drawing is copyright of Michael Gilmour Associates Ltd. ©

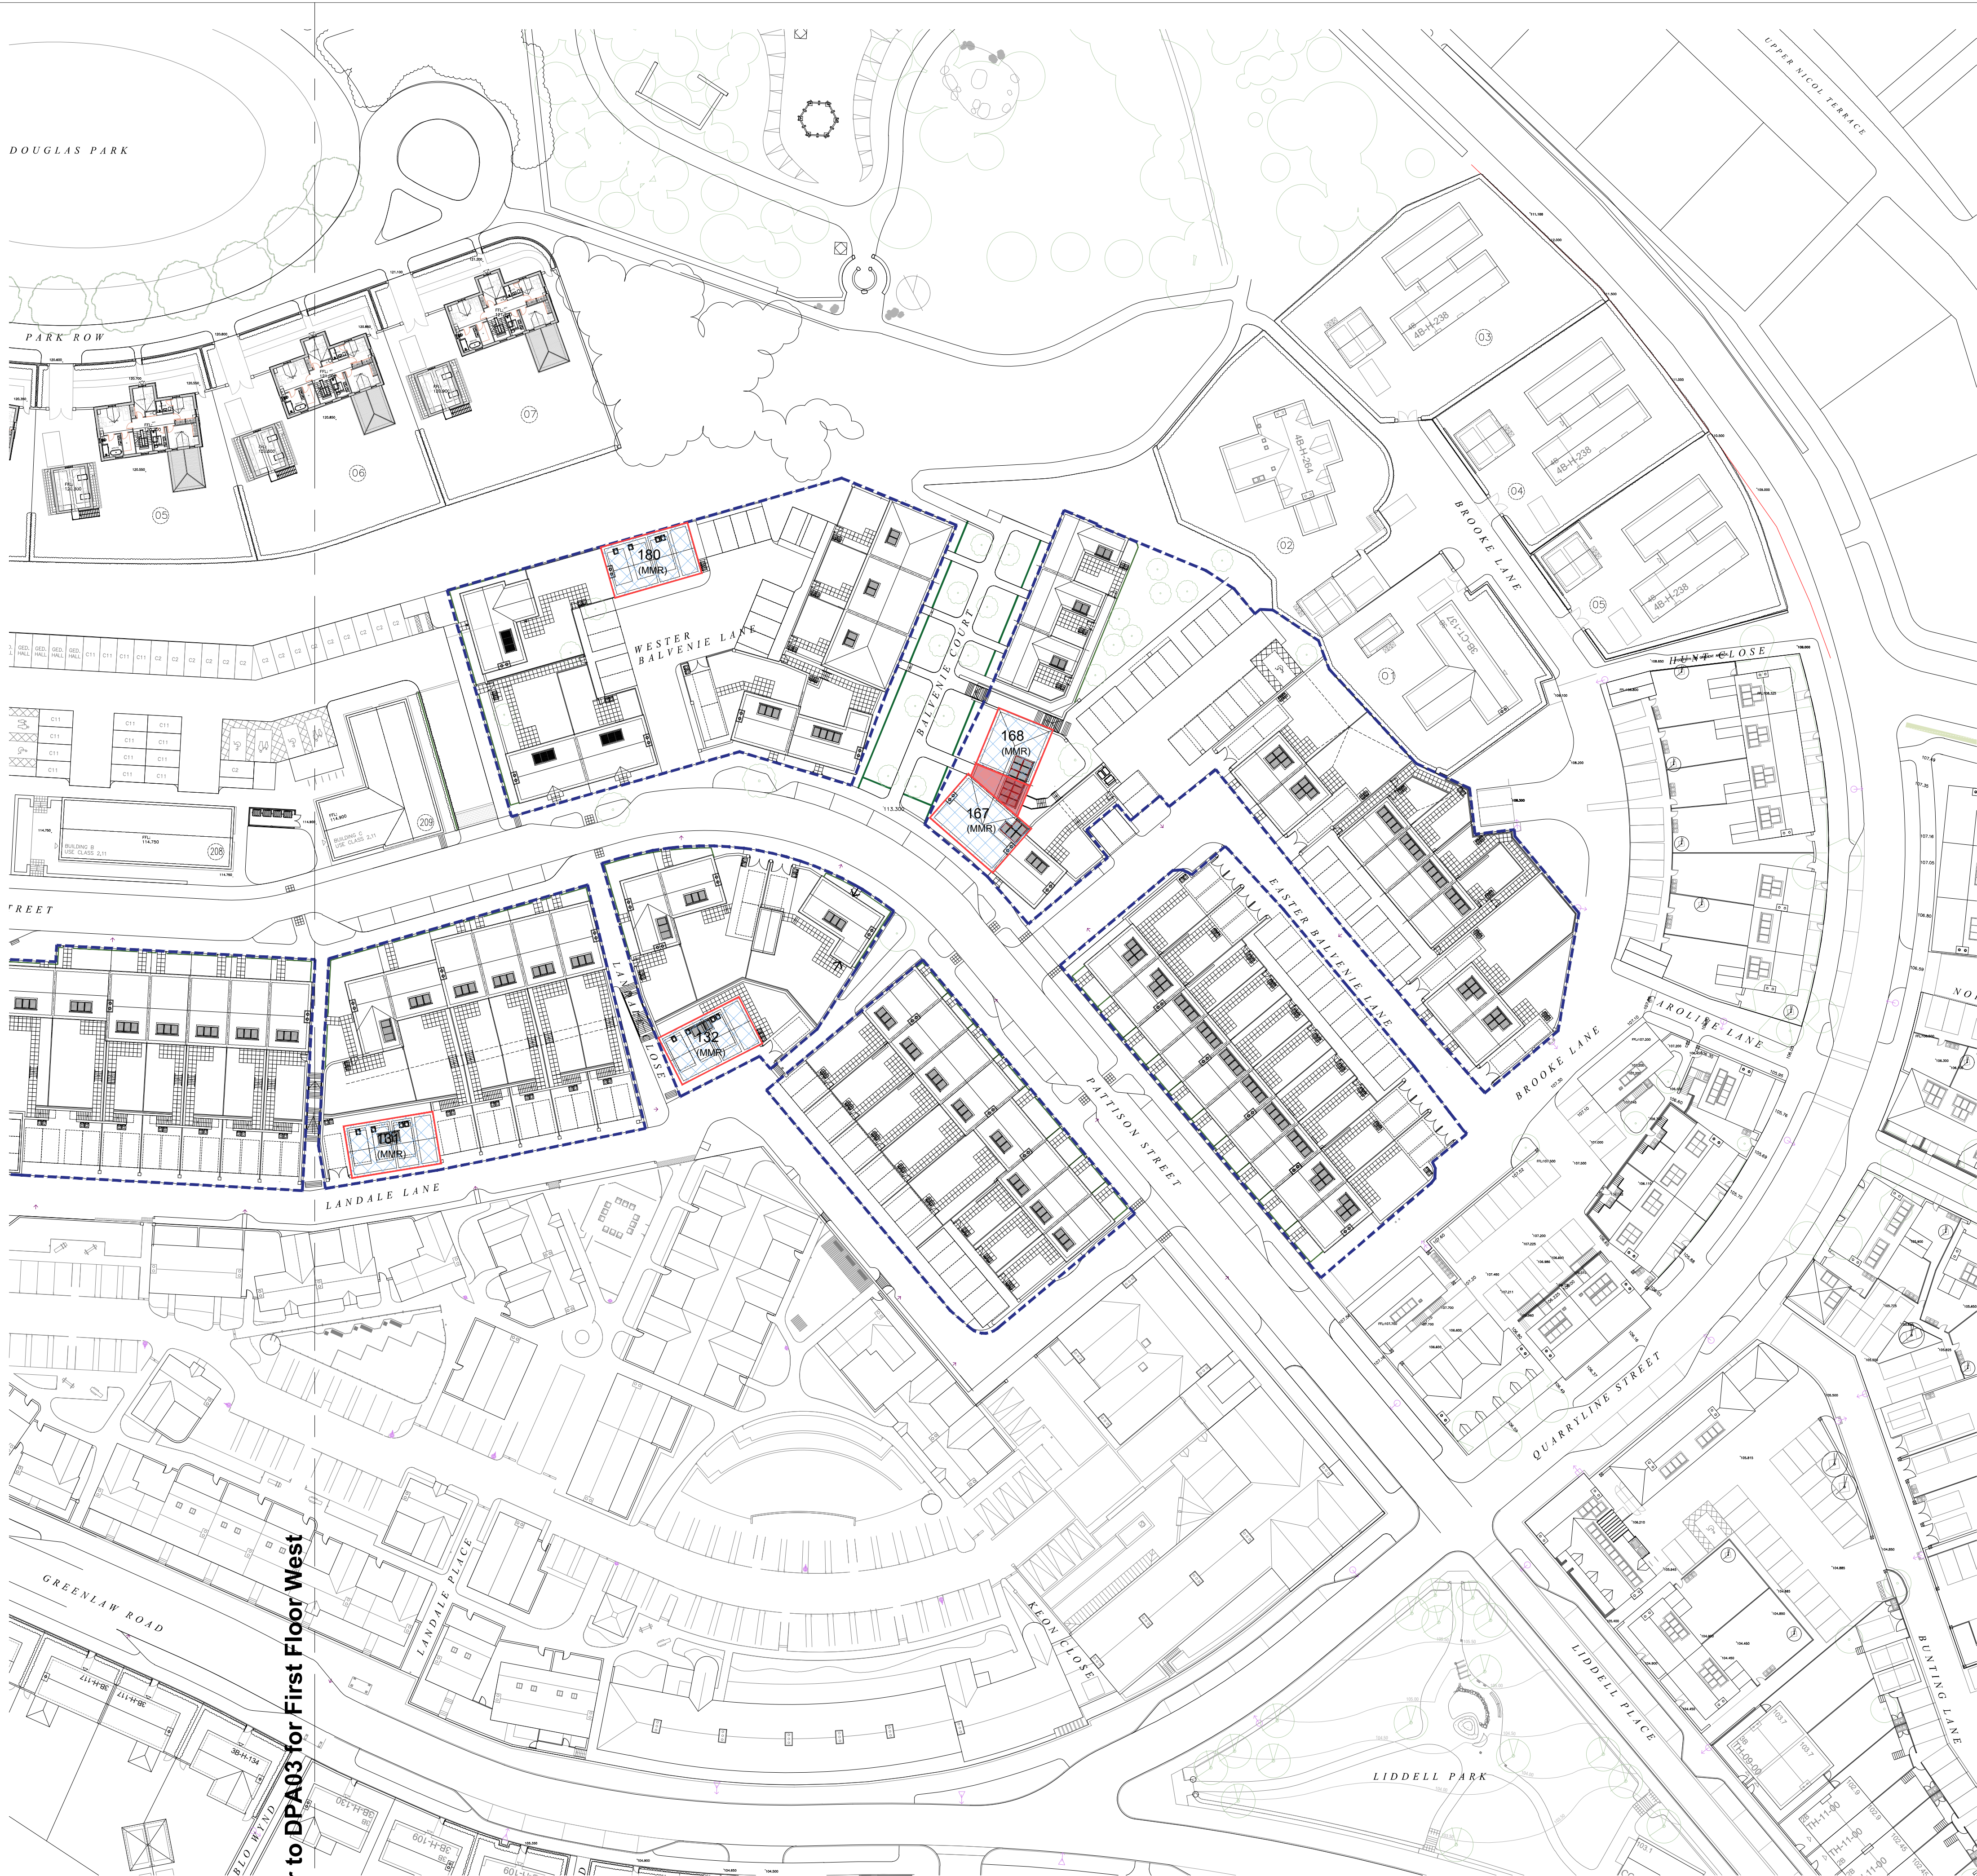

refer to DPA03 for First Floor West

PRIMARY SCHOOL

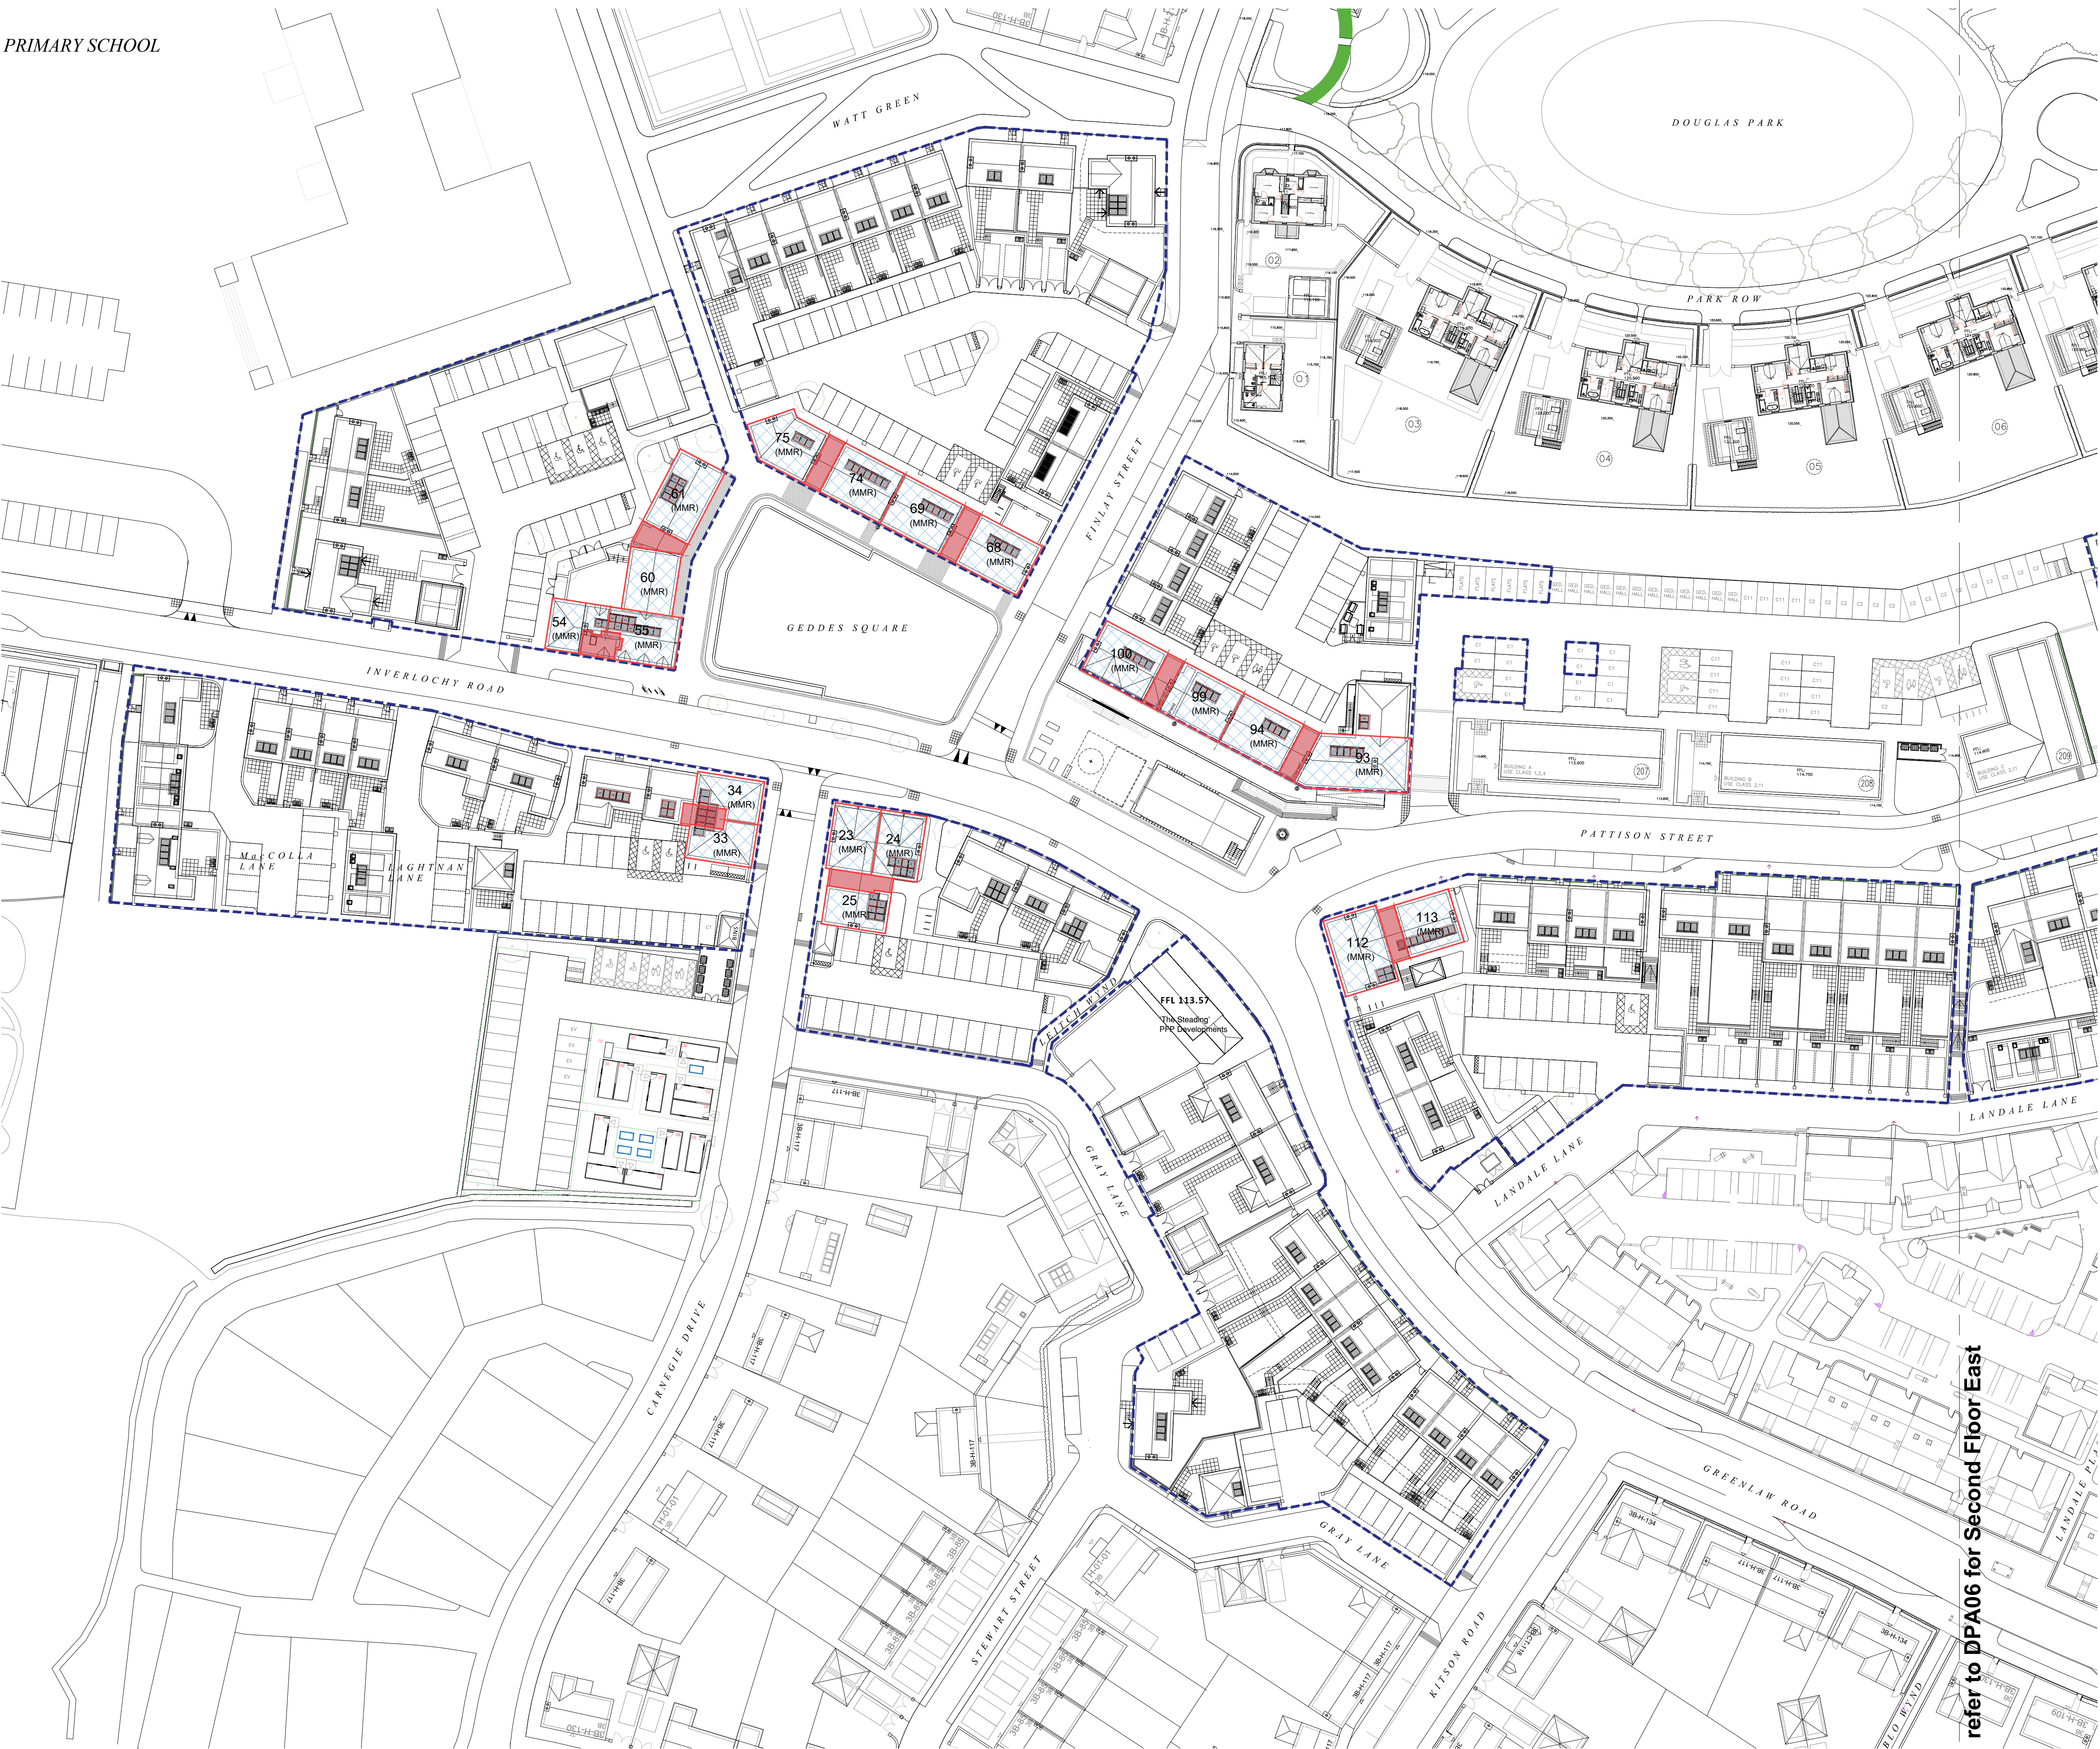

Drawing to be scaled for planning purposes only. Dimensions must not be scaled from this drawing for construction. All dimensions to be checked prior to commencing work or prior to any components being manufactured. Any discrepancy to be reported. All work and material to comply fully with all current & relevant British Standards Codes of Practice, building regulations, IEE regulations and all HSE acts.

Revisions	Rev	Date	Comment
B	June 25	Updated shared path ownership plots 156/157 and 158/159, plot boundaries updated to plots 95, 162, 163 & 164, general layout updates to construction phase site layout plan	
C	Aug 25	Plots 146-151 rear footpath identified as shared	
D	Sept 25	Legend updated colours and notes re FOG parking	
E	Mar 26	Boundary updates to plots 26, 27, 76 per PIP/Legals comments, common areas sets indicated to layout	
F	July 26	Layout amends: Comm 57 parking, Plot 96/97 parking, Plots 177-180 change control HTs	

- Legend**
- Development boundary
 - Individual plot boundary
 - Adopted roads
 - Adopted footpaths
 - Adopted verge
 - Shared external area between plots 41-47 inclusive (*Car parking areas*)
 - Shared external area between plots 48, 49 & 50 (*footpath*)
 - Shared external area between plots 48-63 inclusive (*Car parking areas*)
 - Shared external area between plots 156-159 inclusive (*footpath*)
 - Shared external area between plots 146-151 inclusive (*footpath*)
 - Shared external area between plots 156-157 inclusive (*footpath*)
 - Shared external area between plots 158-159 inclusive (*footpath*)
 - Area Owned by EDC (landowner) with rights of access provided to plots 178 & 179
 - Parking space (1no) for Plot 45
 - Parking space (1no) for Plot 125
 - Parking space (1no) for Plot 132
 - Parking space (1no) for Plot 179
 - Units owned by Castle Rock Edinvar
 - Common stairwell to apartments - owned by Castle Rock Edinvar
 - Car parking area road surface owned by CRE with access rights to adjacent plots for access
 - Car parking spaces owned by CRE
 - External spaces owned by CRE (*Hard and soft landscaping to internal courtyards*)
 - EV charging point
 - Adopted Street Lighting Column (*adopted road areas*)
 - Private Street Lighting Column (*Private Parking courtyards*)

Notes :
Site Grid Reference: NH783506
E: 278389 N: 850607
all dimensions 'or thereby';

MGA ARCHITECTURE
www.mgaarchitecture.co.uk

Project
Residential Development
Geddes Sqaure, Chapelton
Place for People

Drawing
DPA
Second Floor West

Date **Sept 23** Scales **1:500@A1**

Project Nr. **1403** Drawing Nr. **DPA05** Rev. **E**


Drawing to be scaled for planning purposes only. Dimensions must not be scaled from this drawing for construction. All dimensions to be checked prior to commencing work or prior to any components being manufactured. Any discrepancy to be reported. All work and material to comply fully with all current & relevant British Standards Codes of Practice, building regulations, IEE regulations and all HSE acts.

Revisions		
Rev	Date	Comment
B	June 25	Updated shared path ownership plots 156/157 and 158/159, plot boundaries updated to plots 95, 162, 163 & 164, general layout updates to construction phase site layout plan
C	Aug 25	Plots 146-151 rear footpath identified as shared
D	Sept 25	Legend updated colours and notes re FOG parking
E	Mar 26	Boundary updates to plots 26, 27, 76 per PIP/Legals comments, common areas sets indicated to layout
F	July 26	Layout amends: Comm 57 parking, Plot 66/67 parking, Plots 177-180 change control HTs

Legend

- Development boundary
- Individual plot boundary
- Adopted roads
- Adopted footpaths
- Adopted verge
- Shared external area between plots 41-47 inclusive (*Car parking areas*)
- Shared external area between plots 48, 49 & 50 (*footpath*)
- Shared external area between plots 48-63 inclusive (*Car parking areas*)
- Shared external area between plots 156-159 inclusive (*footpath*)
- Shared external area between plots 146-151 inclusive (*footpath*)
- Shared external area between plots 156-157 inclusive (*footpath*)
- Shared external area between plots 158-159 inclusive (*footpath*)
- Area Owned by EDC (landowner) with rights of access provided to plots 178 & 179
- Parking space (1no) for Plot 45
- Parking space (1no) for Plot 125
- Parking space (1no) for Plot 132
- Parking space (1no) for Plot 179
- Units owned by Castle Rock Edinvar
- Common stairwell to apartments - owned by Castle Rock Edinvar
- Car parking area road surface owned by CRE with access rights to adjacent plots for access
- Car parking spaces owned by CRE
- External spaces owned by CRE (*Hard and soft landscaping to internal courtyards*)
- EV charging point
- Adopted Street Lighting Column (*adopted road areas*)
- Private Street Lighting Column (*Private Parking courtyards*)

Notes :
Site Grid Reference: NH783506
E: 278389 N: 850607
all dimensions 'or thereby';

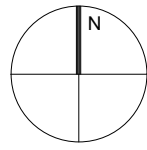

MGA ARCHITECTURE
www.mgaarchitecture.co.uk


Project
Residential Development
Geddes Sqaure, Chapelton
Place for People

Drawing
DPA
Ground Floor West


Date Sept 23 Scales 1:500@A1
Project Nr. 1403 Drawing Nr. DPA01 Rev. E

0m 10m 20m 60m
Scale 1:1000

22 Rubislaw Terrace, Aberdeen, AB10 1XE - 01224 643117 - office@m-g-a.co.uk
This drawing is copyright of Michael Gilmore Associates Ltd. ©

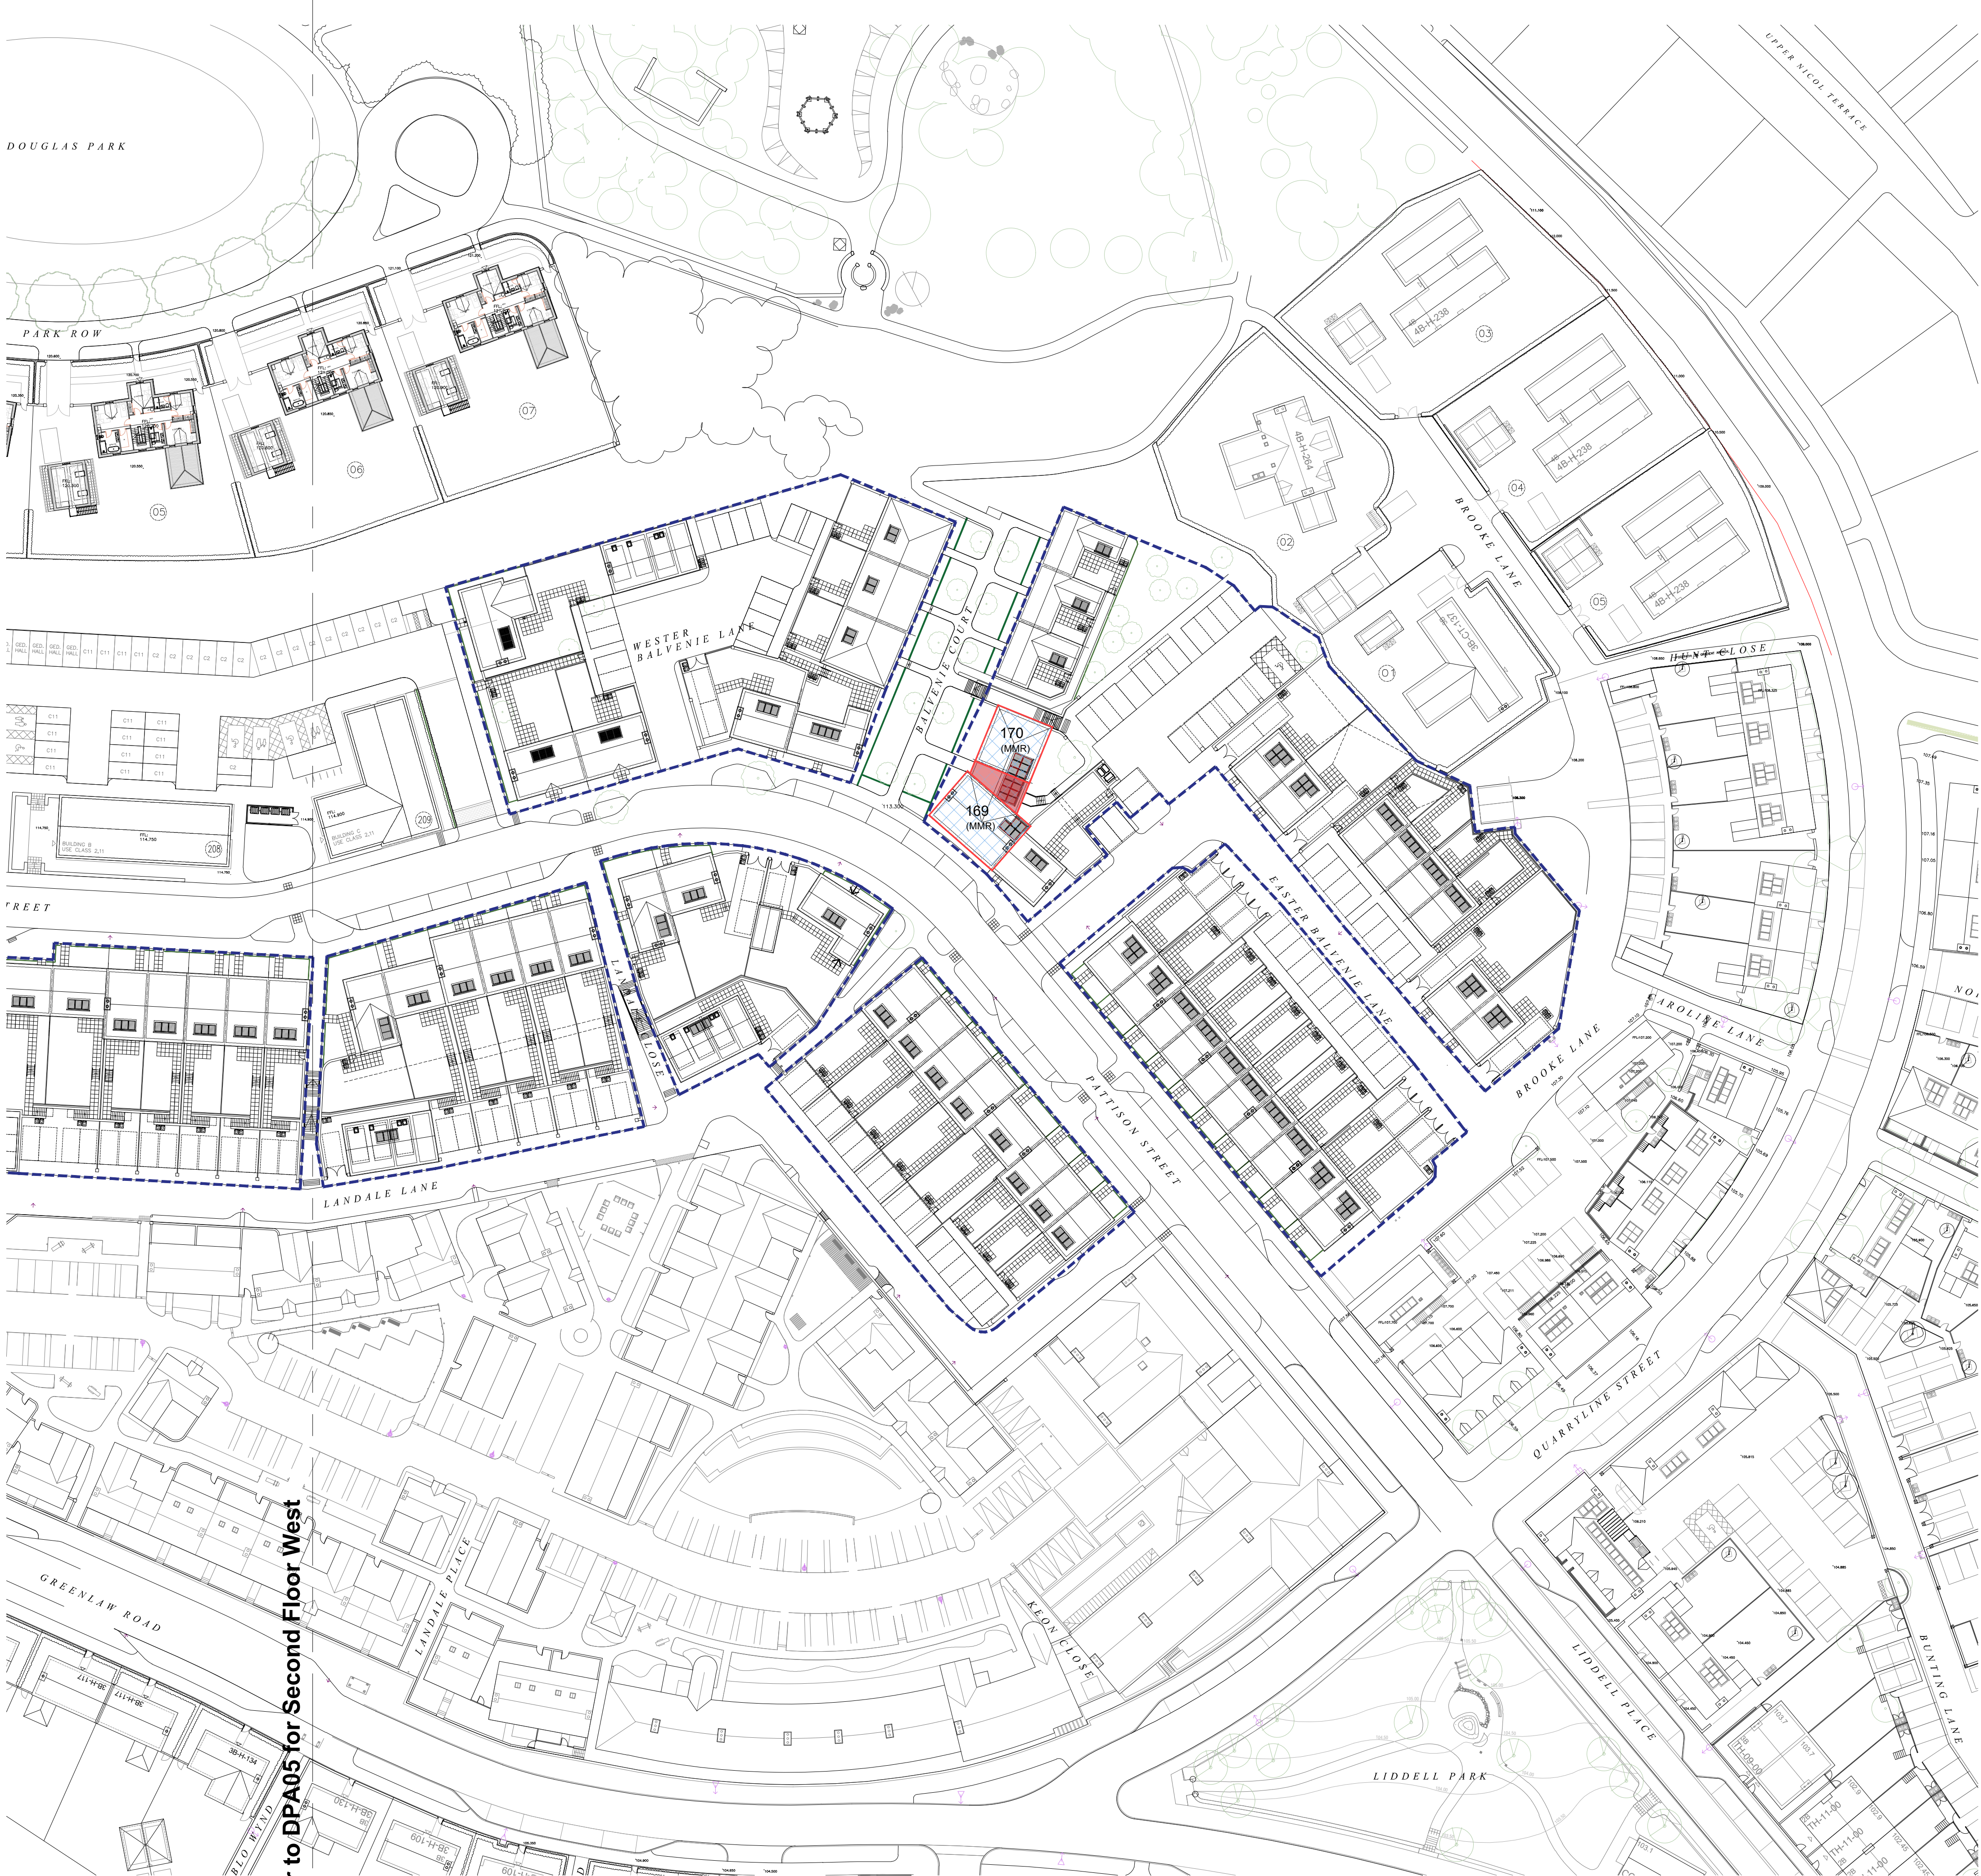

refer to DPA05 for Second Floor West

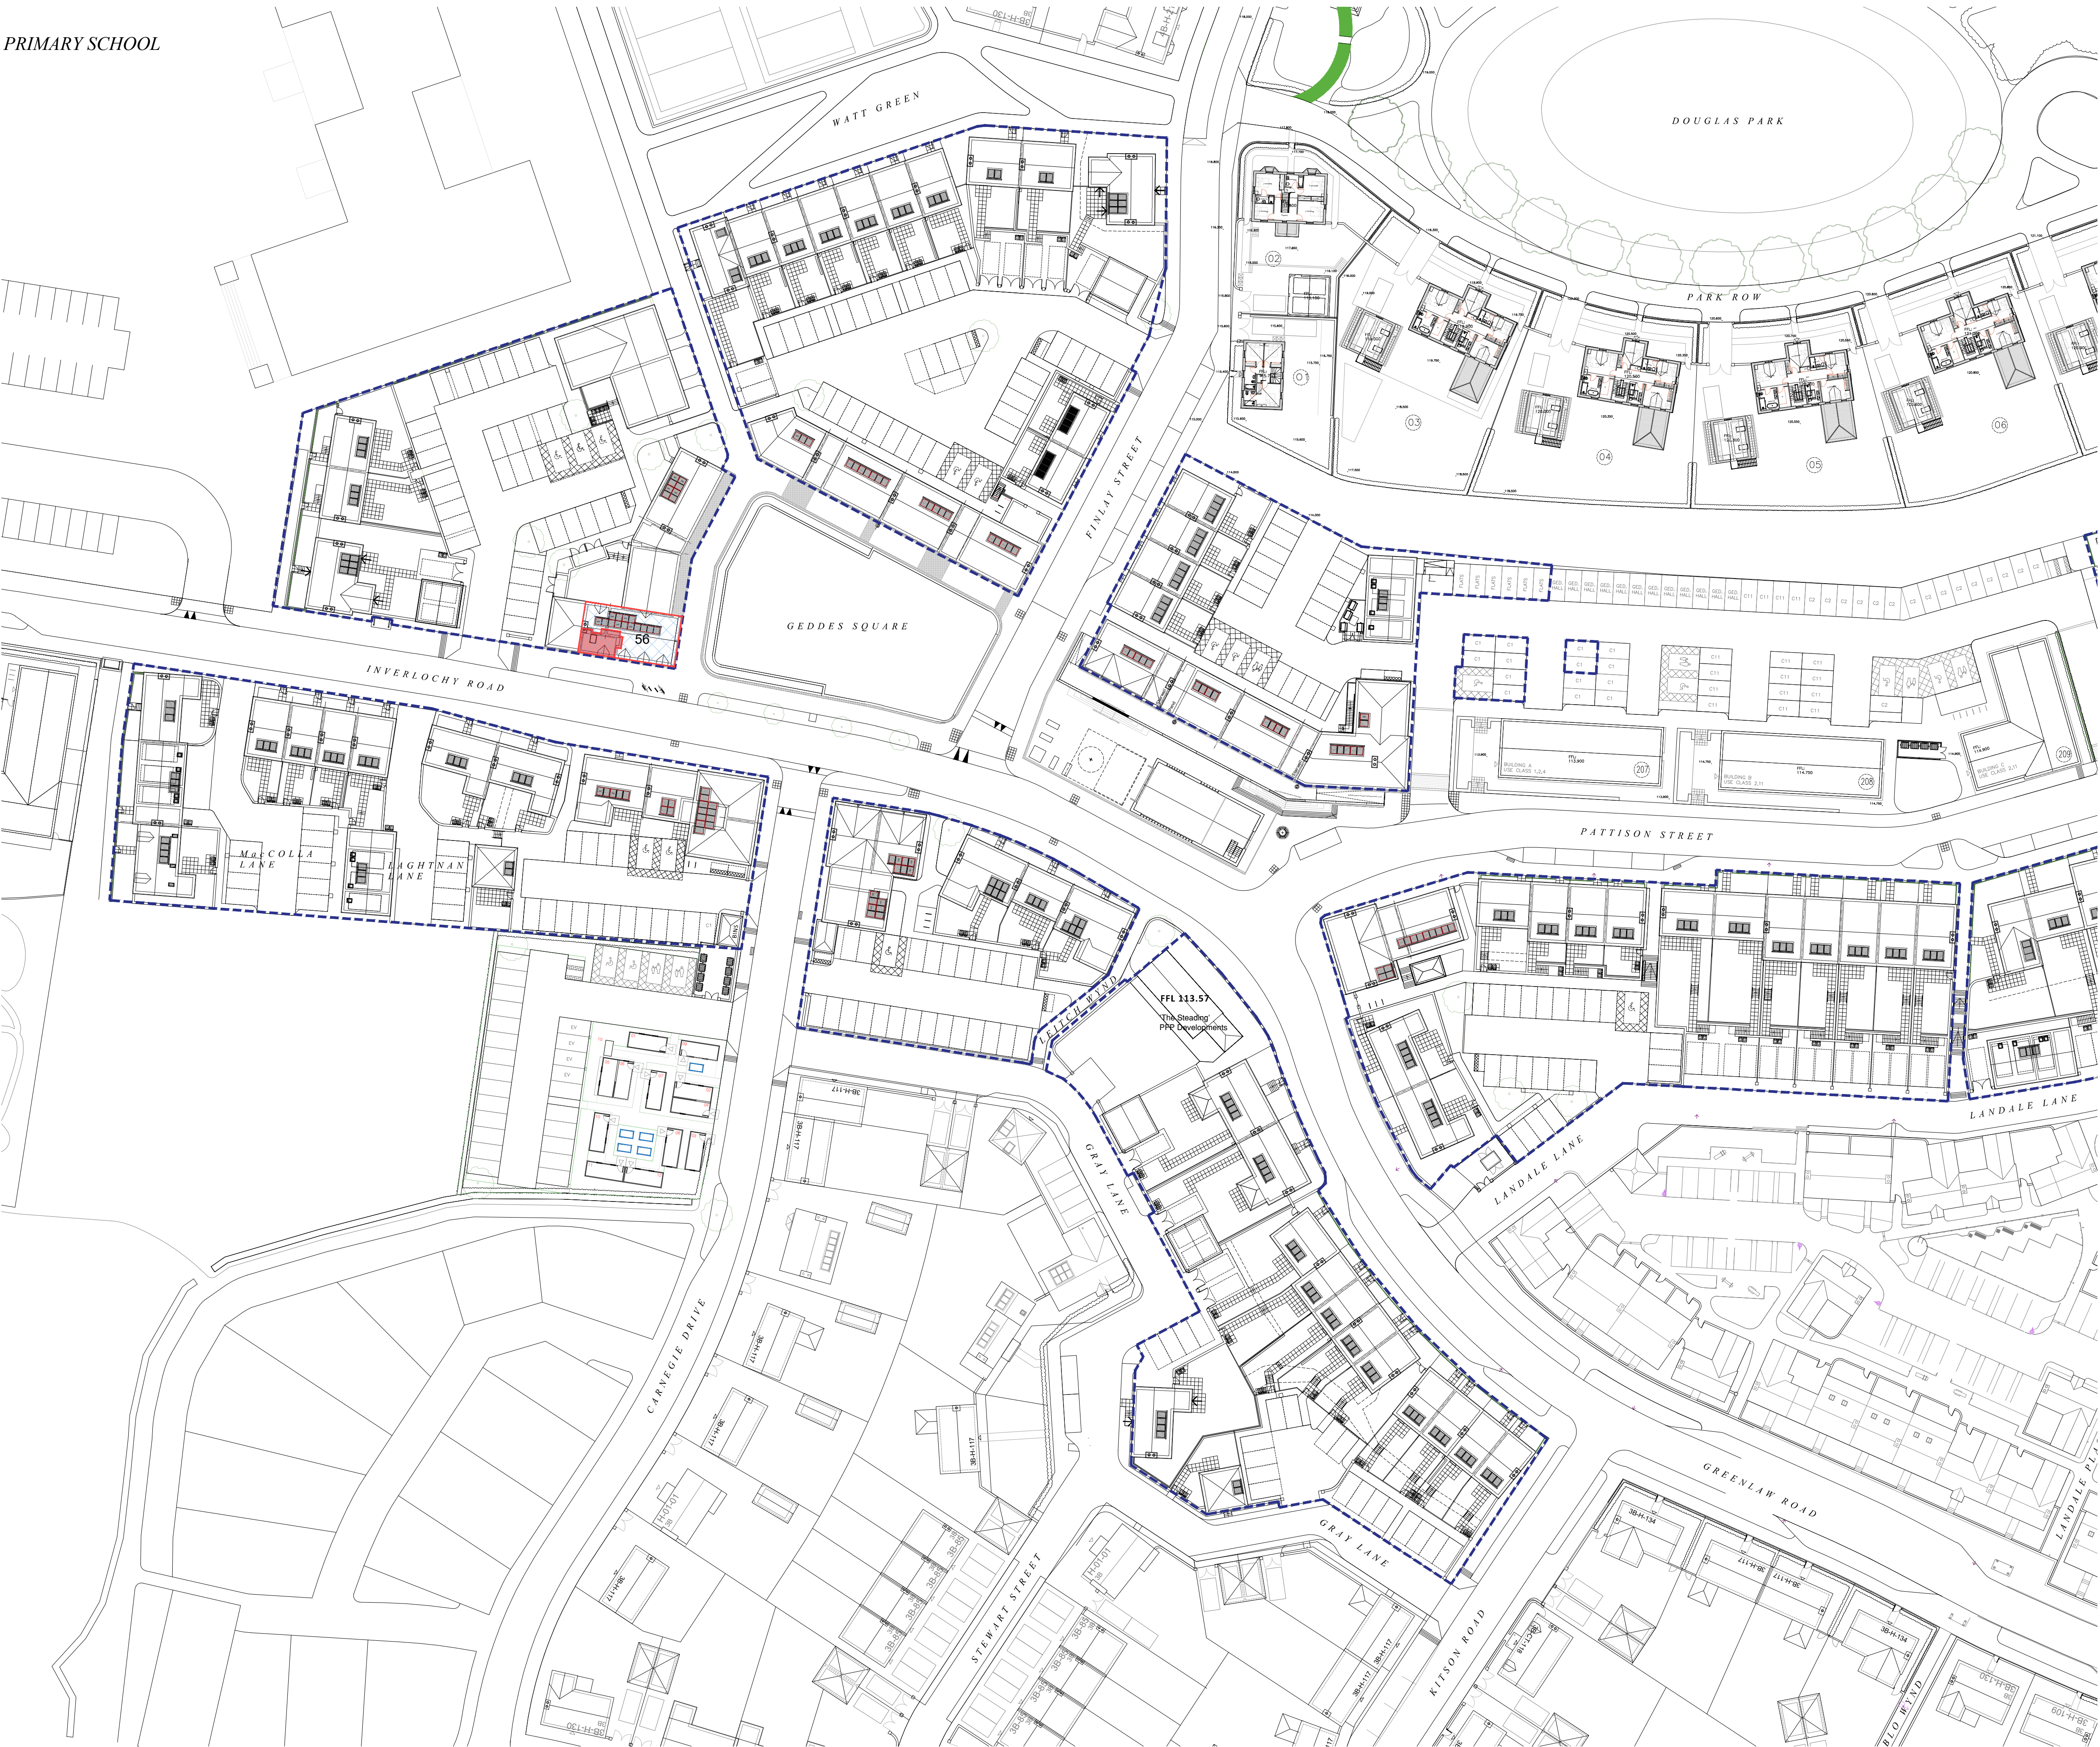

Drawing to be scaled for planning purposes only. Dimensions must not be scaled from this drawing for construction. All dimensions to be checked prior to commencing work or prior to any components being manufactured. Any discrepancy to be reported. All work and material to comply fully with all current & relevant British Standards Codes of Practice, building regulations, IEE regulations and all HSE acts.

Revisions		
Rev	Date	Comment
B	June 25	Updated shared path ownership plots 156/157 and 158/159, plot boundaries updated to plots 85, 162, 163 & 164, general layout updates to construction phase site layout plan
C	Aug 25	Plots 146-151 rear footpath identified as shared
D	Sept 25	Legend updated colours and notes re FCG parking
E	Mar 26	Boundary updates to plots 26, 27, 76 per PIP/Legals comments, common areas sets indicated to layout
F	July 26	Layout amends: Comm 57 parking, Plot 86/87 parking, Plots 177-180 change control HTTs

- Legend**
- Development boundary
 - Individual plot boundary
 - Adopted roads
 - Adopted footpaths
 - Adopted verge
 - Shared external area between plots 41-47 inclusive (*Car parking areas*)
 - Shared external area between plots 48, 49 & 50 (*footpath*)
 - Shared external area between plots 48-63 inclusive (*Car parking areas*)
 - Shared external area between plots 156-159 inclusive (*footpath*)
 - Shared external area between plots 146-151 inclusive (*footpath*)
 - Shared external area between plots 156-157 inclusive (*footpath*)
 - Shared external area between plots 158-159 inclusive (*footpath*)
 - Area Owned by EDC (landowner) with rights of access provided to plots 178 & 179
 - Parking space (1no) for Plot 45
 - Parking space (1no) for Plot 125
 - Parking space (1no) for Plot 132
 - Parking space (1no) for Plot 179
 - Units owned by Castle Rock Edinvar
 - Common stairwell to apartments - owned by Castle Rock Edinvar
 - Car parking area road surface owned by CRE with access rights to adjacent plots for access
 - Car parking spaces owned by CRE
 - External spaces owned by CRE (*Hard and soft landscaping to internal courtyards*)
 - EV charging point
 - Adopted Street Lighting Column (*adopted road areas*)
 - Private Street Lighting Column (*Private Parking courtyards*)

Notes :
Site Grid Reference: NH783506
E: 278389 N: 850607
all dimensions 'or thereby';

MGA ARCHITECTURE
www.mgaarchitecture.co.uk

Project
Residential Development
Geddes Sqaure, Chapelton
Place for People

Drawing
DPA
Third Floor West


Date **Sept 23** Scales **1:500@A1**

Project Nr. **1403** Drawing Nr. **DPA07** Rev. **E**

Revisions	Rev	Date	Comment

- Legend**
- Development boundary
 - Individual plot boundary
 - Adopted roads
 - Adopted footpaths
 - Adopted verge
 - Units owned by Castle Rock Edinvar
 - Common stairwell to apartments - owned by Castle Rock Edinvar
 - Car parking area road surface owned by CRE with access rights to adjacent plots for access
 - Car parking spaces owned by CRE
 - External spaces owned by CRE (Hard and soft landscaping to internal courtyards)
 - EV EV charging point
 - Adopted Street Lighting Column (adopted road areas)
 - Private Street Lighting Column (Private Parking courtyards)

Notes :
Site Grid Reference: NH783506
E: 278389 N: 850607
all dimensions 'or' thereby;

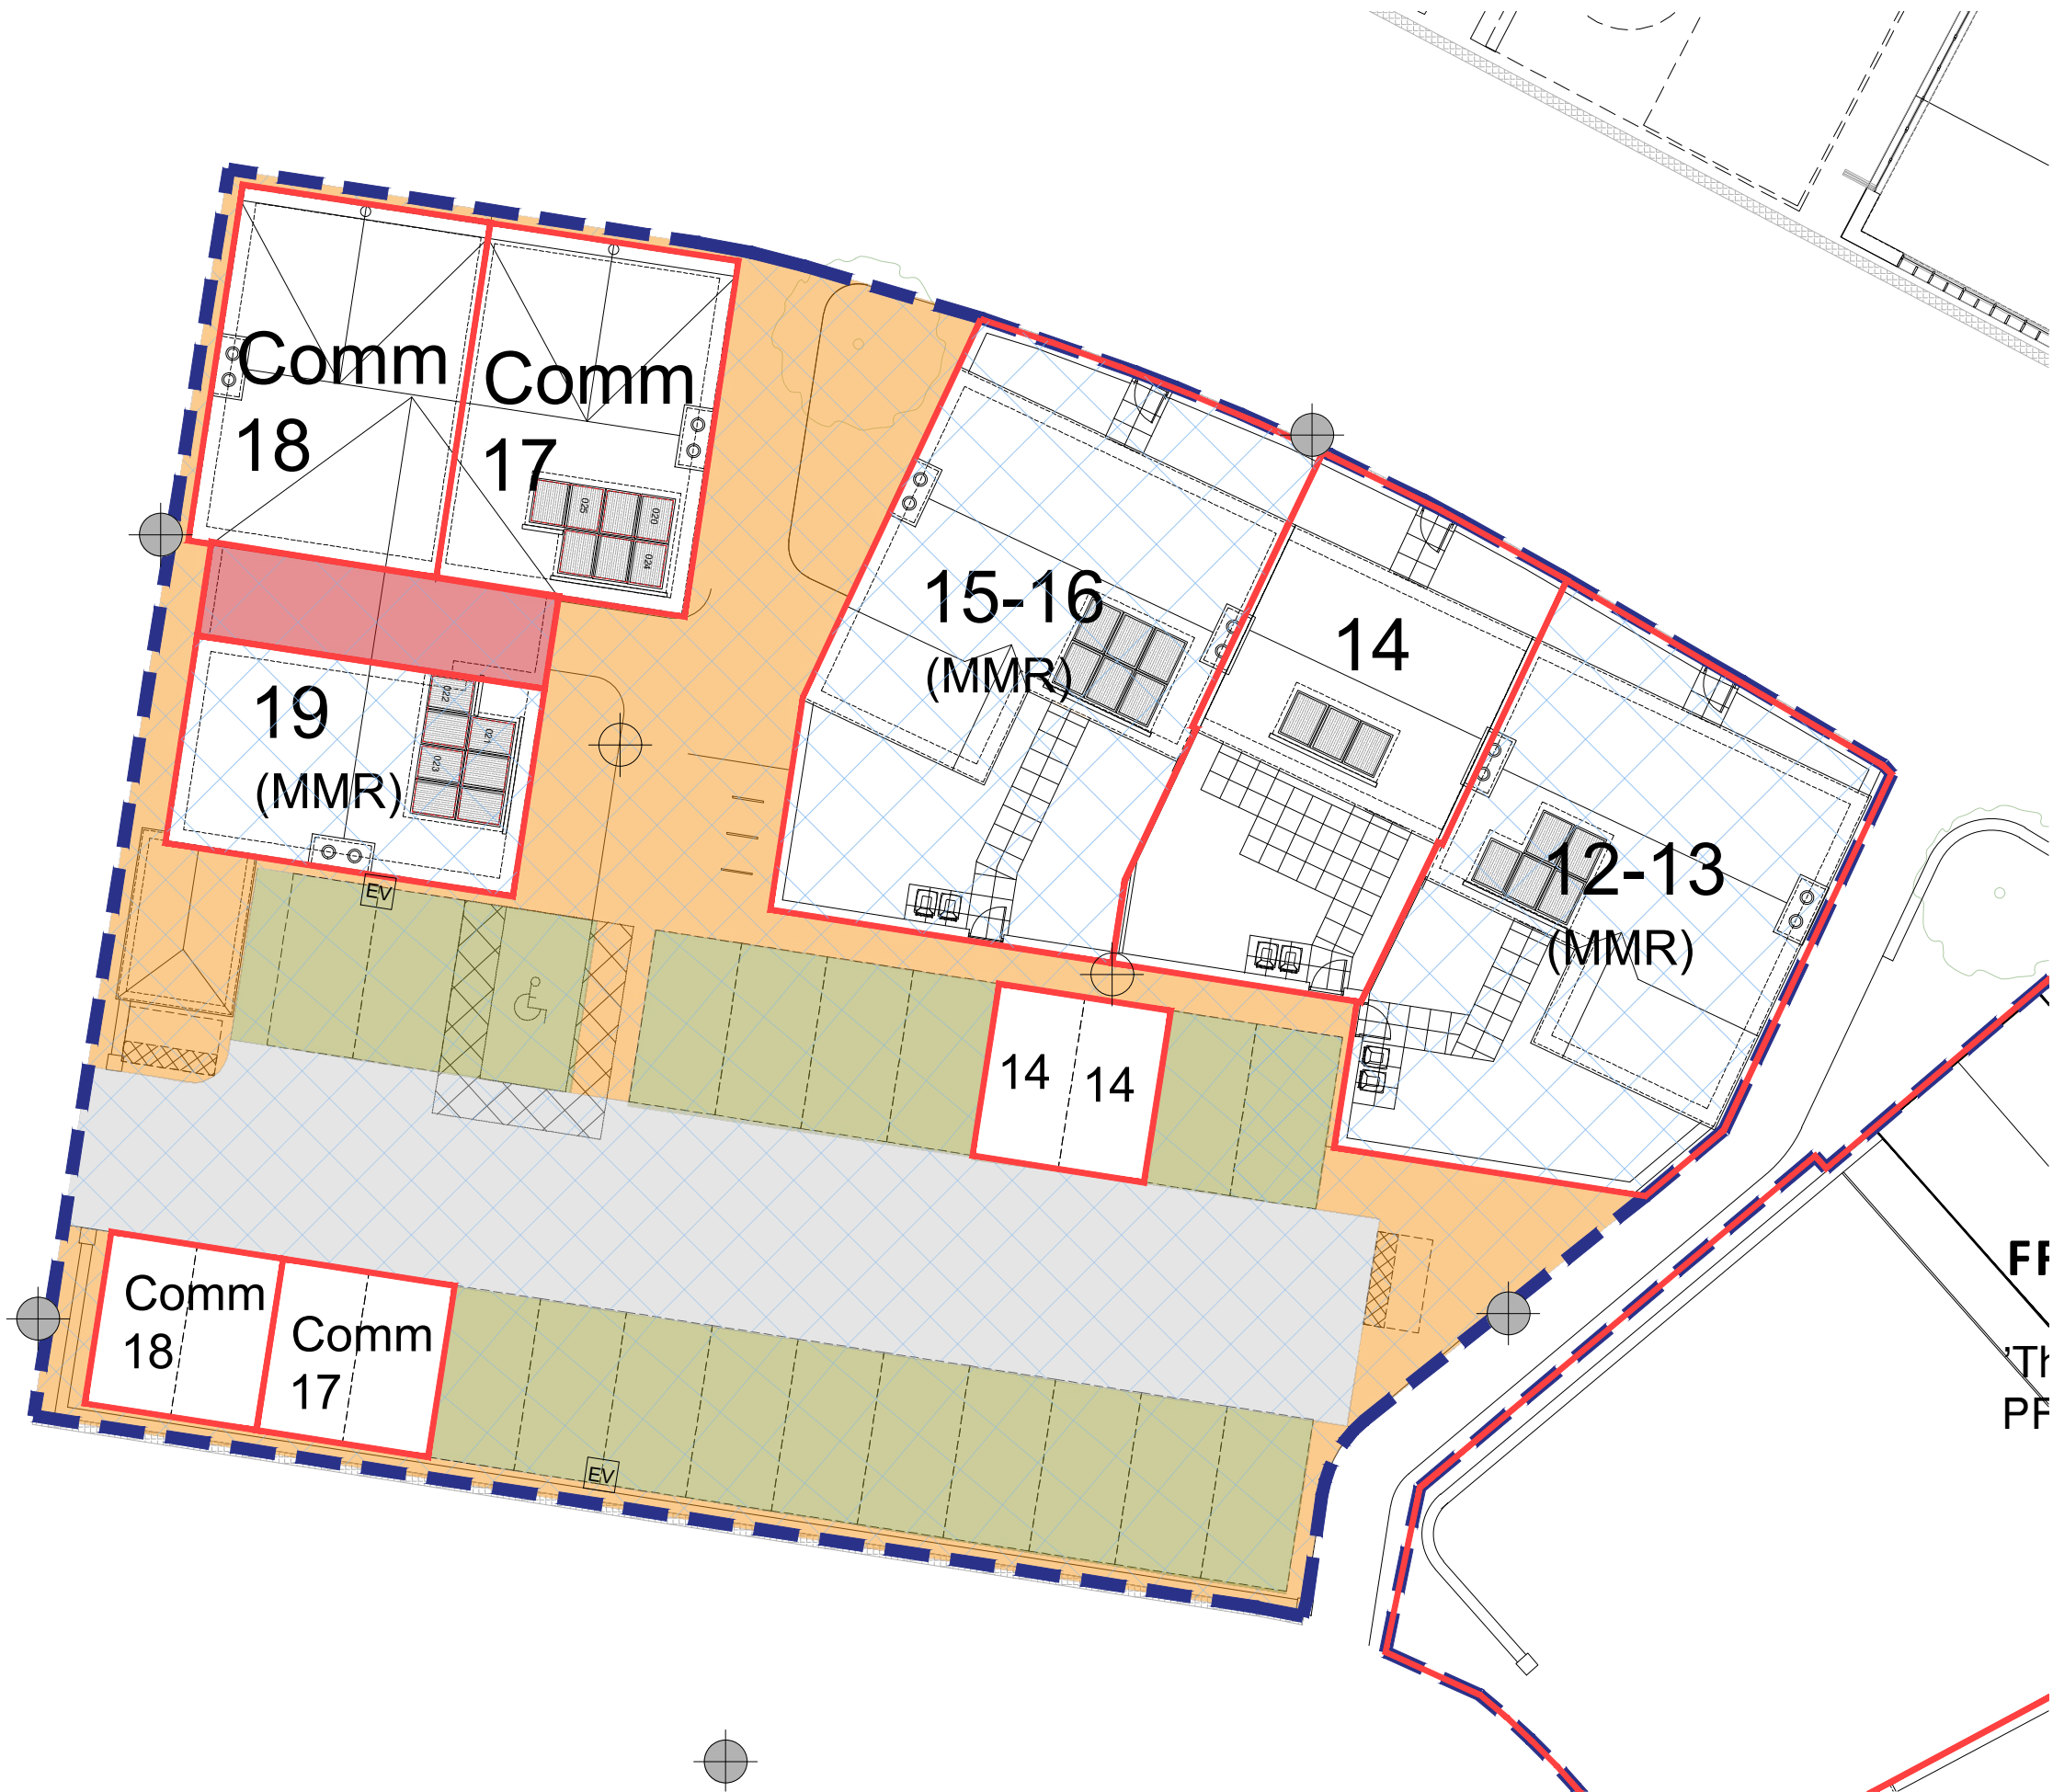

0m 10m 20m
Scale 1:500

MGA ARCHITECTURE
www.mgaarchitecture.co.uk

Project
Residential Development
Geddes Sqaure, Chapelton
Place for People

Drawing
Deed of Conditions
Plots 12-19 Pocket

Date **Feb 25** Scales **1:500@A3**

Project Nr. **1403** Drawing Nr. **DoC-12-19 A**

22 Rubislaw Terrace, Aberdeen, AB10 1XE - 01224 643117 - office@m-g-a.co.uk
This drawing is copyright of Michael Gilmour Associates Ltd. ©

Revisions		
Rev	Date	Comment



Legend

- Development boundary
- Individual plot boundary
- Adopted roads
- Adopted footpaths
- Adopted verge
- Shared external area between plots 41-47 inclusive (Car parking areas)
- Units owned by Castle Rock Edinvar
- Common stairwell to apartments - owned by Castle Rock Edinvar
- Car parking area road surface owned by CRE with access rights to adjacent plots for access
- Car parking spaces owned by CRE
- External spaces owned by CRE (Hard and soft landscaping to internal courtyards)
- EV
- EV charging point
- Adopted Street Lighting Column (adopted road areas)
- Private Street Lighting Column (Private Parking courtyards)

Notes :
Site Grid Reference: NH783506
E: 278389 N: 850607
all dimensions 'or thereby';

MGA ARCHITECTURE
www.mgaarchitecture.co.uk

Project
Residential Development
Geddes Sqaure, Chapelton
Place for People

Drawing
Deed of Conditions
Plots 28-47 Pocket

Date **Feb 25** Scales **1:500@A1**
Project Nr. **1403** Drawing Nr. **DoC-28-47 A**