


LEGEND

- Site Boundary
- Housing Association
- Landscaping and PDS including fences, gates & remote walls to be maintained by owner or tenant of clients
- Adopted verges to be maintained by N.C.
- Shared Access Path to be maintained by Plots 81 - 82
- Shared Access Road to be maintained by Plots 92 - 93
- Shared Access Path/parking space to be maintained by Plots 94 - 97
- Shared Access Path to be maintained by Plots 94 - 96
- Shared Access Road to be maintained by Plots 99 - 100
- Shared Access to be maintained by Plots 101 - 103
- Shared Access Path to be maintained by Plots 101 - 105
- Shared Access Path to be maintained by Plots 94-105
- Shared Access to be maintained by Plots 112 - 113
- Shared Access Road to be maintained by Plots 121 - 122
- Shared Access Road to be maintained by Plots 121 - 123
- Shared Access Road to be maintained by Plots 126 - 128
- Shared Access Road to be maintained by Plots 127 - 128
- Shared Access Road to be maintained by Plots 132 - 135
- Shared Access Road to be maintained by Plots 134 - 135
- Shared Access Path to be maintained by Plots 158 - 160
- Shared Access Road to be maintained by Plots 98 & 101 - 104
- Shared Access Road and footpath to be maintained by Plots 173 - 176
- Shared Access Path to be maintained by Plots 174 - 176
- Shared Access Path to be maintained by Plots 181 - 184
- Shared Access Path and parking access to be maintained by Plots 187 - 190
- Shared Access Path to be maintained by Plots 188 & 189


The Development registered under Title GLA226378 and plots 79 to 200 and 241 to 247 within have been DPA approved by:

*D. McIntyre - 23rd September 2020*

Danielle McIntyre (DPA Officer)

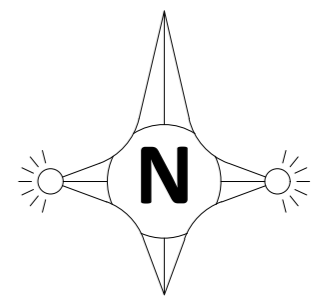

0 10 20 30 40 50m

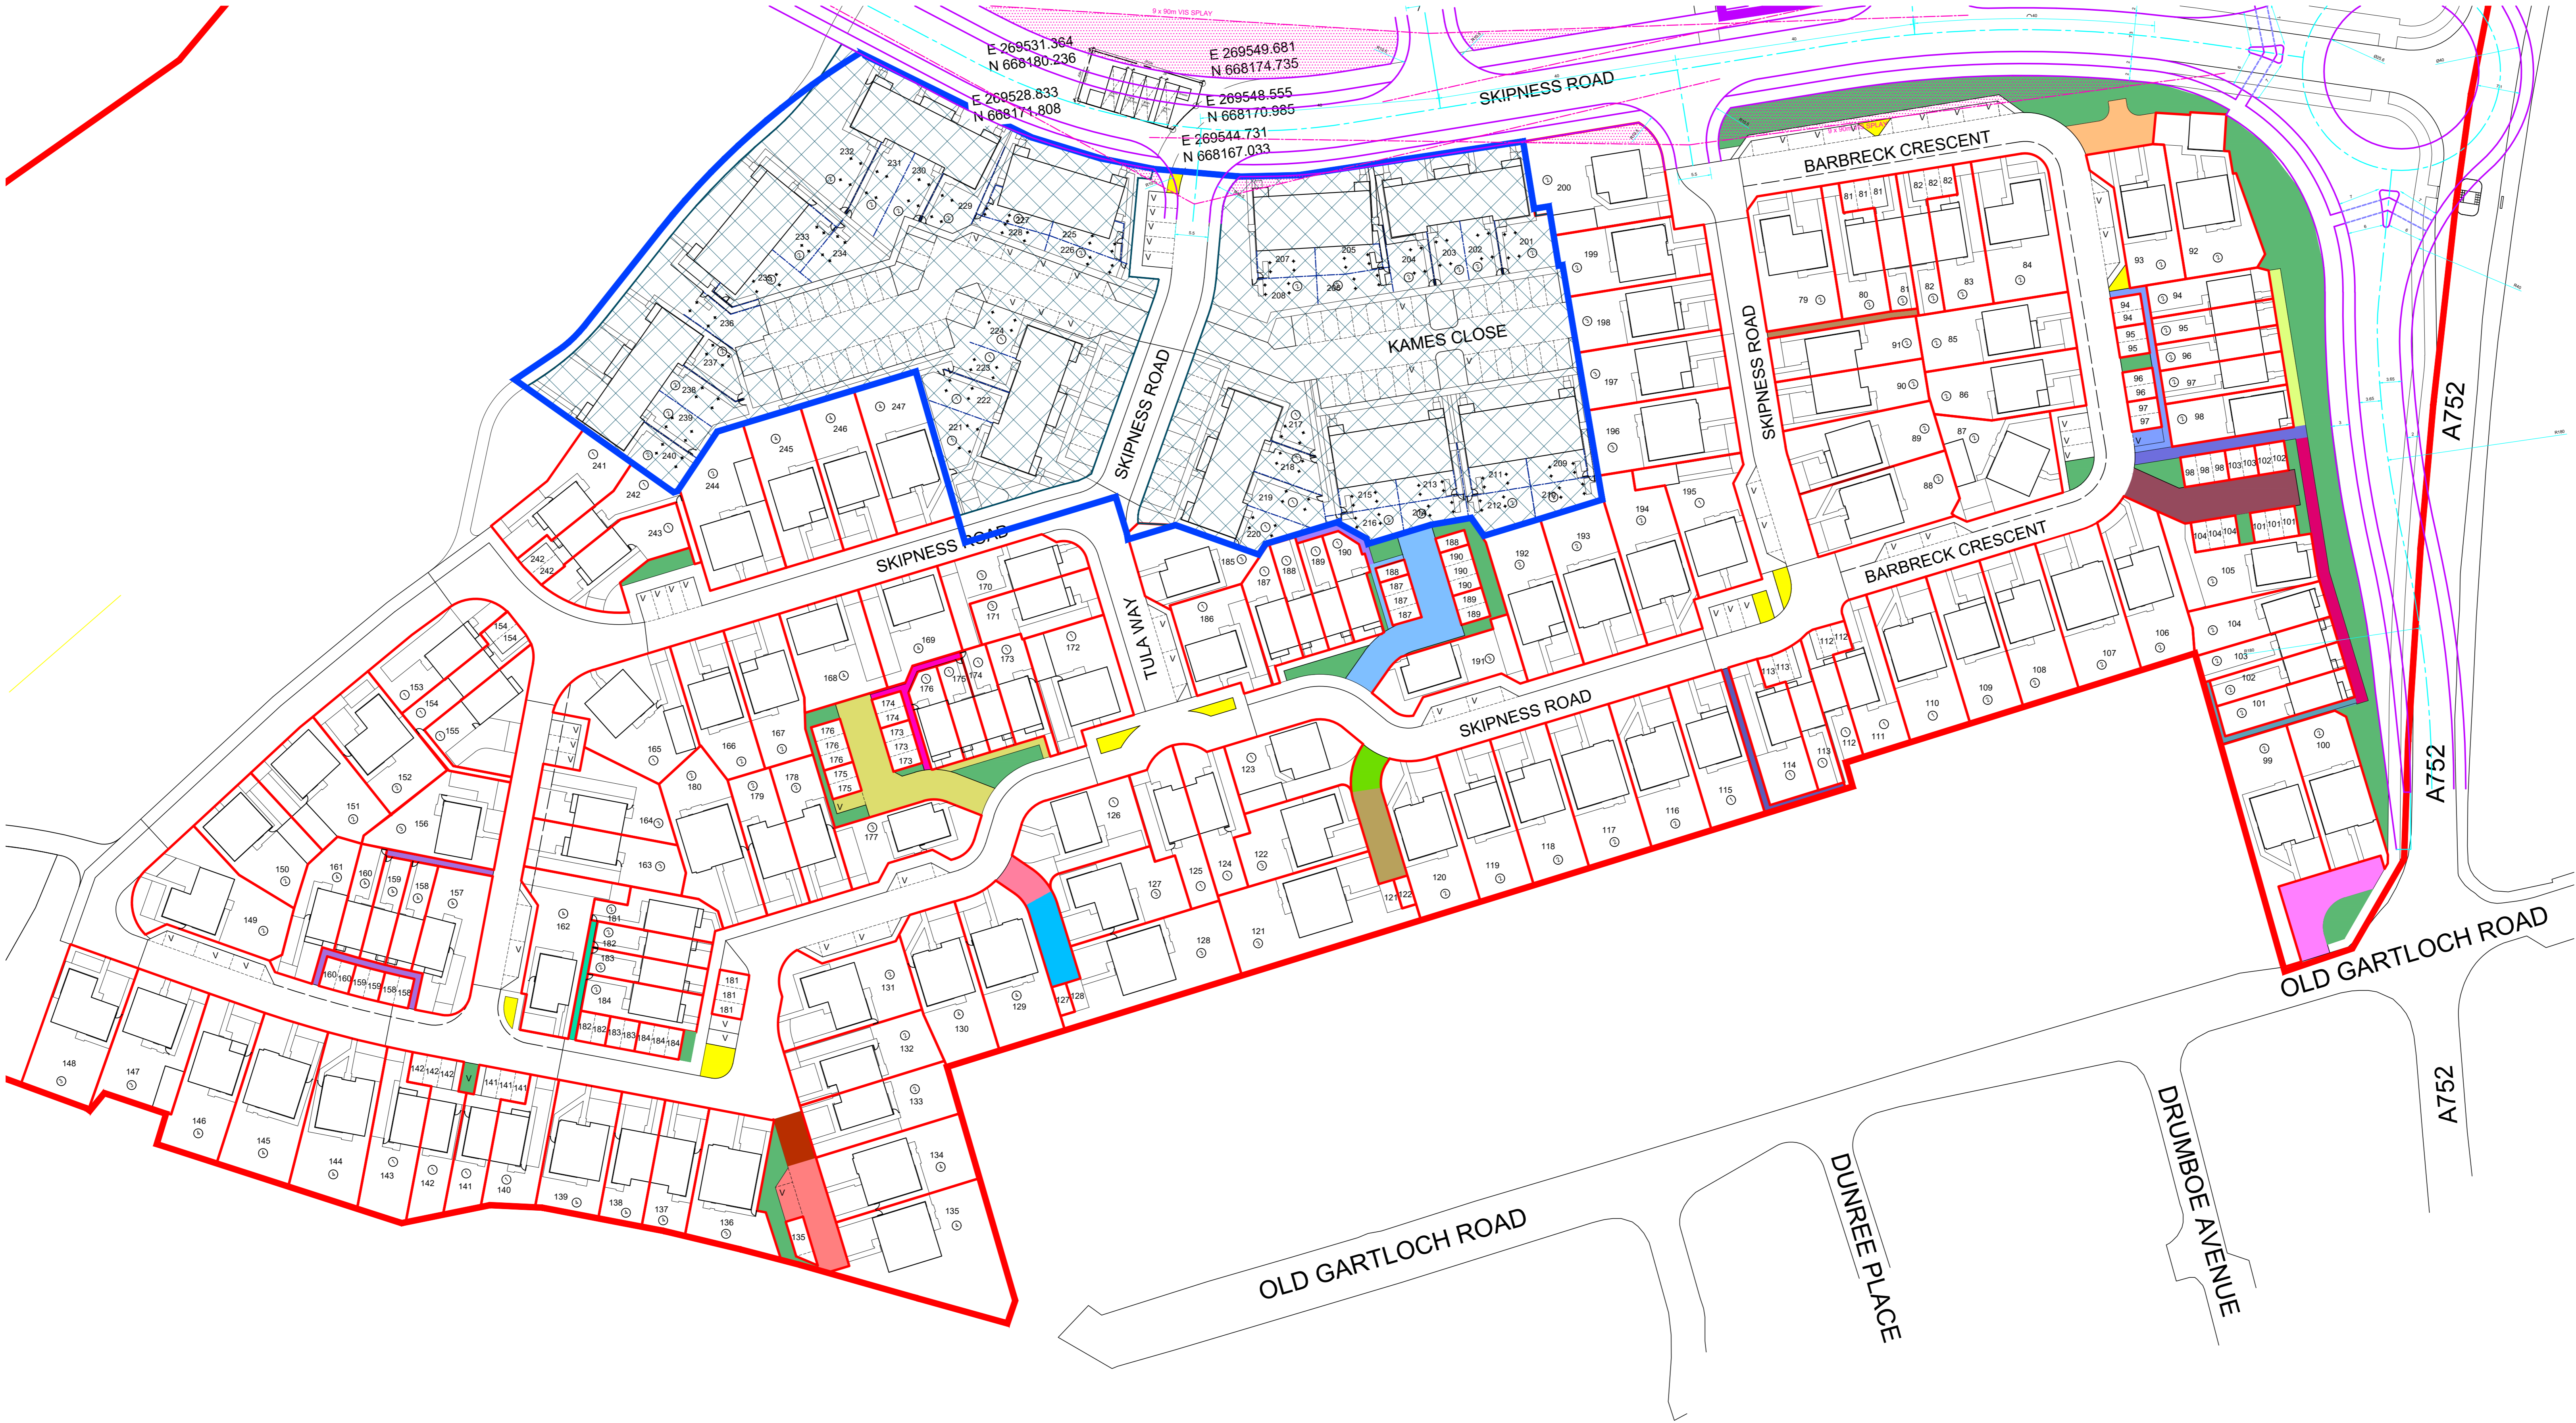

- REVISIONS
- A. Minor boundary amendments, North Point and Scale Bar added.  
BHW 07.07.2017
- B. General update to include shared driveways, footpaths etc.  
BHW 10.11.2017
- C. Update to include observations from RoS  
BHW 18.12.2017
- D. Update to include observations from RoS  
BHW 18.12.2017
- E. Legend amended regarding access to Plots 80-82, 94-98, 101-105 & 127-128. Shared access to Plots 94-98 & 101-105 indicated.  
ND 14.08.2018
- F. Boundaries to Plots 148, 244-247 amended.  
ND 19.11.2018
- G. Parking arrangement for plot 181-184 inc. amended to reflect as-built.  
gjh 25/09/2020

PROJECT TITLE

Development at GARTCOSH

DRAWING TITLE

Development Plan Approval Drawing

SCALE	DATE	DRAWN
1:500@A0	June 2017	BHW
JOB NUMBER	DWG REFERENCE	REVISION
126	DPA/01	G

**PERSIMMON HOMES** NORTH SCOTLAND

Broden House  
Broden Business Park  
Lambertine Drive  
PERTH, PH1 1RA  
Telephone: 01738 500820