
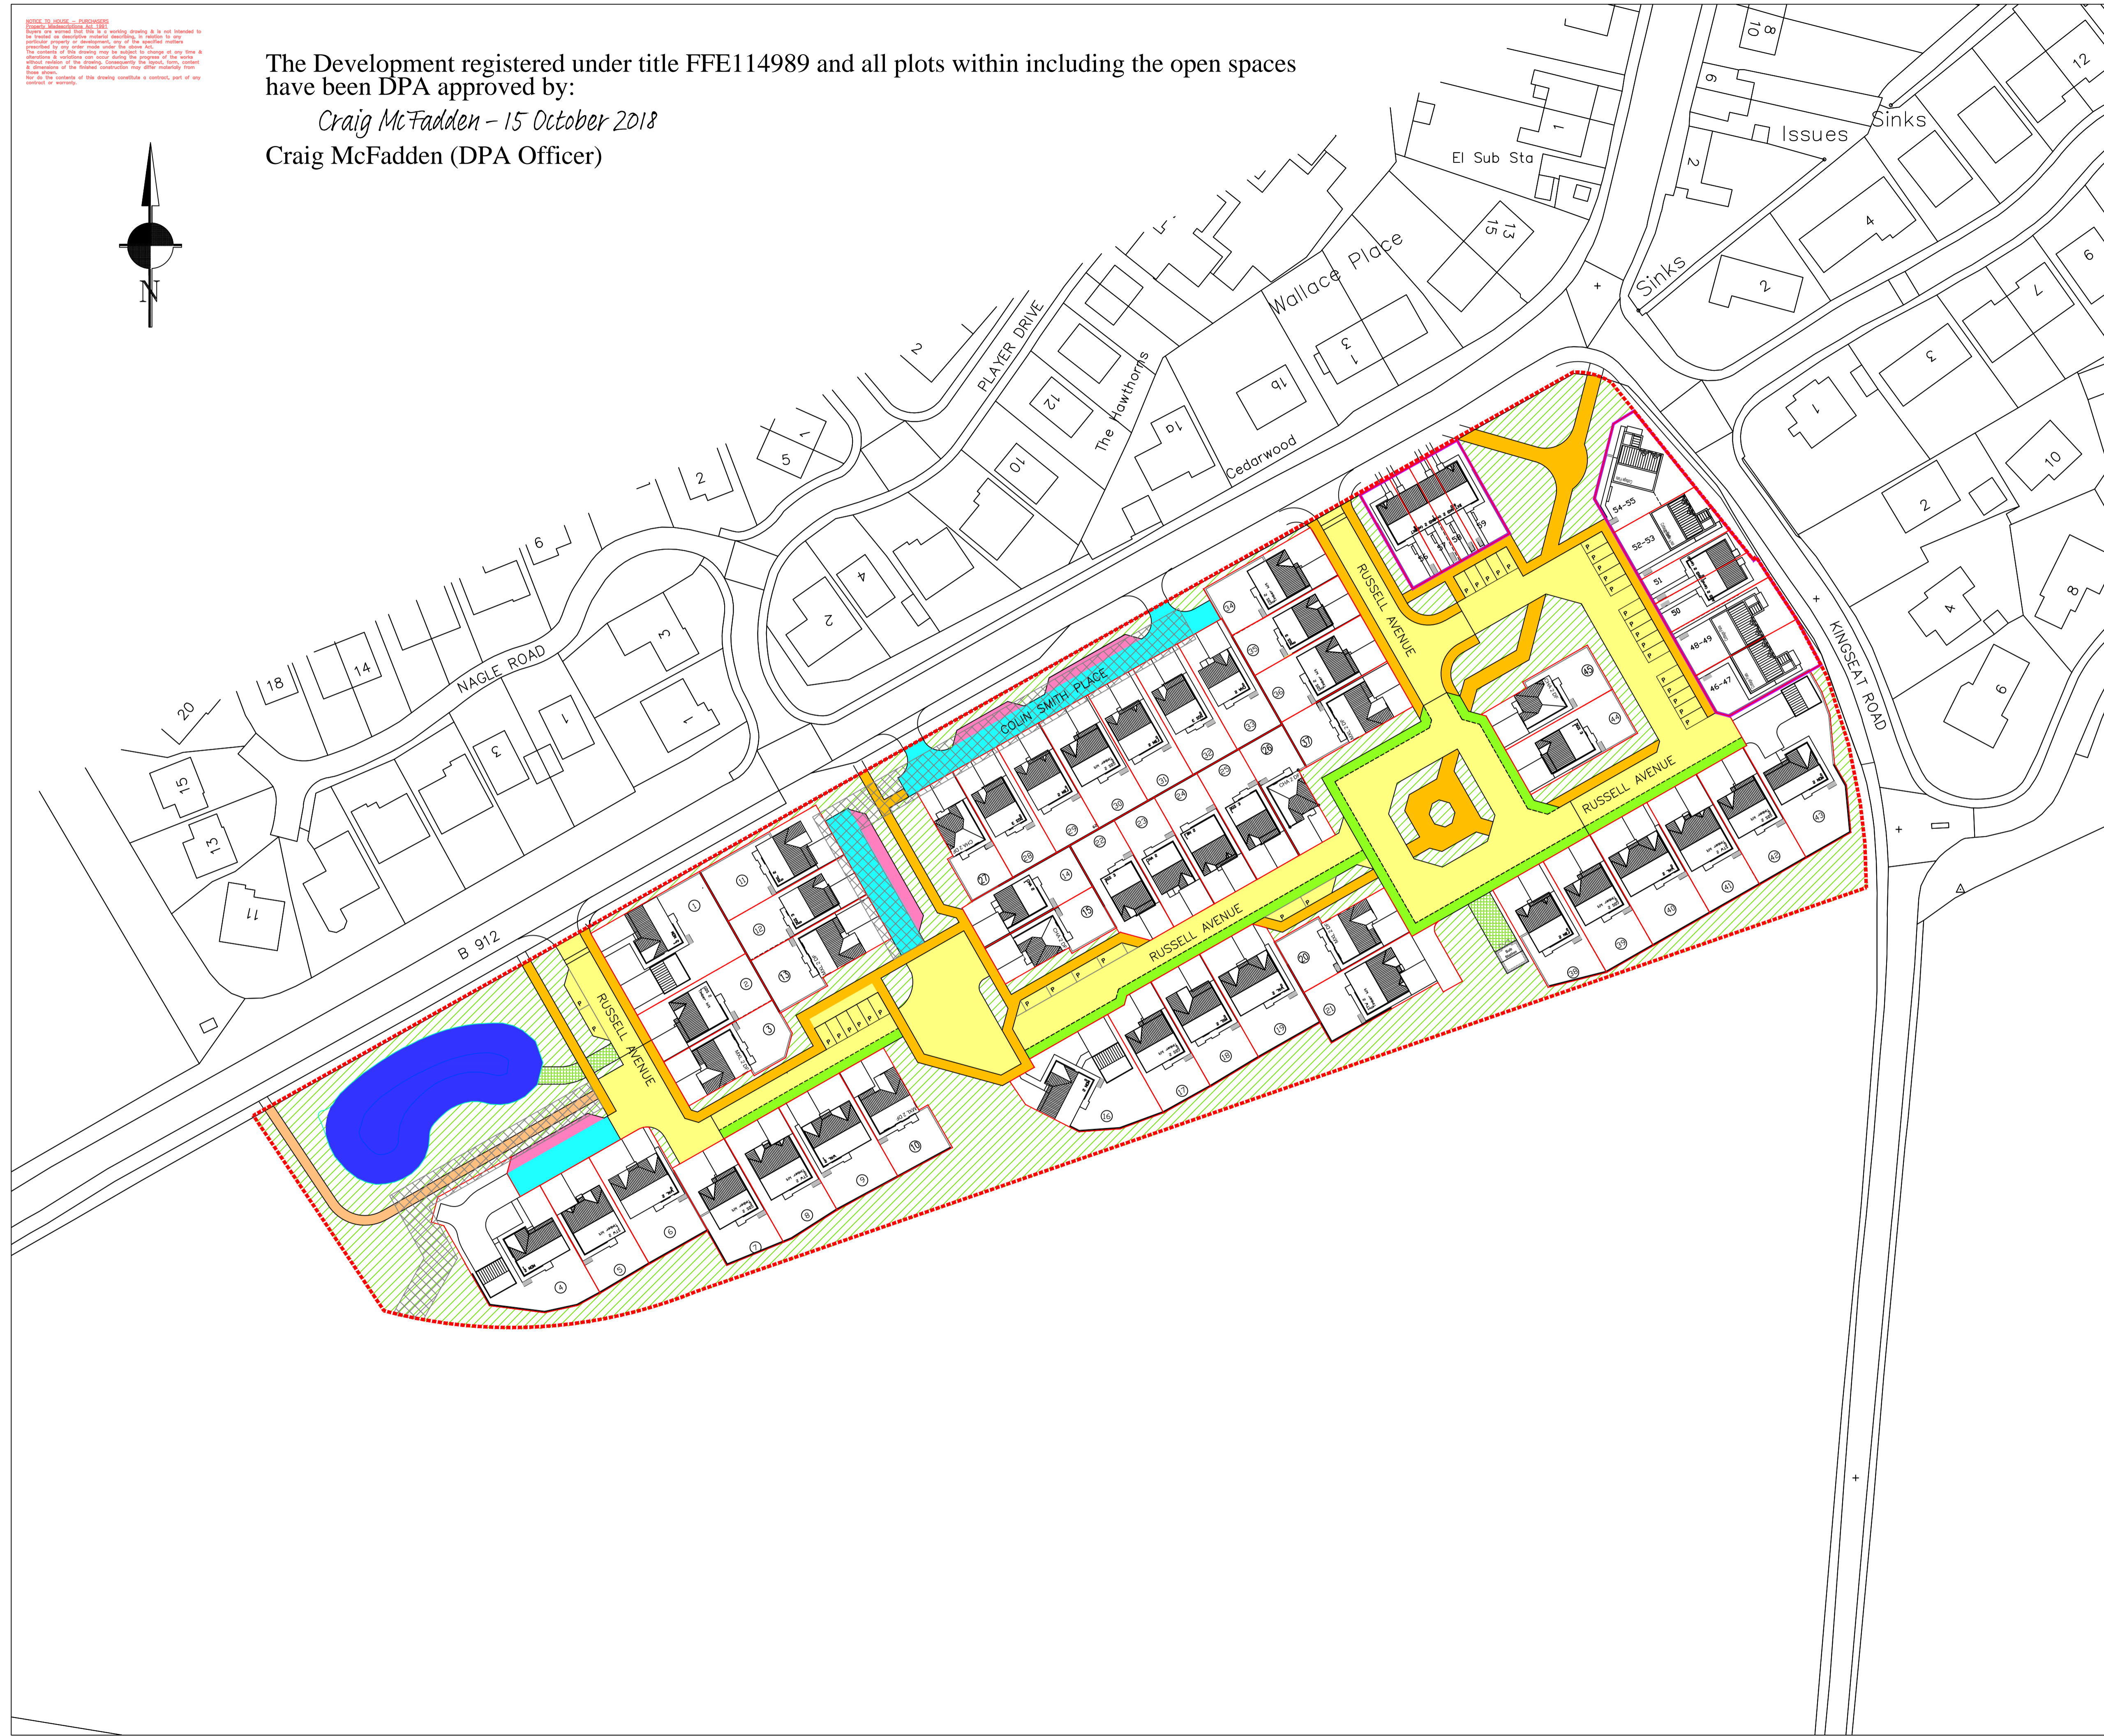


NOT TO SCALE - APPROXIMATE
 Planning permission for this development is not intended to be granted until the 2018 planning process has been completed. The information contained in this drawing is for information only and should not be used for any other purpose without the consent of the planning authority. The information contained in this drawing is for information only and should not be used for any other purpose without the consent of the planning authority. The information contained in this drawing is for information only and should not be used for any other purpose without the consent of the planning authority.

The Development registered under title FFE114989 and all plots within including the open spaces have been DPA approved by:
 Craig McFadden - 15 October 2018
 Craig McFadden (DPA Officer)

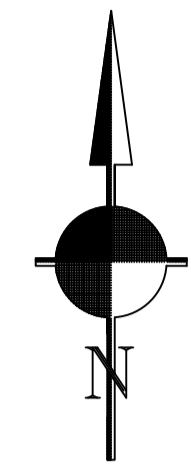

NOTES

- LEGEND:**
- Adoptable Footpaths
 - Adoptable Roads
 - Adoptable Parking Bays P
 - Adoptable Service Strip
 - Factored Footpath
 - Private Shared Access Road
 - Private Parking Bays
 - Adoptable SUDS Basin
 - Factored Public Open Space
 - Factored Service Access Surface
 - Sewer Wayleaves
 - Feu Boundary
 - Affordable Boundary
 - Title Boundary

B	APR'17	PLM	SEWER WAYLEAVES ADDED. DUAL FRONTAGE PLOT LANDSCAPE BUFFER REMOVED.
G	08B'17	PLM	ROBTHAWESB REDRAISED DRIVEWAY/PLANT REVISIONS LANDSCAPING BOUNDARY. SERVICE STRIPS INCREASED FROM 1M TO 2M AT REQUEST OF R&T
D	JUN'17	PLM	AFFORDABLE BOUNDARY ADDED
E	JUL'17	PLM	PRIVATE SHARED DRIVEWAY OMITTED IN LEGEND & REPLACED BY FACTORED ACCESS ROADWAY. FACTORED DEVELOPMENT PARKING INCLUDED ON LAYOUT TO REFLECT PLANNING CONDITION 25. VISITOR PARKING IDENTIFIED ON LAYOUT WITH 'V' AS PER RDS KEEPER REQUEST. SUDS BASIN REVISED IN LEGEND.
F	AUG'17	PLM	VISITOR PARKING REVISED ON LEGEND & ON PLAN
REV	DATE	DRAWN	DESCRIPTION
			PRIVATE SHARED ACCESS ROAD & SHARED COMMUNAL VISITOR PARKING REVISED IN LEGEND AS A RESULT OF RECENT COMMUNICATION FROM ROADS & TRANSPORT RELATIVE TO RCG.
G	OCT'17	PLM	REVISIONS TO PLOT 6, 7, 9, 10, 13, 26 & 37 DUE TO CHANGES ON SITE. PLEASE REFER TO DEVELOPMENT LAYOUT REVISION 1 FOR FULL DESCRIPTION OF CHANGES.
H	NOV'17	PLM	ADAPTABLE PARKING BAY LEGEND REVISED FROM 'V' TO 'P' AS PER ROADS & TRANSPORT REQUEST
I	NOV'17	PLM	PRIVATE SHARED COMMUNAL VISITOR PARKING REVISED AT LEGAL'S REQUEST TO PRIVATE PARKING BAYS
J	AUG'18	PLM	PLOT 16 FULLY REVISED TO REFLECT LANDSCAPE PLANS SHOWN TO CLIENT AT RESERVATION & THE LANDSCAPING INSTALLED ON SITE. AUTHORIZED P2-081 PARKING BAYS IDENTIFIED ON PLOT 10 REVISED TO REFLECT AS-BUILT IN SITE. PLOT 26 BOUNDARY BOUNDARY REVISED TO REFLECT DUAL FRONTAGE BOUNDARY

Taylor Wimpey East Scotland
 1 Madras Park
 Carnegie Campus
 Dunfermline KY11 8PL
 Tel 01383 845 700 Fax 01383 845 725
 www.taylorwimpey.com

Taylor Wimpey

Project:
Land West of Kingseat Road, Fife Kingseat

Title:
Master Feu Layout

Dwg No: **11411 / - / FEU-01 I**

Scale: 1:500 @ A1 Date: FEB'17

Drawn By: RC Checked By: PLM