
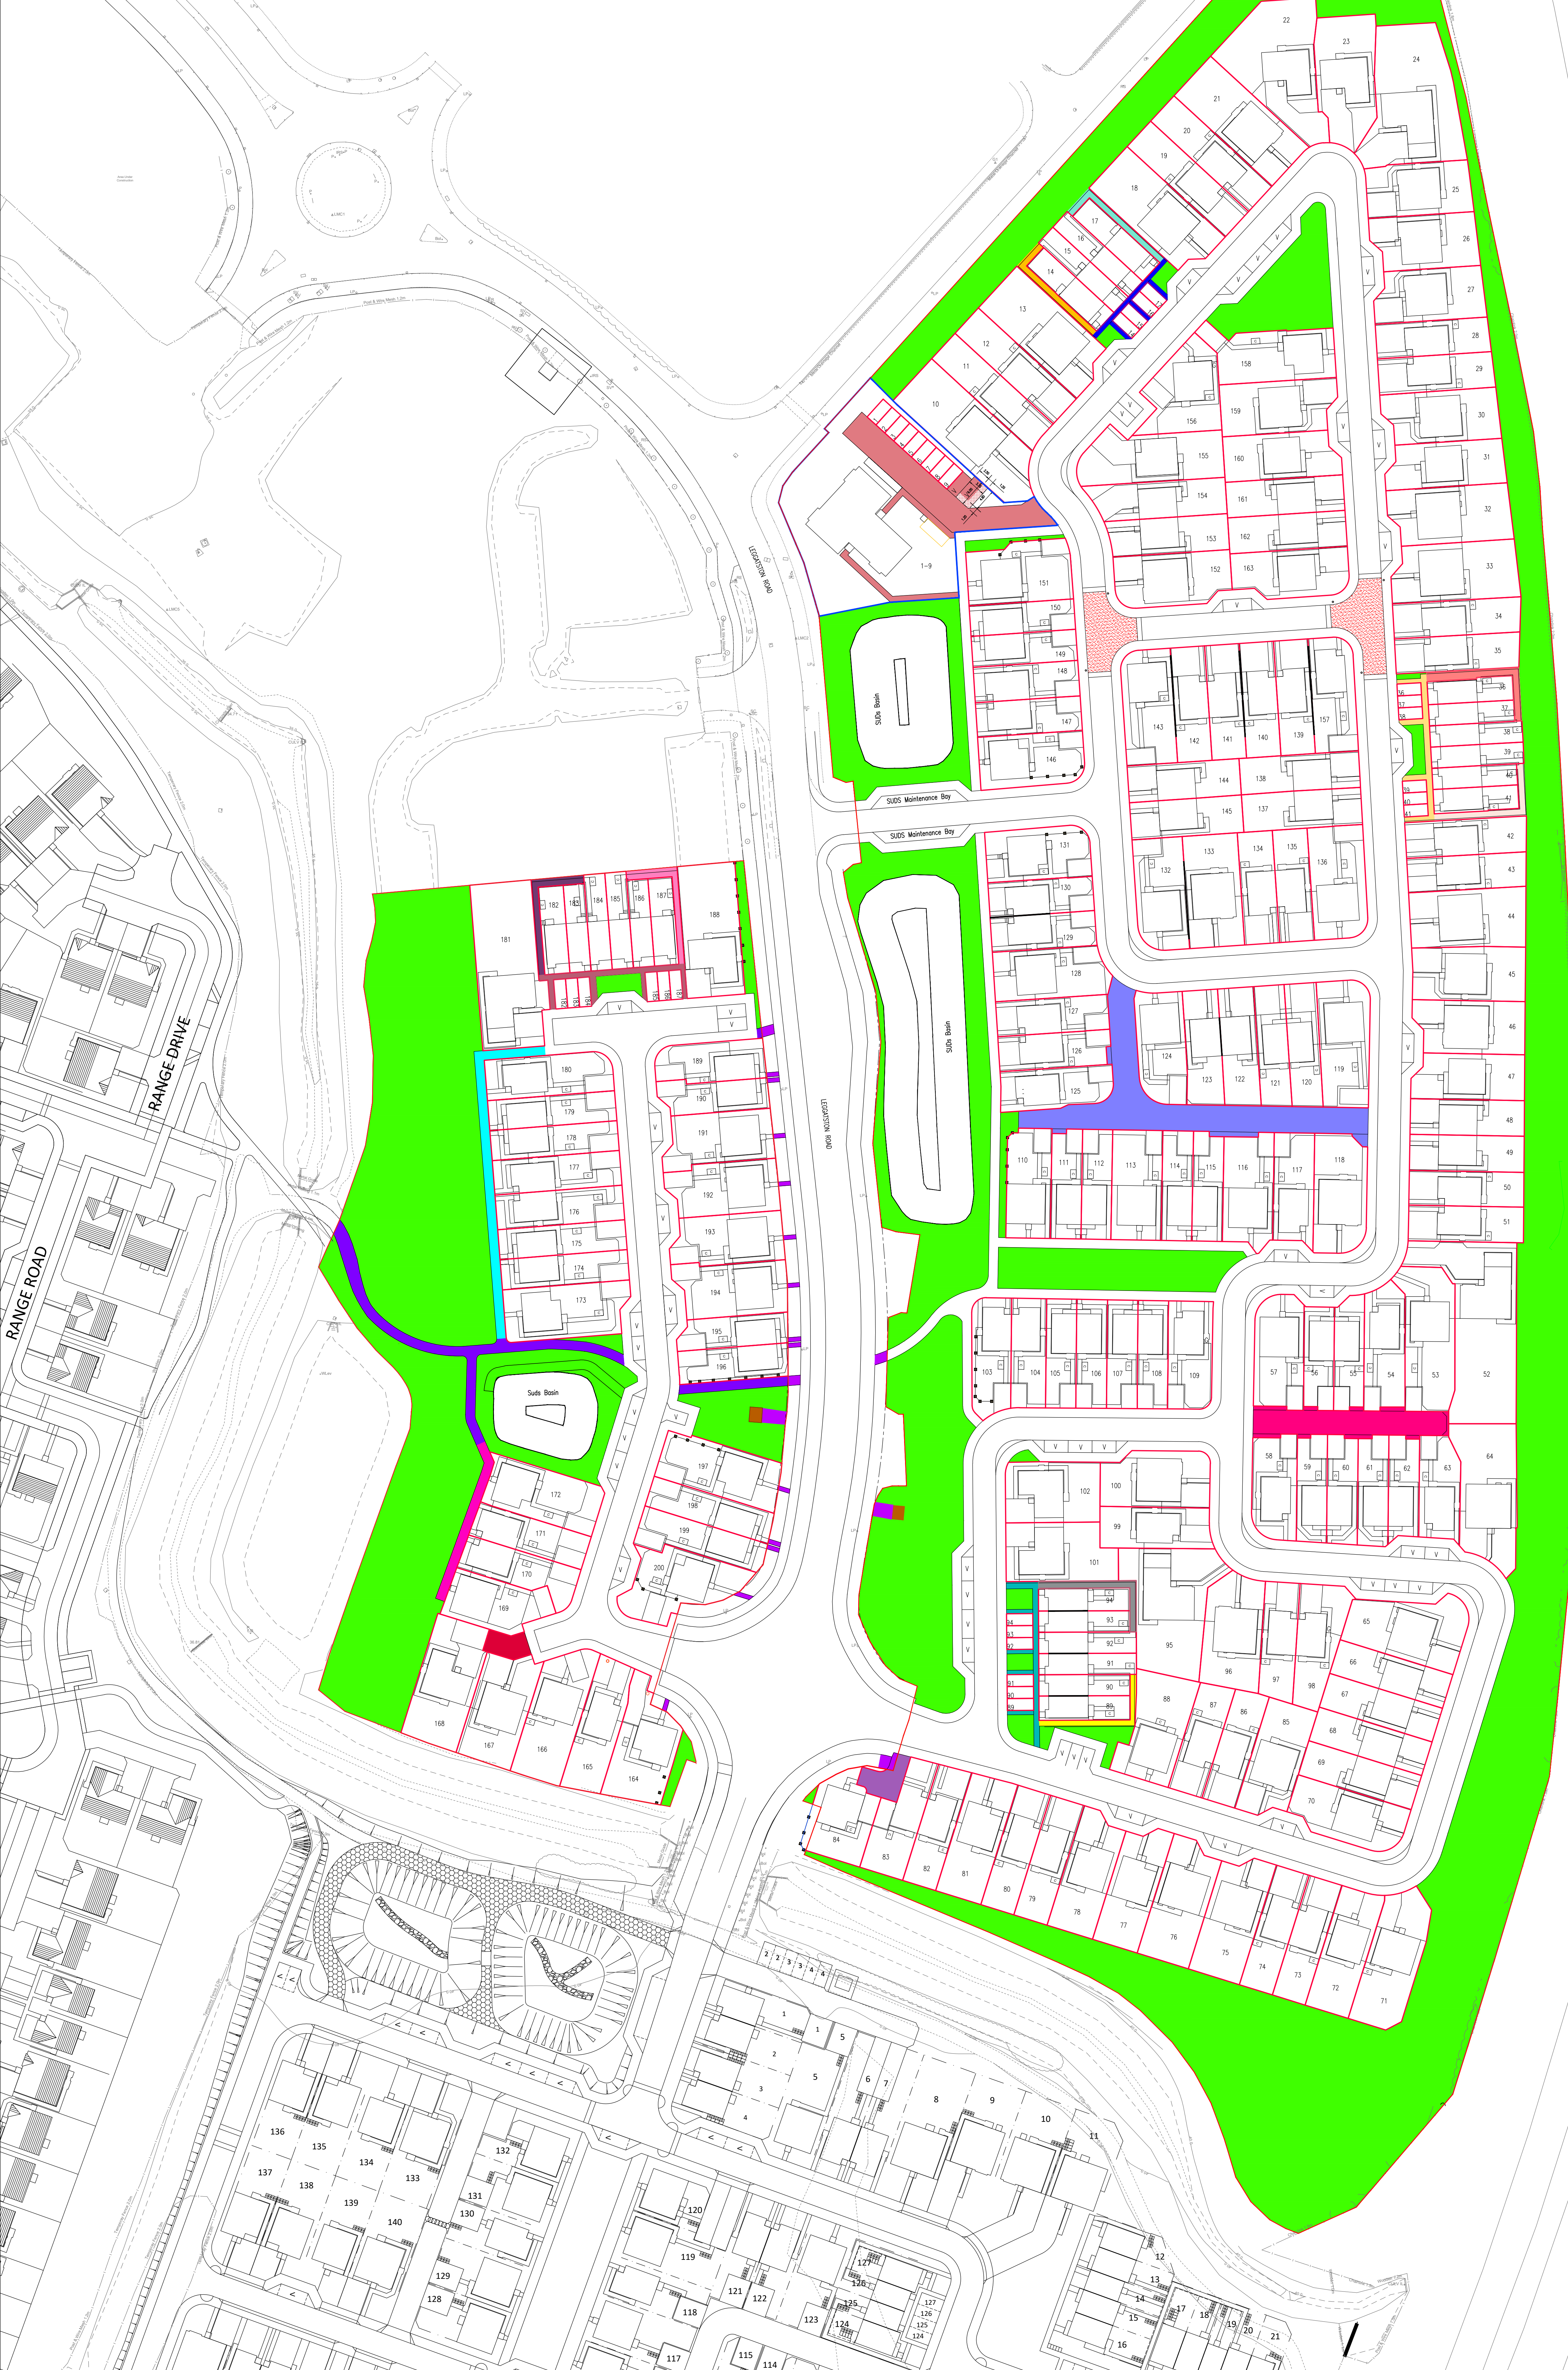


Ross Cairns (DPA Officer)

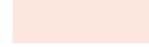

	LEGEND
	COMPOSITE OPEN SPACE
	LEGEND
	COMPOSITE OPEN SPACE FOOTPATH
	RIGHT OF ACCESS
	DENOTES PLOTS 1-9 COMMON ACCESS (1/9 SHARE)
	DENOTES PLOTS 1-9 COMMON AREA (1/9 SHARE)
	DENOTES PLOTS 14-15 SHARED FOOTPATH (1/2 SHARE)
	DENOTES PLOTS 14-17 SHARED FOOTPATH (1/4 SHARE)
	DENOTES PLOTS 16-17 SHARED FOOTPATH (1/2 SHARE)
	DENOTES PLOTS 36-38 SHARED FOOTPATH (1/3 SHARE)
	DENOTES PLOTS 36-41 SHARED FOOTPATH (1/6 SHARE)
	DENOTES PLOTS 39-41 SHARED FOOTPATH (1/3 SHARE)
	DENOTES PLOTS 53-63 COMMON ACCESS (1/11 SHARE)
	DENOTES PLOTS 63-84 COMMON ACCESS (1/2 SHARE)
	DENOTES PLOTS 68-91 SHARED FOOTPATH (1/3 SHARE)
	DENOTES PLOTS 89-94 SHARED FOOTPATH (1/6 SHARE)
	DENOTES PLOTS 92-94 COMMON ACCESS (1/3 SHARE)
	DENOTES PLOTS 110-117 & 124-127 COMMON ACCESS (1/12 SHARE)
	DENOTES PLOTS 167-168 COMMON ACCESS (1/2 SHARE)
	DENOTES PLOTS 169-172 SHARED FOOTPATH (1/4 SHARE)
	DENOTES PLOTS 173-180 SHARED FOOTPATH (1/8 SHARE)
	DENOTES PLOTS 182-184 SHARED FOOTPATH (1/3 SHARE)
	DENOTES PLOTS 182-187 SHARED FOOTPATH (1/6 SHARE)
	DENOTES PLOTS 185-187 SHARED FOOTPATH (1/3 SHARE)

		F	16.06.21	PLOT 32-50 FEU LINES AMENDED	AM	-	C	09.05.2021	RED LINE BOUNDARY UPDATED - PLOT 52-63 & 63-64 FEU LINES AMENDED TO FIT COMMON ACCESS	NF	-	REFERENCE TO HOUSES PREVIOUSLY Proposed Memorandum Act 1981	PROJECT TITLE	DRAWING TITLE
		E	01.06.21	The line revised to reflect displacement of "light" of ornate access. Open space & area around it has been removed from plot 10.	FR	-	B	31.01.21	- PLOT 10,156&160 FEU LINES AMENDED - OPEN SPACE ADJACENT PLOT 156 REMOVED	AM	-	Details are warranted that this is a working drawing, and is not intended to be treated as descriptive material describing, in relation to any particular property or development, any of the specified features prescribed by law. Other matter used to show the location of the boundaries of the drawings may be subject to change after any time alterations & variations can occur during the progress of the works without further notice. Consequently the Award, Lic, contract & other related documents may be altered either mutually from those shown. Note on the contents of this drawing constitutes a contract, and any work performed is in accordance with the same.	DARNLEY 3	DPA PLAN
	10.03.23			NEW SPEC BOUNDARY REMOVED	RF	-								
H	27.01.23			EXISTING SUBSTATION SHOWN ACCESS SHOWN TO BE USED BY SUBSTATIONS	RF	-								
C	28.03.22		D	20.02.21		HO	RD	03.02.21	PLOT 52 & 63 FEU LINES AMENDED	BY	CHK			
								REV	DATE	DESCRIPTION				FOR INFORMATION ONLY