

DO NOT SCALE DRAWINGS

Suitable arisings from excavations provide useful engineering material for raising levels and in forming and contouring areas of landscaping. Accordingly, the finished surface levels on this development have been designed to incorporate the benefit of this material, either derived on this site, or on other GWUK developments.


NOTICE TO HOUSE - PURCHASERS

Buyers are warned that this is a working drawing & is not intended to be treated as descriptive material describing, in relation to any particular property or development, any of the specified matters prescribed by any order made under the above Act. The drawings are intended to provide a general impression of the proposed development & variations can occur during the progress of the works without revision of the drawing. Consequently the layout, form, content & dimensions of the finished construction may differ materially from those shown. Nor do the contents of this drawing constitute a contract, part of any contract or warranty.

LEGEND

- SHARED DRIVEWAY / FOOTPATH
- OPEN SPACE MAINTAINED BY FACTOR
- SERVICE STRIP OWNED BY ROADS AUTHORITY
- VISIBILITY SPLAY
- SERVICE WAYLEAVE
- PRIVATE PARKING SPACE

Development Plan Approval
-Bishopston H5 Plots 4 to 43, 55 to 60
and 103 to 194 under Title Number
REN131992 & Bishopston H5
(Remainder) Plots 44 to 54 and 61 to
102 under Title Number REN136008
- DPA Approved 17th March 2015

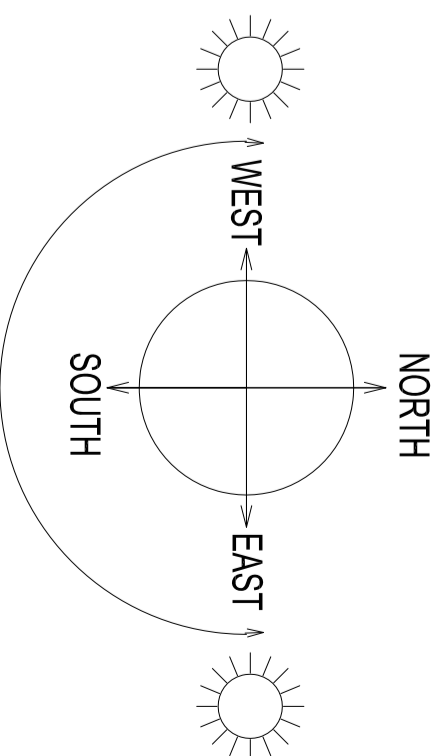

- C 01.11.17 Plots 1, 2, 3, 182, 195, 196 & 197 Title Lines updated to reflect as built road line, Plot 1 moved back towards the rear garden.
- B 06.03.15 Gross title extended to suit new distributor road alignment and plots 195-197 extended accordingly.
- A 22.09.14 Forsyth 2 Tr Changed To Fraser Trk.


REV DATE DESCRIPTION BY

JOB BISHOPTON AREA H5

TITLE MASTER TITLE PLAN

SCALE 1:500 @ A0

Taylor Wimpey West Scotland
Unit C, Ground Floor, Citrus Building
Glasgow Airport Business Park, PA4 2SL
Telephone 0141 849 5200 Fax 0141 849 5250

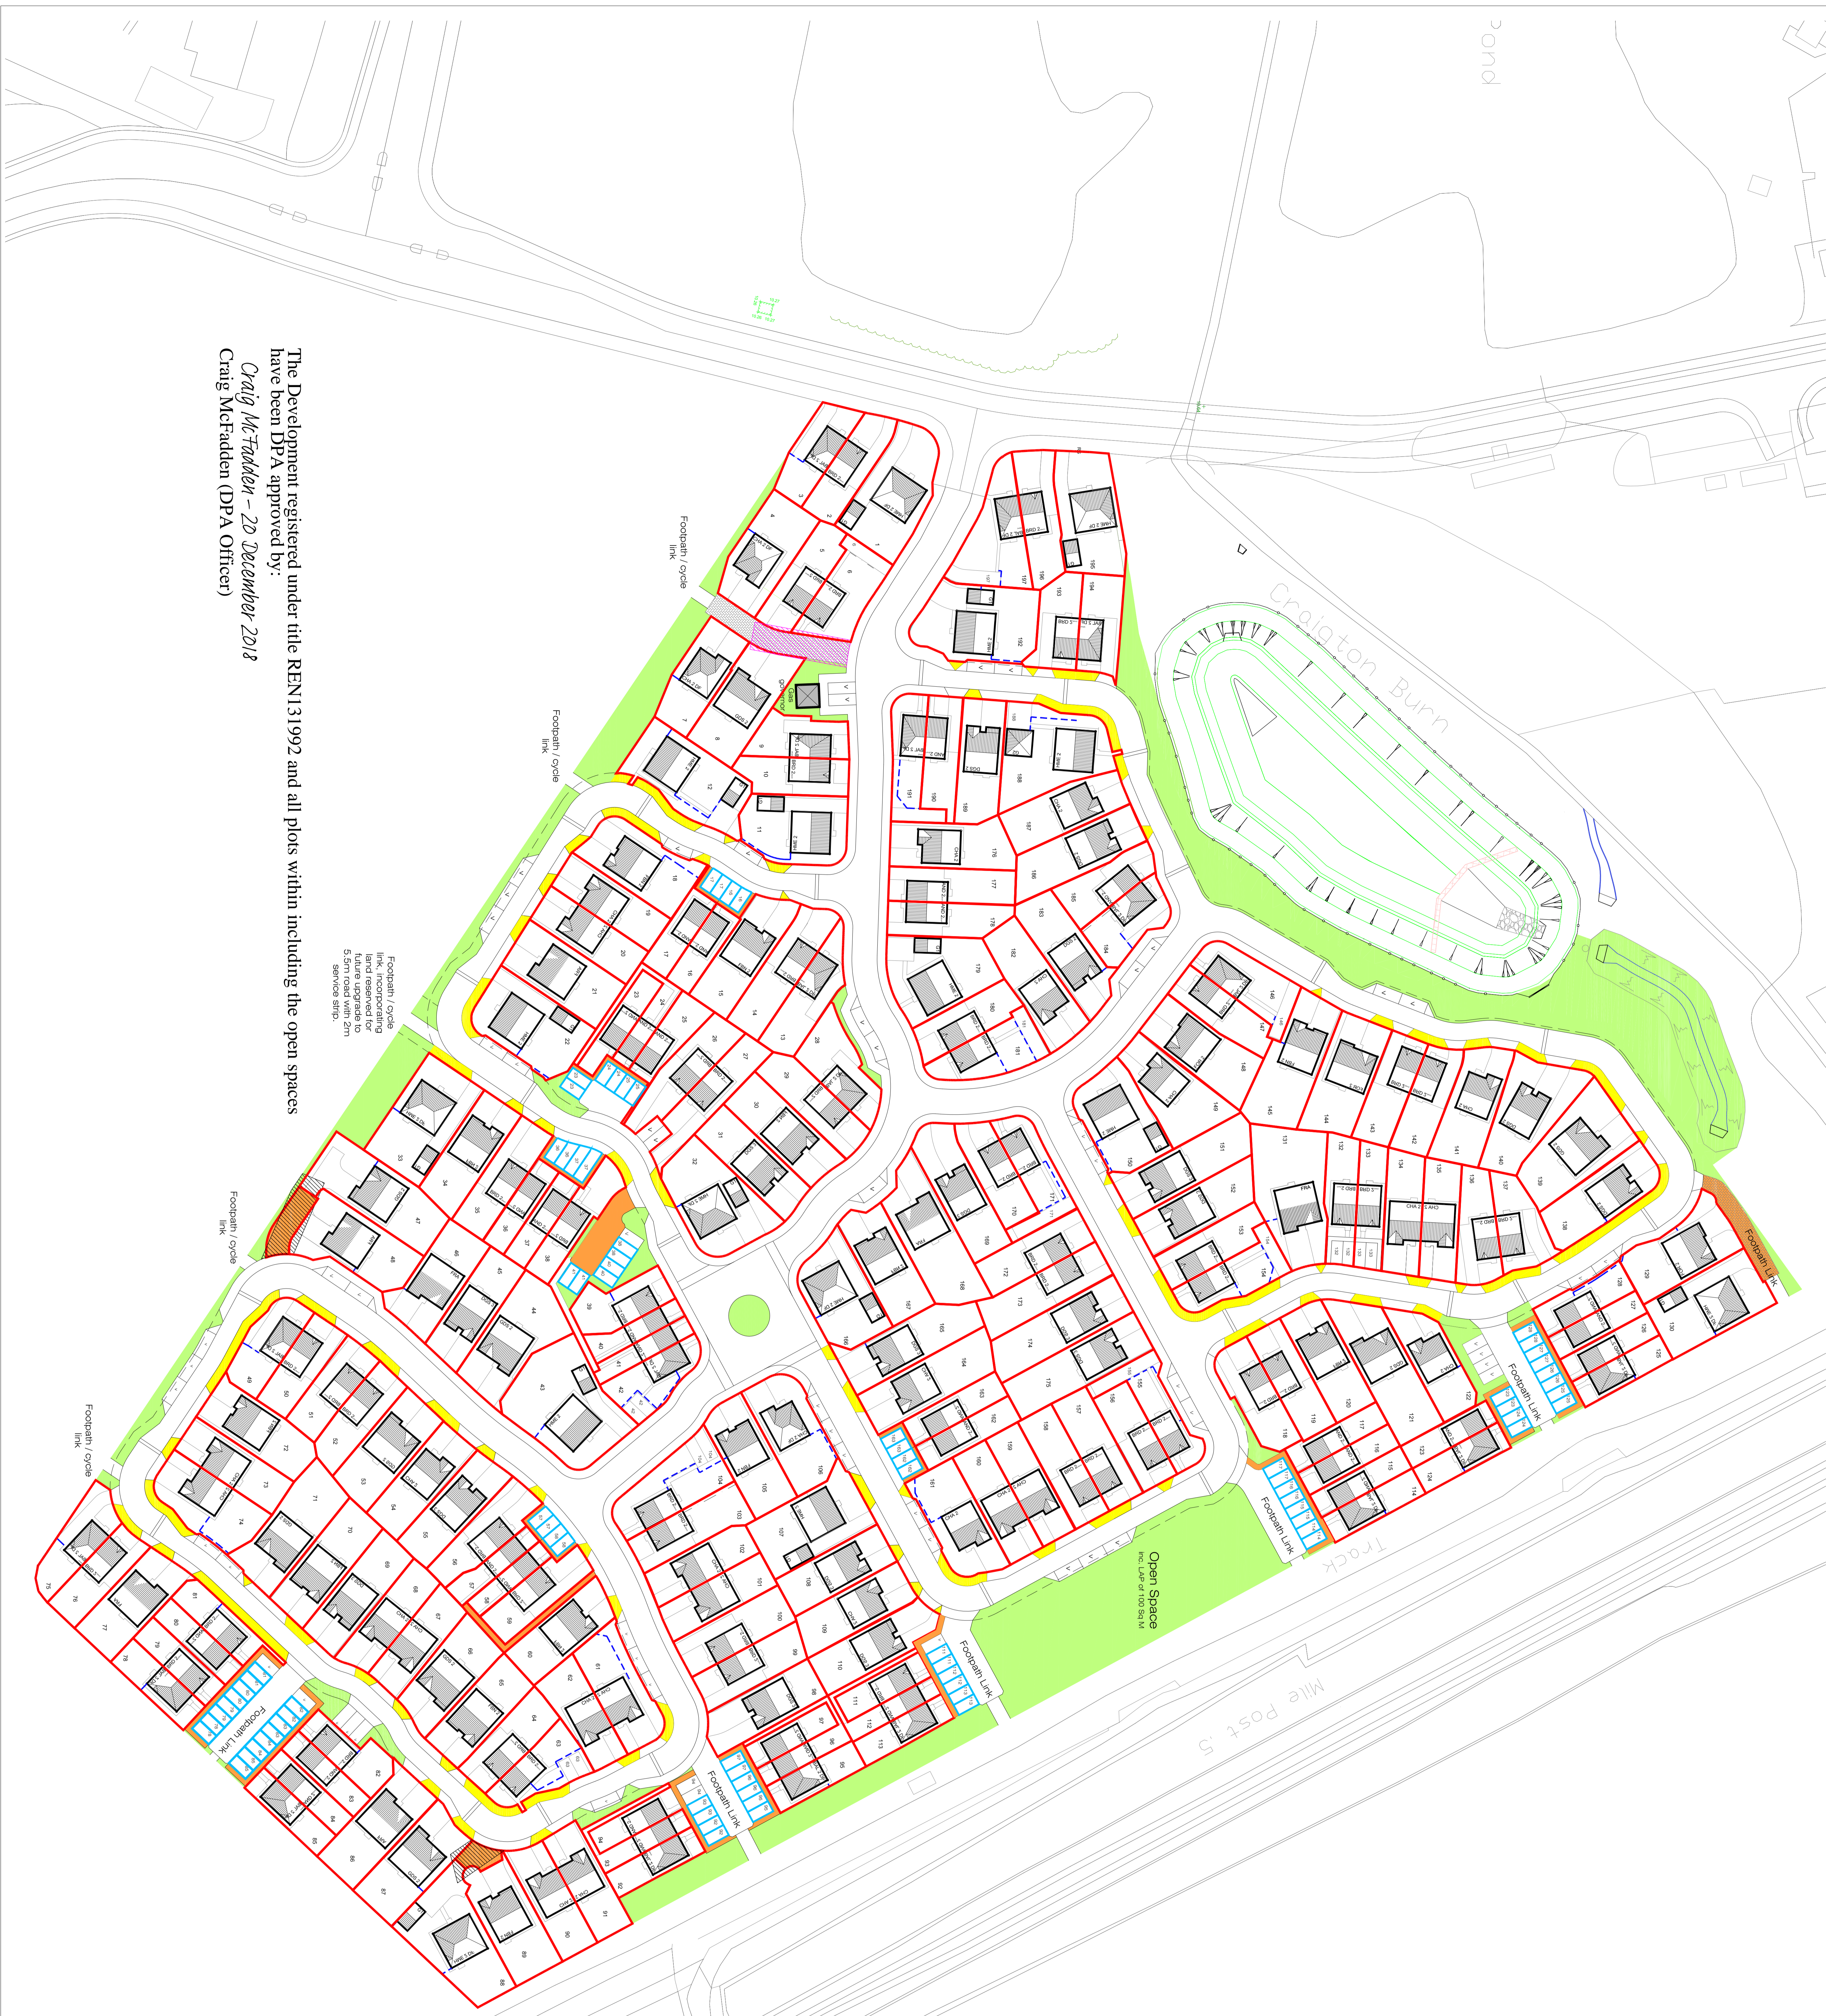

The Development registered under title REN131992 and all plots within including the open spaces have been DPA approved by:
Craig McFadden – 20 December 2018
Craig McFadden (DPA Officer)