


NOTES:  
 1. THIS DRAWING IS COPYRIGHT  
 2. THE CONTRACTOR AND HIS SUBCONTRACTOR  
 ARE TO VERIFY ALL DIMENSIONS ON SITE  
 PRIOR TO MAKING SHOP DRAWINGS OR  
 COMMENCING MANUFACTURE.  
 3. DO NOT SCALE THIS DRAWING.  
 THE CONTRACTOR IS TO BRING TO THE  
 NOTICE OF THE ENGINEER ANY  
 DISCREPANCIES CONTAINED IN THIS DRAWING  
 PRIOR TO WORK COMMENCEMENT.

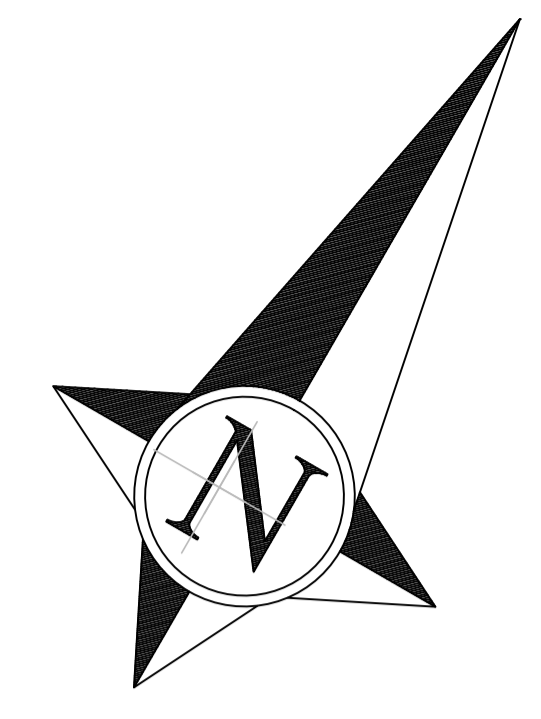

- Legend**
- Overall Site Area
  - Individual Plot Boundary
  - Denotes area of shared surface carriageway adopted by EDC
  - Denotes soft landscaped service strip to be adopted by EDC
  - Denotes area of filter trench verge servitude right of access to be provided to EDC
  - Denotes Public Play Area proposed for common maintenance
  - Denotes driveway shared between Plots 6 & 7 for common maintenance
  - Denotes area of open space proposed for common maintenance
  - Denotes Parking area shared between Plots 17 - 20 for common maintenance
  - Denotes footpath area shared between Plots 17 - 20 for common maintenance
  - Denotes footpath shared between Plots 18 - 20 for common maintenance
  - Denotes surface water storage structures to be adopted by Scottish water
  - Denotes Existing Water Main Wayleave
  - Denotes area outwith deed of conditions
  - Denotes Gas servitude
  - Denotes possible future access to adjacent land

REV	DESCRIPTION	DRWN	CHKD	DATE
J	Plot 5 Boundary altered	PK		17.05.2018
I	Generally revised	SJG		15.05.2018
H	Open Space area added, plot 16	SJG		23.04.2018
G	Gas Governor layout revised	SJG		19.04.2018
F	Gas Governor layout revised	SJG		18.04.2018
E	Open Space added at Gas Governor	SJG		08.04.2018
D	Minor Revisions	SJG		04.04.2018
C	As built, Gas Governor added	SJG		26.02.2018
B	Gas Governor added	SJG		20.02.2018
A	Gate Boundary of Plots 2/3 revised	SJG		14.11.2017

**T. LAWRIE & PARTNERS**  
 CONSULTING ENGINEERS  
 T.Lawrie & Partners Limited.  
 Erskine House, 1 North Avenue  
 Clydebank Business Park, Clydebank G81 2DR  
 Tel: 0141 952 5700 Fax: 0141 952 3666  
 E-mail: admin@tlawrie.com

**DAWN**  
 HOMES LIMITED  
 220 West George Street Glasgow G2 2PG  
 Tel: 0141-285-6700, Fax: 0141-285-6767  
 e-mail: homes@down-group.co.uk

PROJECT TITLE  
**PROPOSED RESIDENTIAL DEVELOPMENT  
 CAMPSIE ROAD  
 TORRANCE**

DRAWING TITLE  
**DEED OF CONDITIONS**

DRAWN BY SJG	CHECKED BY	DATE
SCALE 1:250	CREATION DATE 24.10.17	
DRAWING NUMBER 2376-29	REVISION J	
HARD DISK FILE REFERENCE 2376-29-10.dwg		

The Development registered under Title STG77065 and Plots 1 to 20 (inclusive) within have been DPA approved by:  
*I MacLaren - 22 May 2018*  
 Iain MacLaren (DPA Officer)