

THIS DRAWING IS COPYRIGHT ©.  
 ORDNANCE SURVEY CROWN COPYRIGHT ©. ALL RIGHTS RESERVED. LICENCE NUMBER 100020446.  
 DO NOT SCALE FROM THIS DRAWING. USE FIGURED DIMENSIONS ONLY. ALL DIMENSIONS TO BE CHECKED ON SITE BEFORE WORK COMMENCES. DISCREPANCIES TO BE REPORTED TO EMA.  
 VARIATIONS AND MODIFICATIONS TO INFORMATION SHOWN ON THIS DRAWING SHALL NOT BE CARRIED OUT WITHOUT PRIOR PERMISSION OF EMA ARCHITECTS, WHO ACCEPT NO LIABILITY FOR ALTERATIONS MADE TO THIS DRAWING BY ANY OTHER PARTY.  
 THIS DRAWING IS TO BE READ IN CONJUNCTION WITH ALL RELEVANT ARCHITECTURAL, STRUCTURAL, SERVICES DRAWINGS AND SPECIFICATIONS.  
 IT IS THE RESPONSIBILITY OF THE CONTRACTOR TO ENSURE THAT ALL MATERIALS USED DURING CONSTRUCTION CARRY A CE MARKING.


REV	DESCRIPTION	DRAWN	CHKD.	DATE
E	SITE BOUNDARY CHANGED TO ORANGE. RED LINE ADDED BETWEEN PLOT 2/3	AMM		14.07.20

PLAN EXTRACT 1:500

The development registered under title LAN213777 and plots 1 to 10 within have been DPA approved by:

*D MacDonald - 15 July 2020*

David MacDonald (DPA Officer)

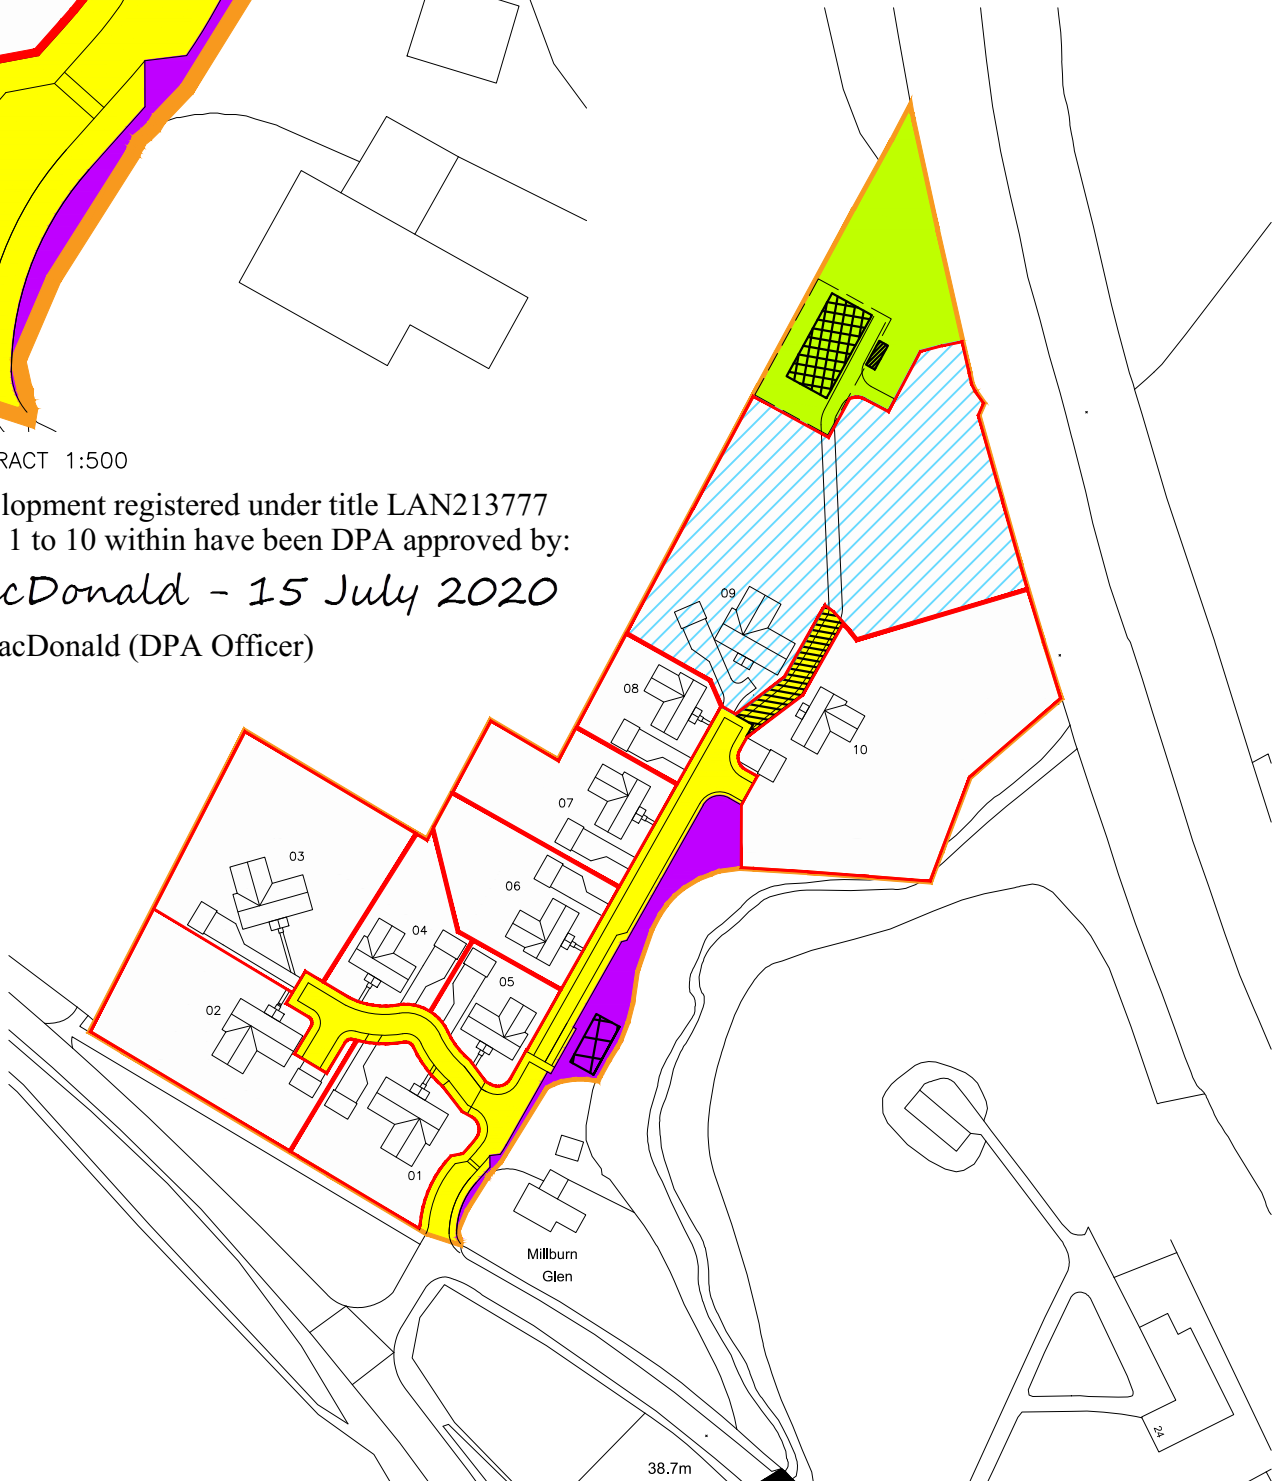

Ordnance Survey, (c) Crown Copyright 2018. All rights reserved. Licence number 100022432

**ema**  
 architects + masterplanners

42 CHARLOTTE SQUARE  
 EDINBURGH  
 EH2 4HQ  
 E INFO@EMA-ARCHITECTS.CO.UK T 0131 247 1450  
 W WWW.EMA-ARCHITECTS.CO.UK

ADVANCE CONSTRUCTION  
 MILLBURN GLEN

DEED OF CONDITIONS PLAN

SCALE/TITLE	DATE/DRAWN	PROJ. TYPE	SHEET NO. / NO. SHEETS
1:2000 / A4	31.10.19 / KGR		1 / 1
DRAWING REFERENCE			
14095(01)200 E			
ISSUE PURPOSE		WORK STAGE	
FILE CLASSIFICATION		FILE REFERENCE	